


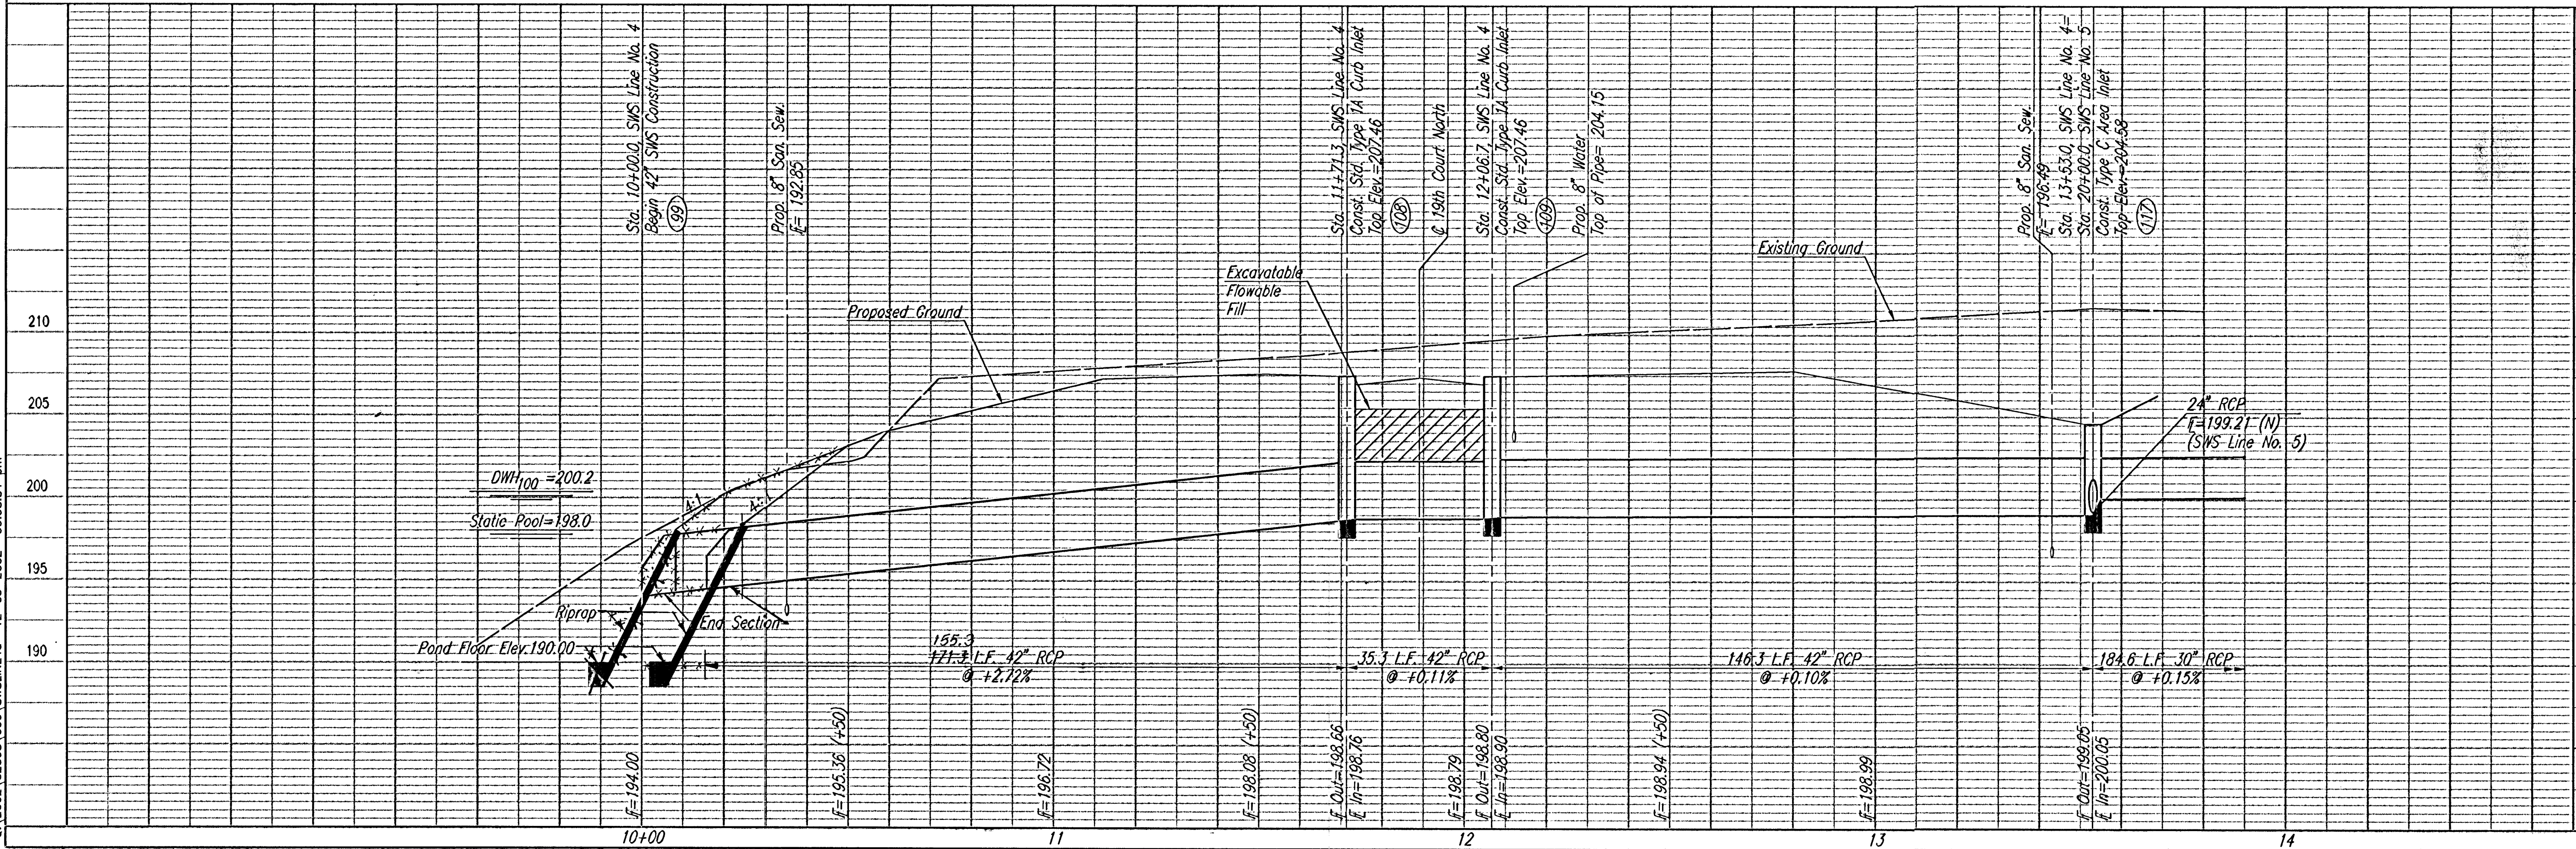

10+16.0
Sta. 10+00.0, SWS Line No. 4=
Begin 42" SWS Construction
Install 35 S.Y. Light Stone Riprap
(Including End Section)
E Out= 194.00

CAUTION !!!
Prop. 8" San. Sew.

Install 32.3 L.F.
Excavatable Flowable
Fill to Elev. 205.46

CAUTION !!!
Prop. 8" Waterline

109
Sta. 12+06.7, SWS Line No. 4=
19th Court North Sta. 53+27.0, 17.67' Lt.
Const. Std. Type 1A Curb Inlet
L=5'-0", W=3'-0"
Top Elev.=207.46
Install 146.3 L.F. 42" RCP (E)
See Sh. Nos. 27, 33

Sta. 13+53.0, SWS Line No. 4=
Sta. 20+00.0, SWS Line No. 5
Const. Type C Area Inlet
L=6'-0", W=5'-0"
Top Elev.=204.58
Install 184.6 L.F. 30" RCP (S)
Install 100.2 L.F. 24" RCP (N)
See Sh. Nos. 29, 31 & 32

CAUTION !!!
Prop. 8" San. Sew.

COORDINATE LIST		
POINT	NORTH	EAST
99	385,430.3083	2,370,558.1305
108	385,432.1759	2,370,728.1597
109	385,432.5642	2,370,763.4976
117	385,434.1721	2,370,909.8188

(117) = COORDINATE POINT NO.

SCALE: 1"=20'

RECORD DRAWING
B. J. E. 24 NOV 03