

SCALE: 1"=20'


COORDINATE LIST		
POINT	NORTH	EAST
116	385,534.3314	2,370,908.7181
117	385,434.1721	2,370,909.8188

(116) = COORDINATE POINT NO.

RECORD DRAWING

Frank E. ... 24 NOV 03

SWS LINE NO. 5

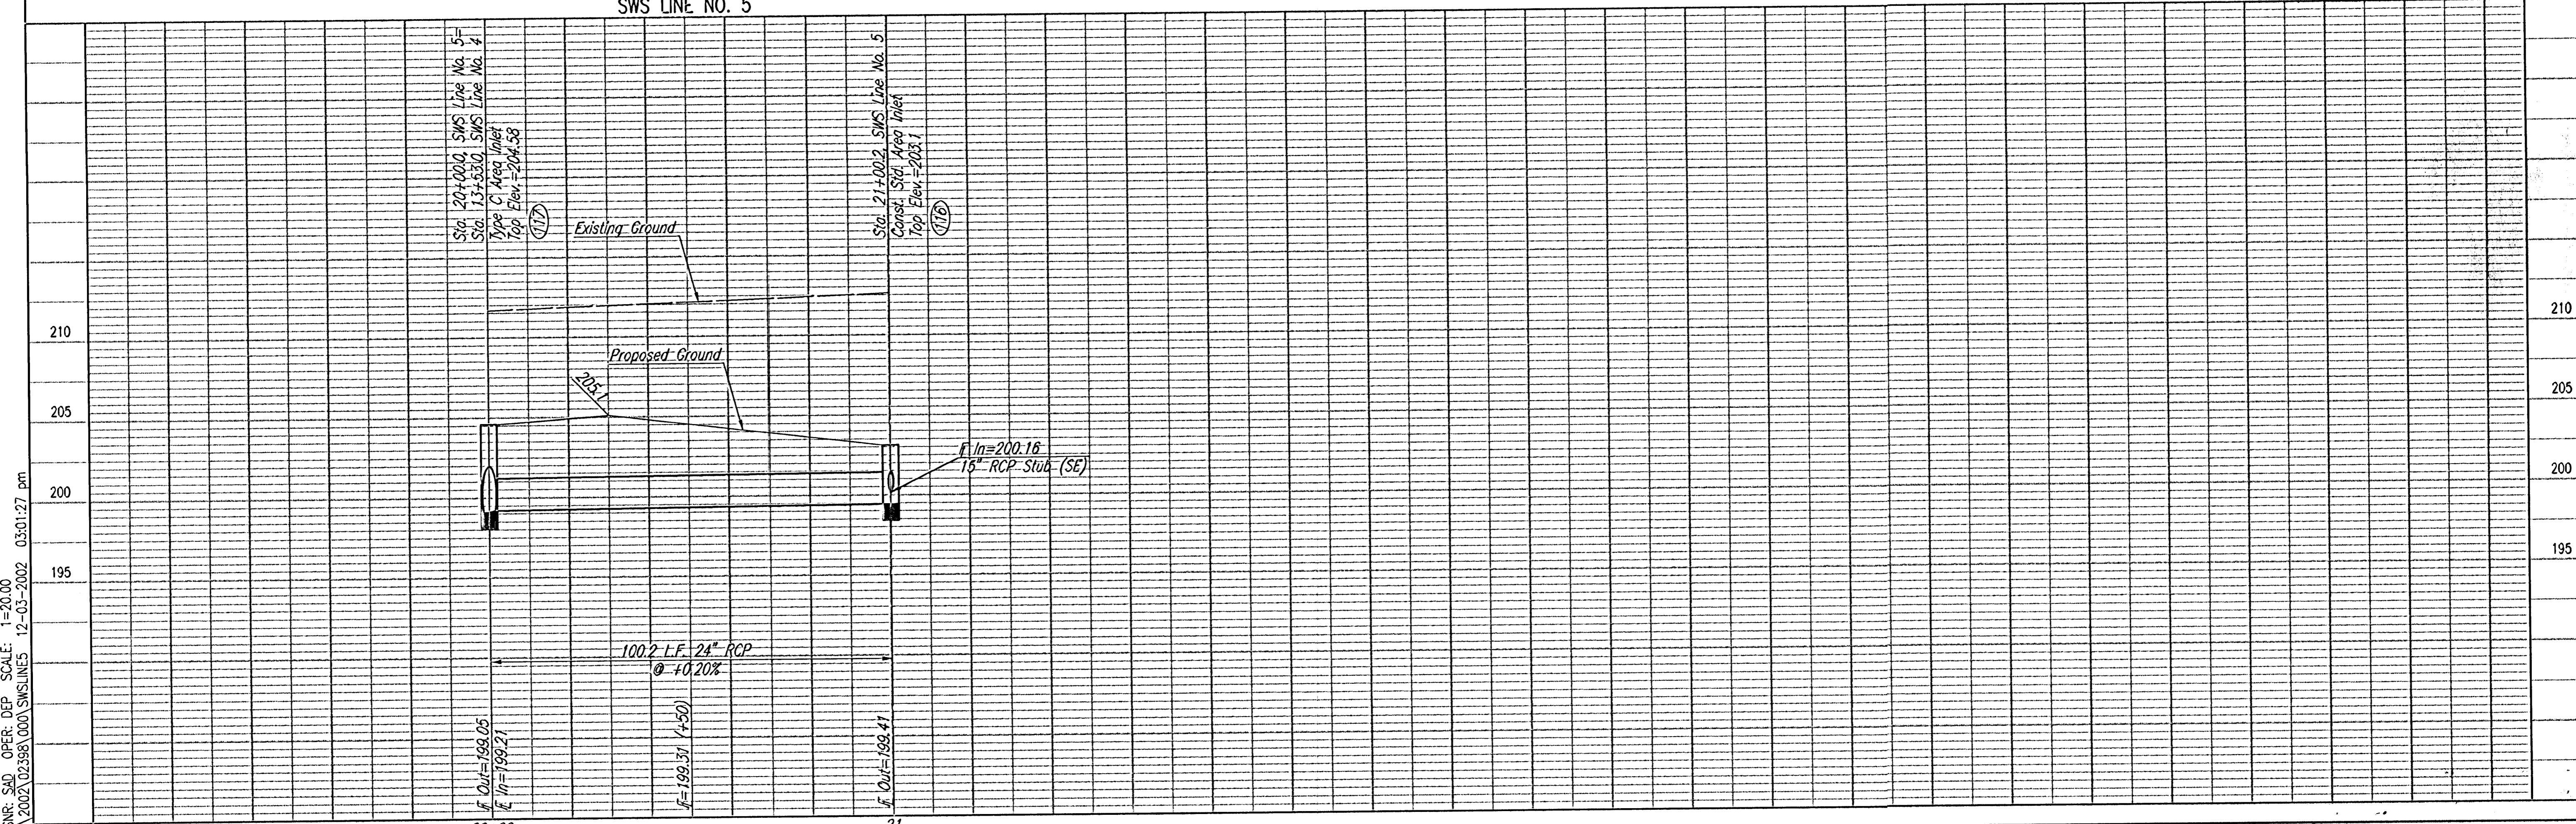

DSWR, S&D OPER: DEP SCALE: 1"=20.00
 01/2002/02398/000/SWSLINES 12-03-2002 03:01:27 pm

REMAINING PAGE - PHASE 2
SWS LINE NO. 5
 STA. 20+00.0 TO 21+00.2
 C.O.M. PROJ. NO. 472-83376

Professional Engineering Consultants, P.A.
 303 S. TOPEKA AVENUE, SUITE 200
 316-262-2891 • FAX 316-262-3083
 Job No. 02388 Date DEC. 2002
 Designed by BER Drawn by SWW
 Sheet 28 of 50