


NOTE BOOK TEMPLATE	AREAS	CHECKED
NO.		

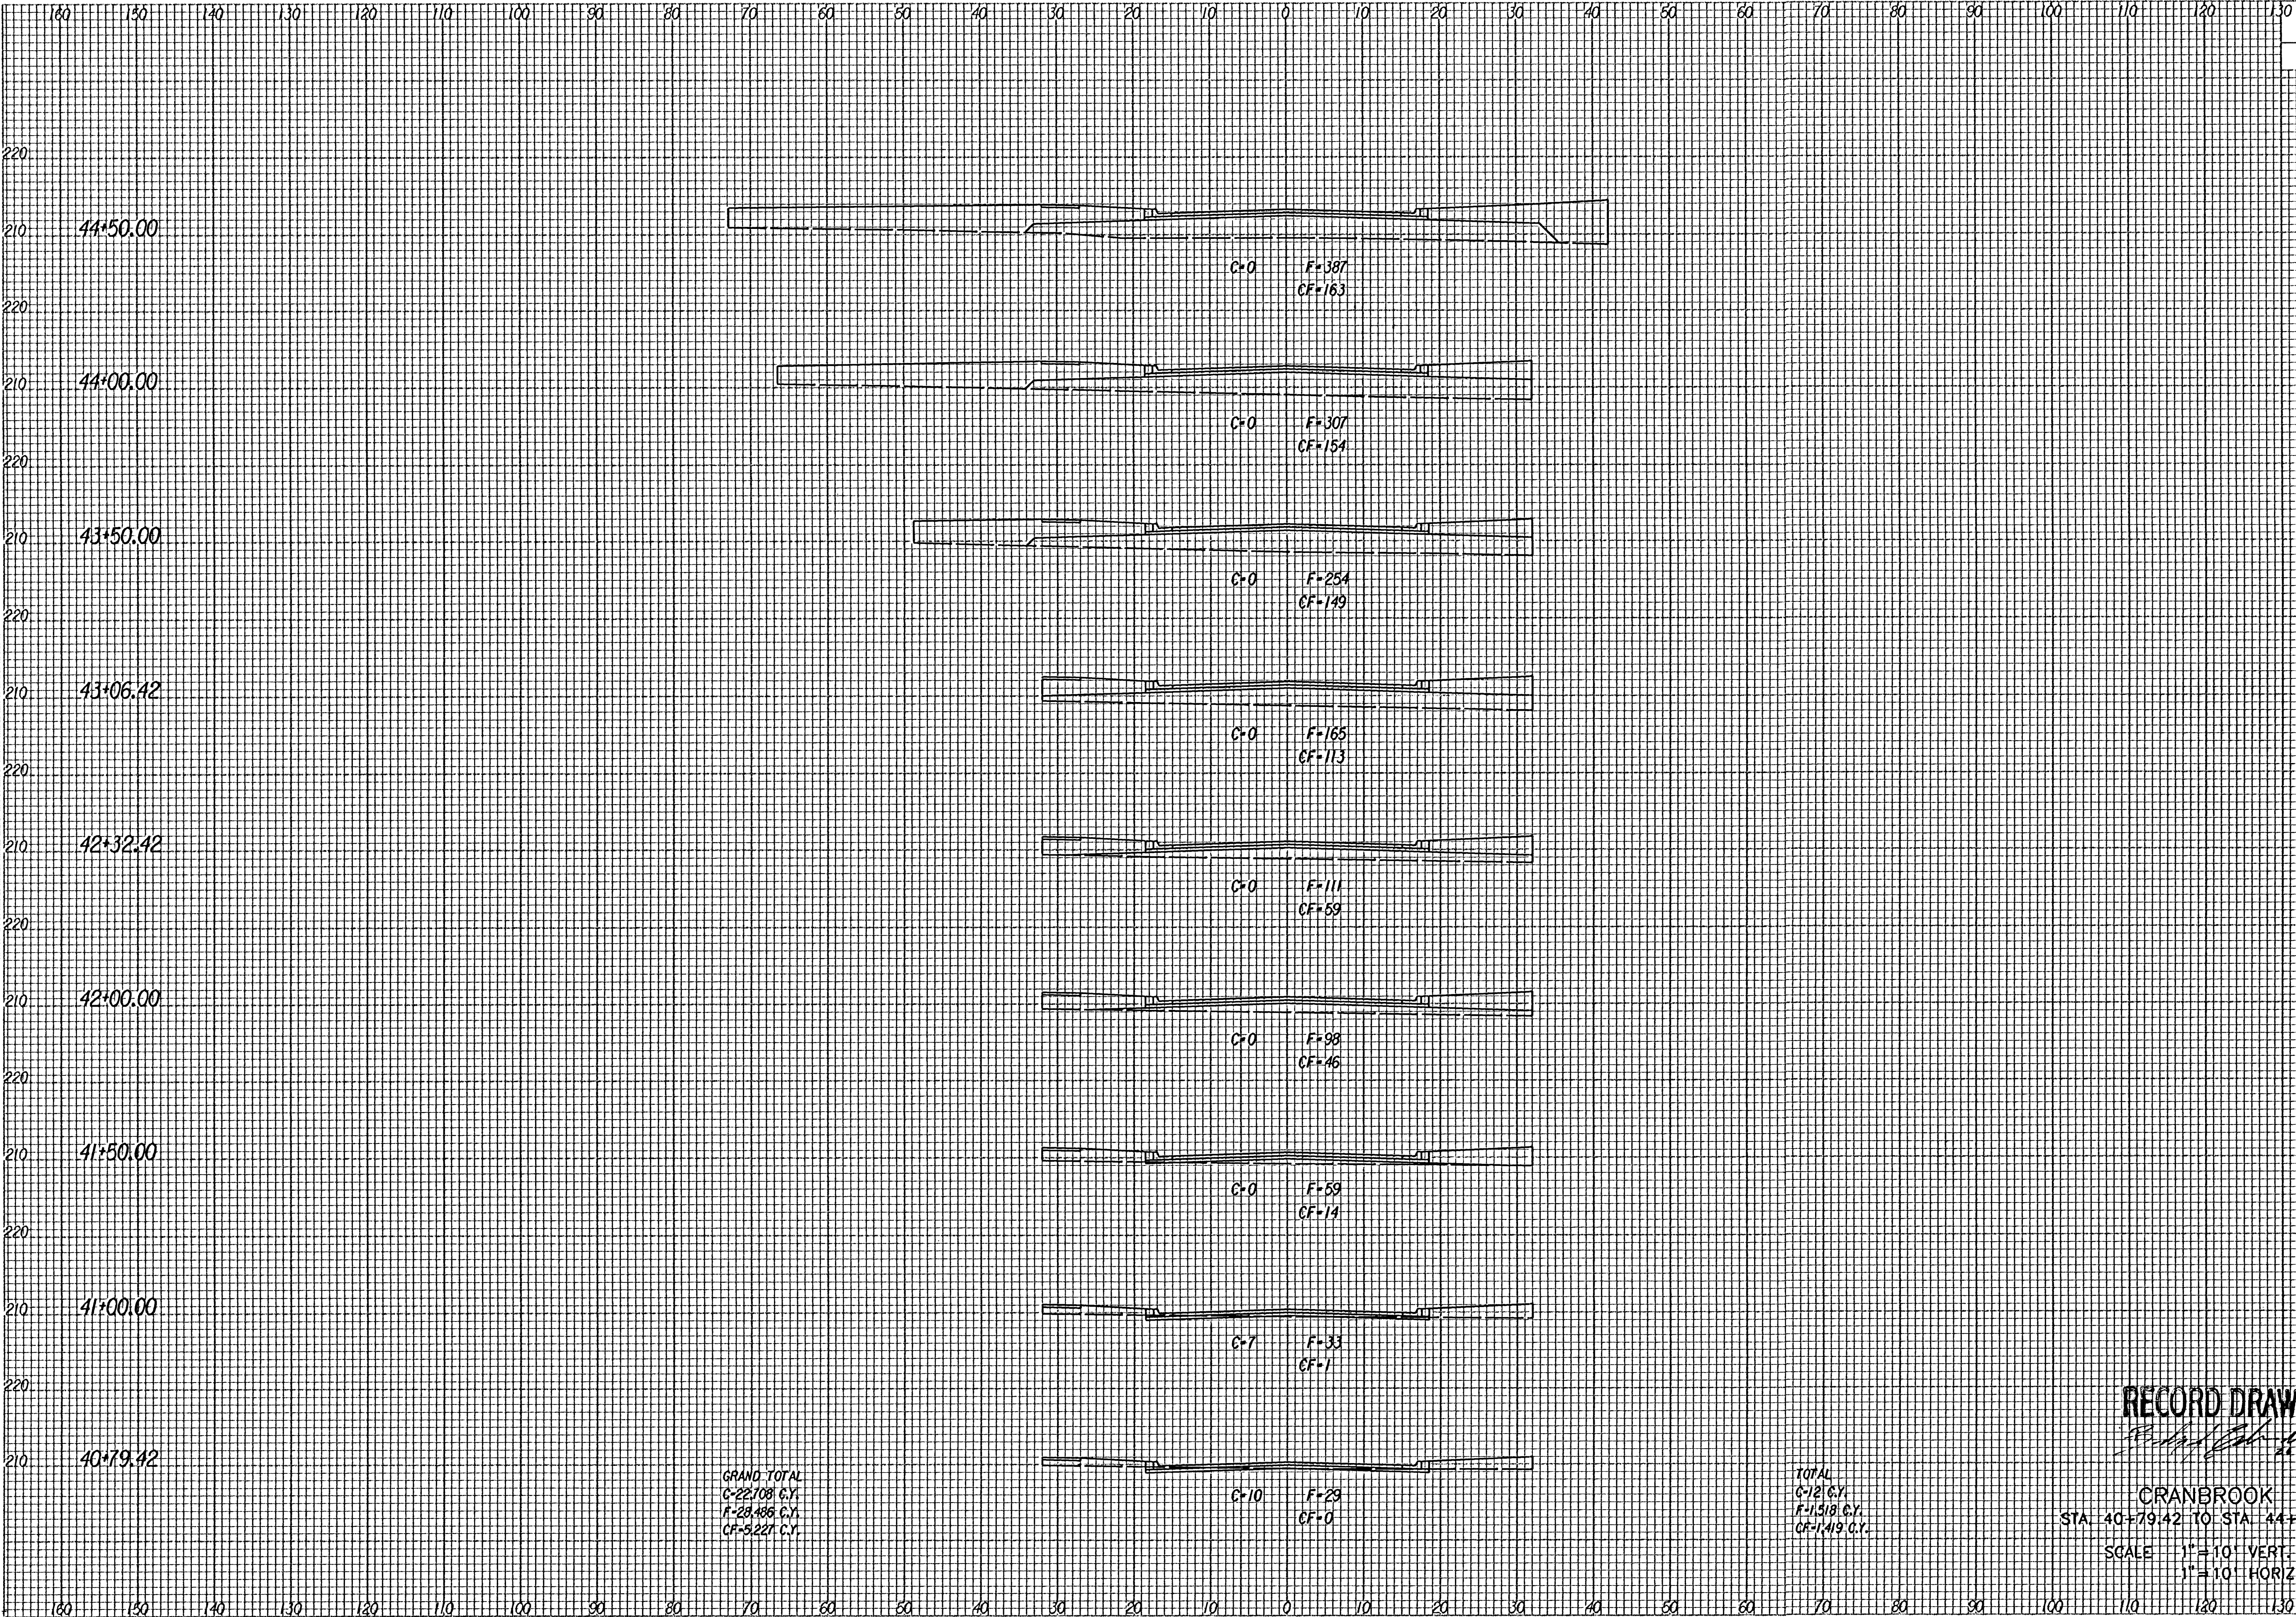

GRAND TOTAL
C=22708 C.Y.
F=28,186 C.Y.
CF=5,227 C.Y.

TOTAL
C=12 C.Y.
F=1,518 C.Y.
CF=1,419 C.Y.

RECORD DRAWING
[Signature]

CRANBROOK
STA. 40+79.42 TO STA. 44+50.00
SCALE 1"=10' VERT.
1"=10' HORIZ

PROJECT NO.	SHEET NO.	TOTAL SHEETS
472-83376	36	50

C=0 F=414 CF=264	220
44+50.00	210
C=0 F=349 CF=294	220
44+00.00	210
C=0 F=239 CF=281	220
43+50.00	210
C=0 F=127 CF=211	220
43+06.42	210
C=0 F=143 CF=236	220
42+32.42	210
C=0 F=62 CF=63	220
42+00.00	210
C=0 F=90 CF=56	220
41+50.00	210
C=0 F=71 CF=14	220
41+00.00	210
C=0 F=23 CF=0	220
40+79.42	210