


NOTE BOOK TEMPLATE	AREAS	CHECKED
NO.		

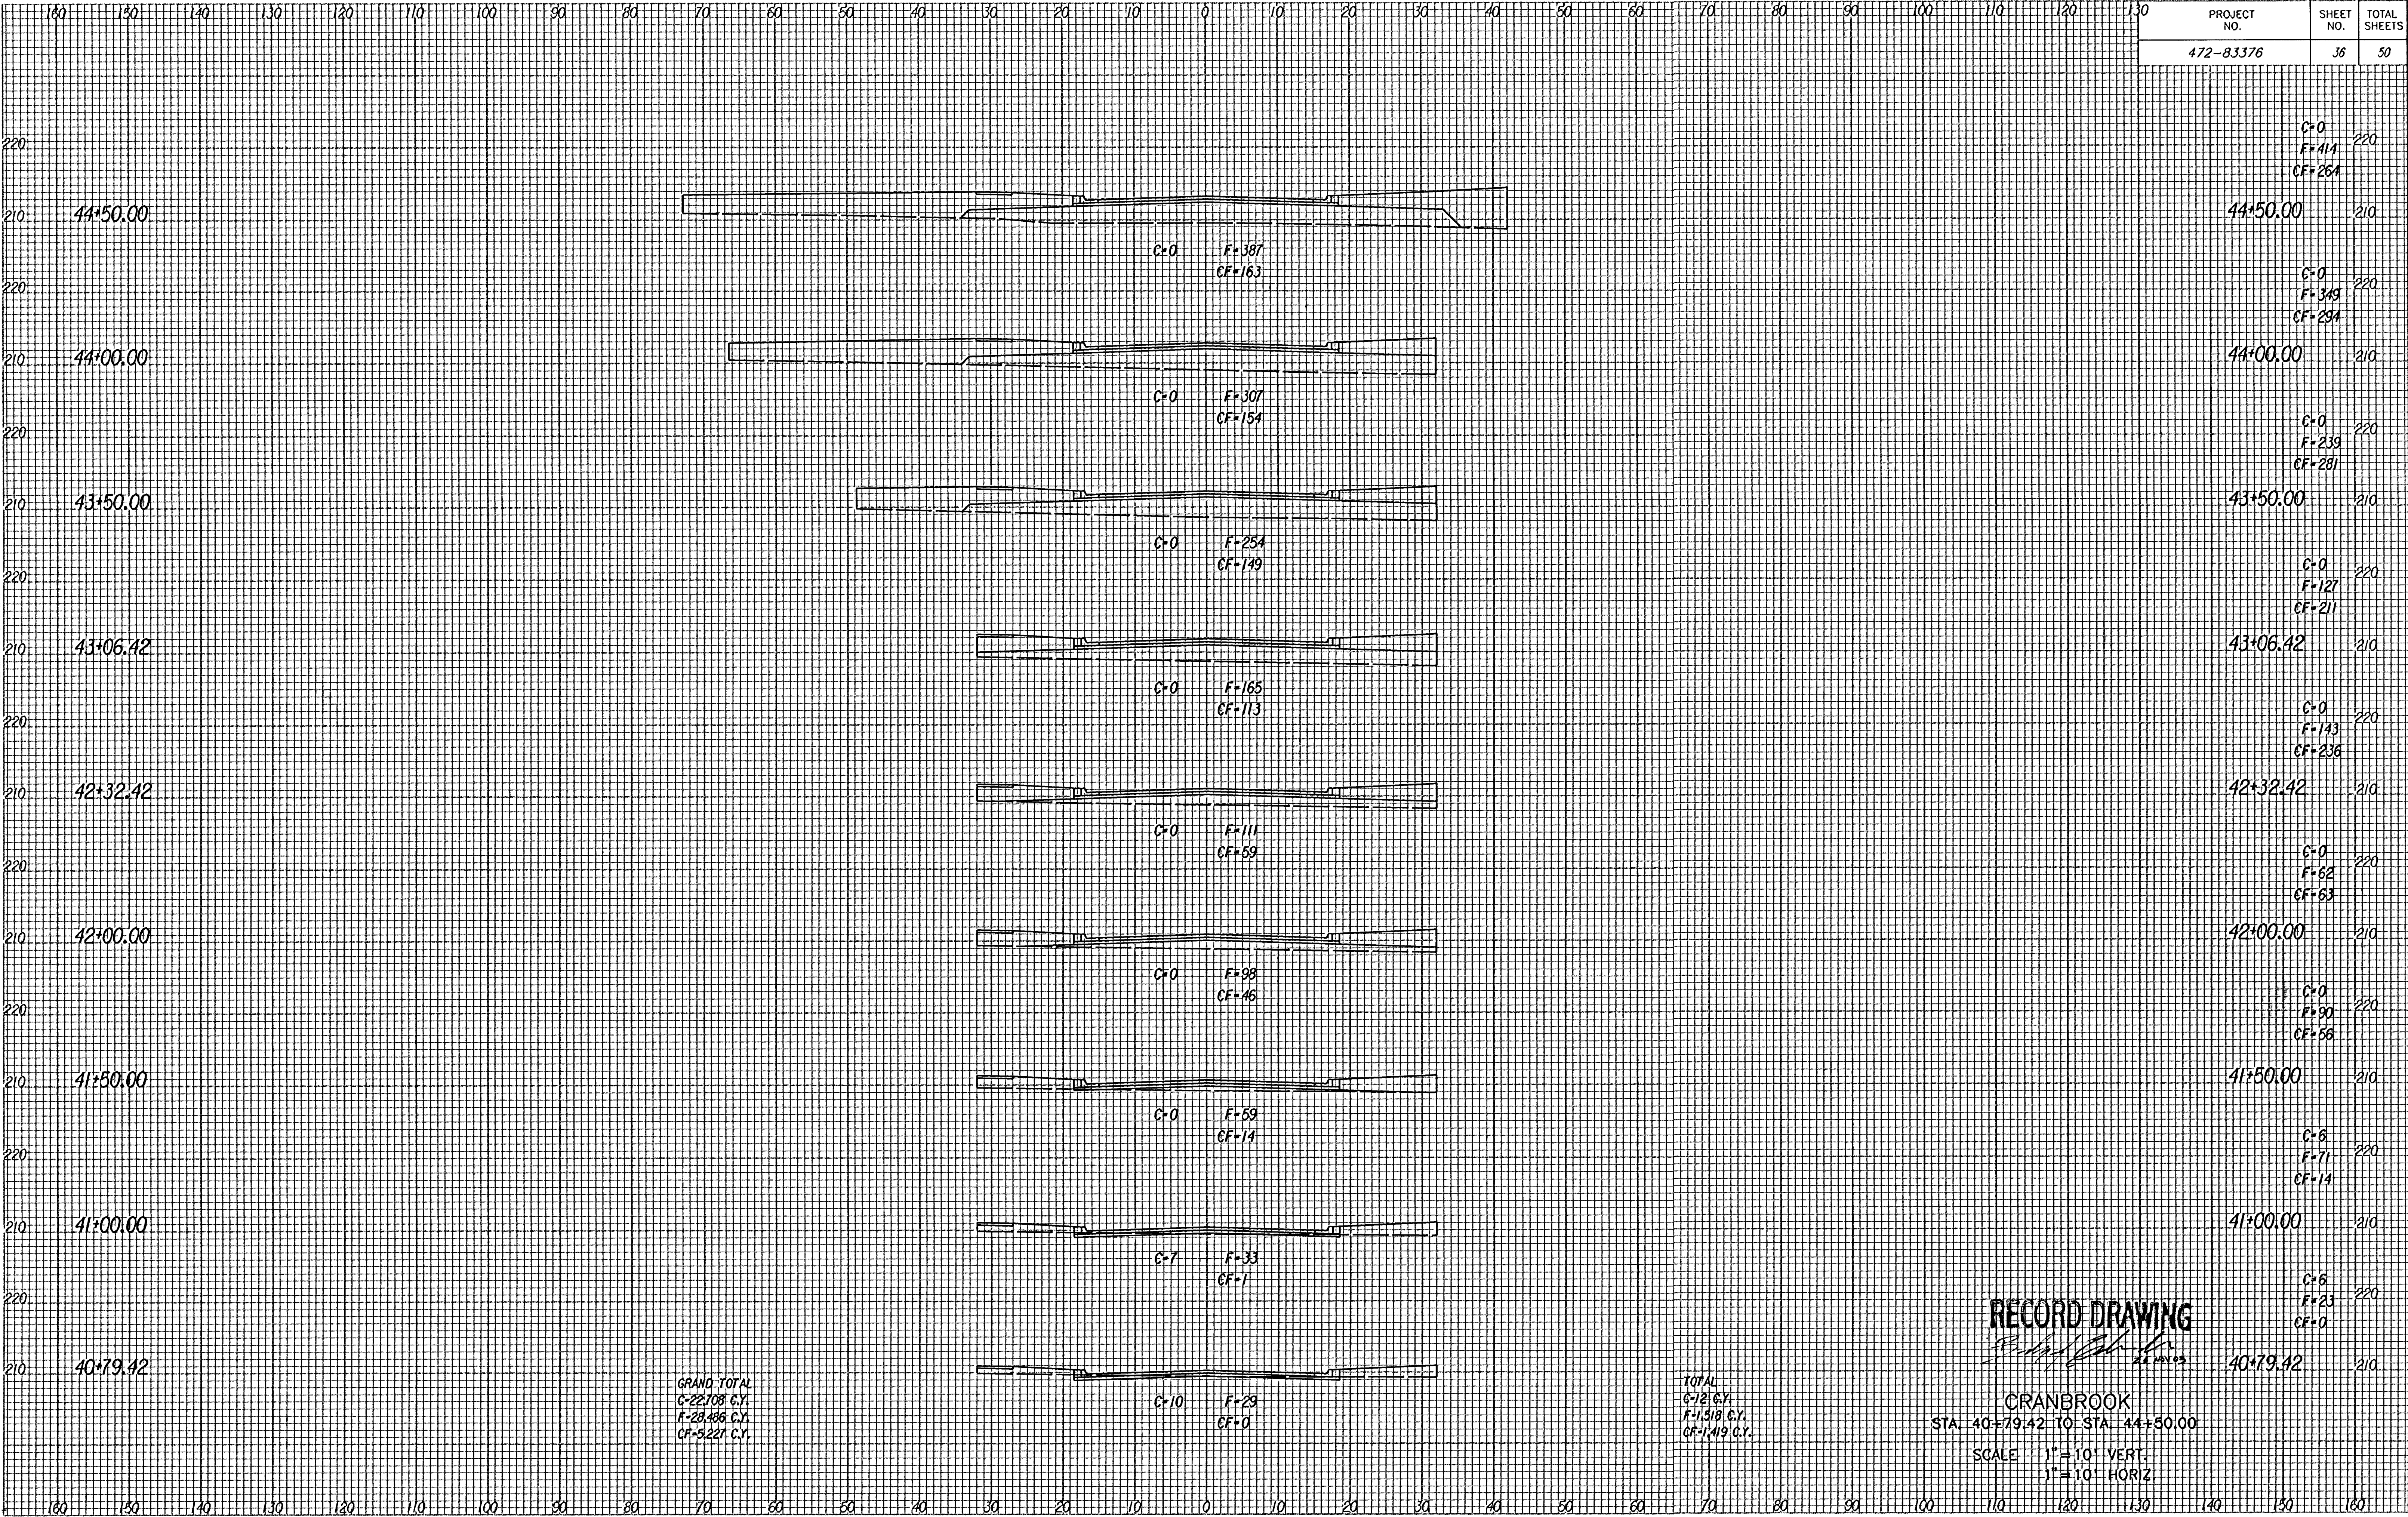

PROJECT NO.	SHEET NO.	TOTAL SHEETS
472-83376	36	50

RECORD DRAWING
[Signature]
CRANBROOK
STA. 40+79.42 TO STA. 44+50.00
SCALE 1"=10' VERT.
1"=10' HORIZ