


PROJECT NO.	SHEET NO.	TOTAL SHEETS
472-83376	37	50

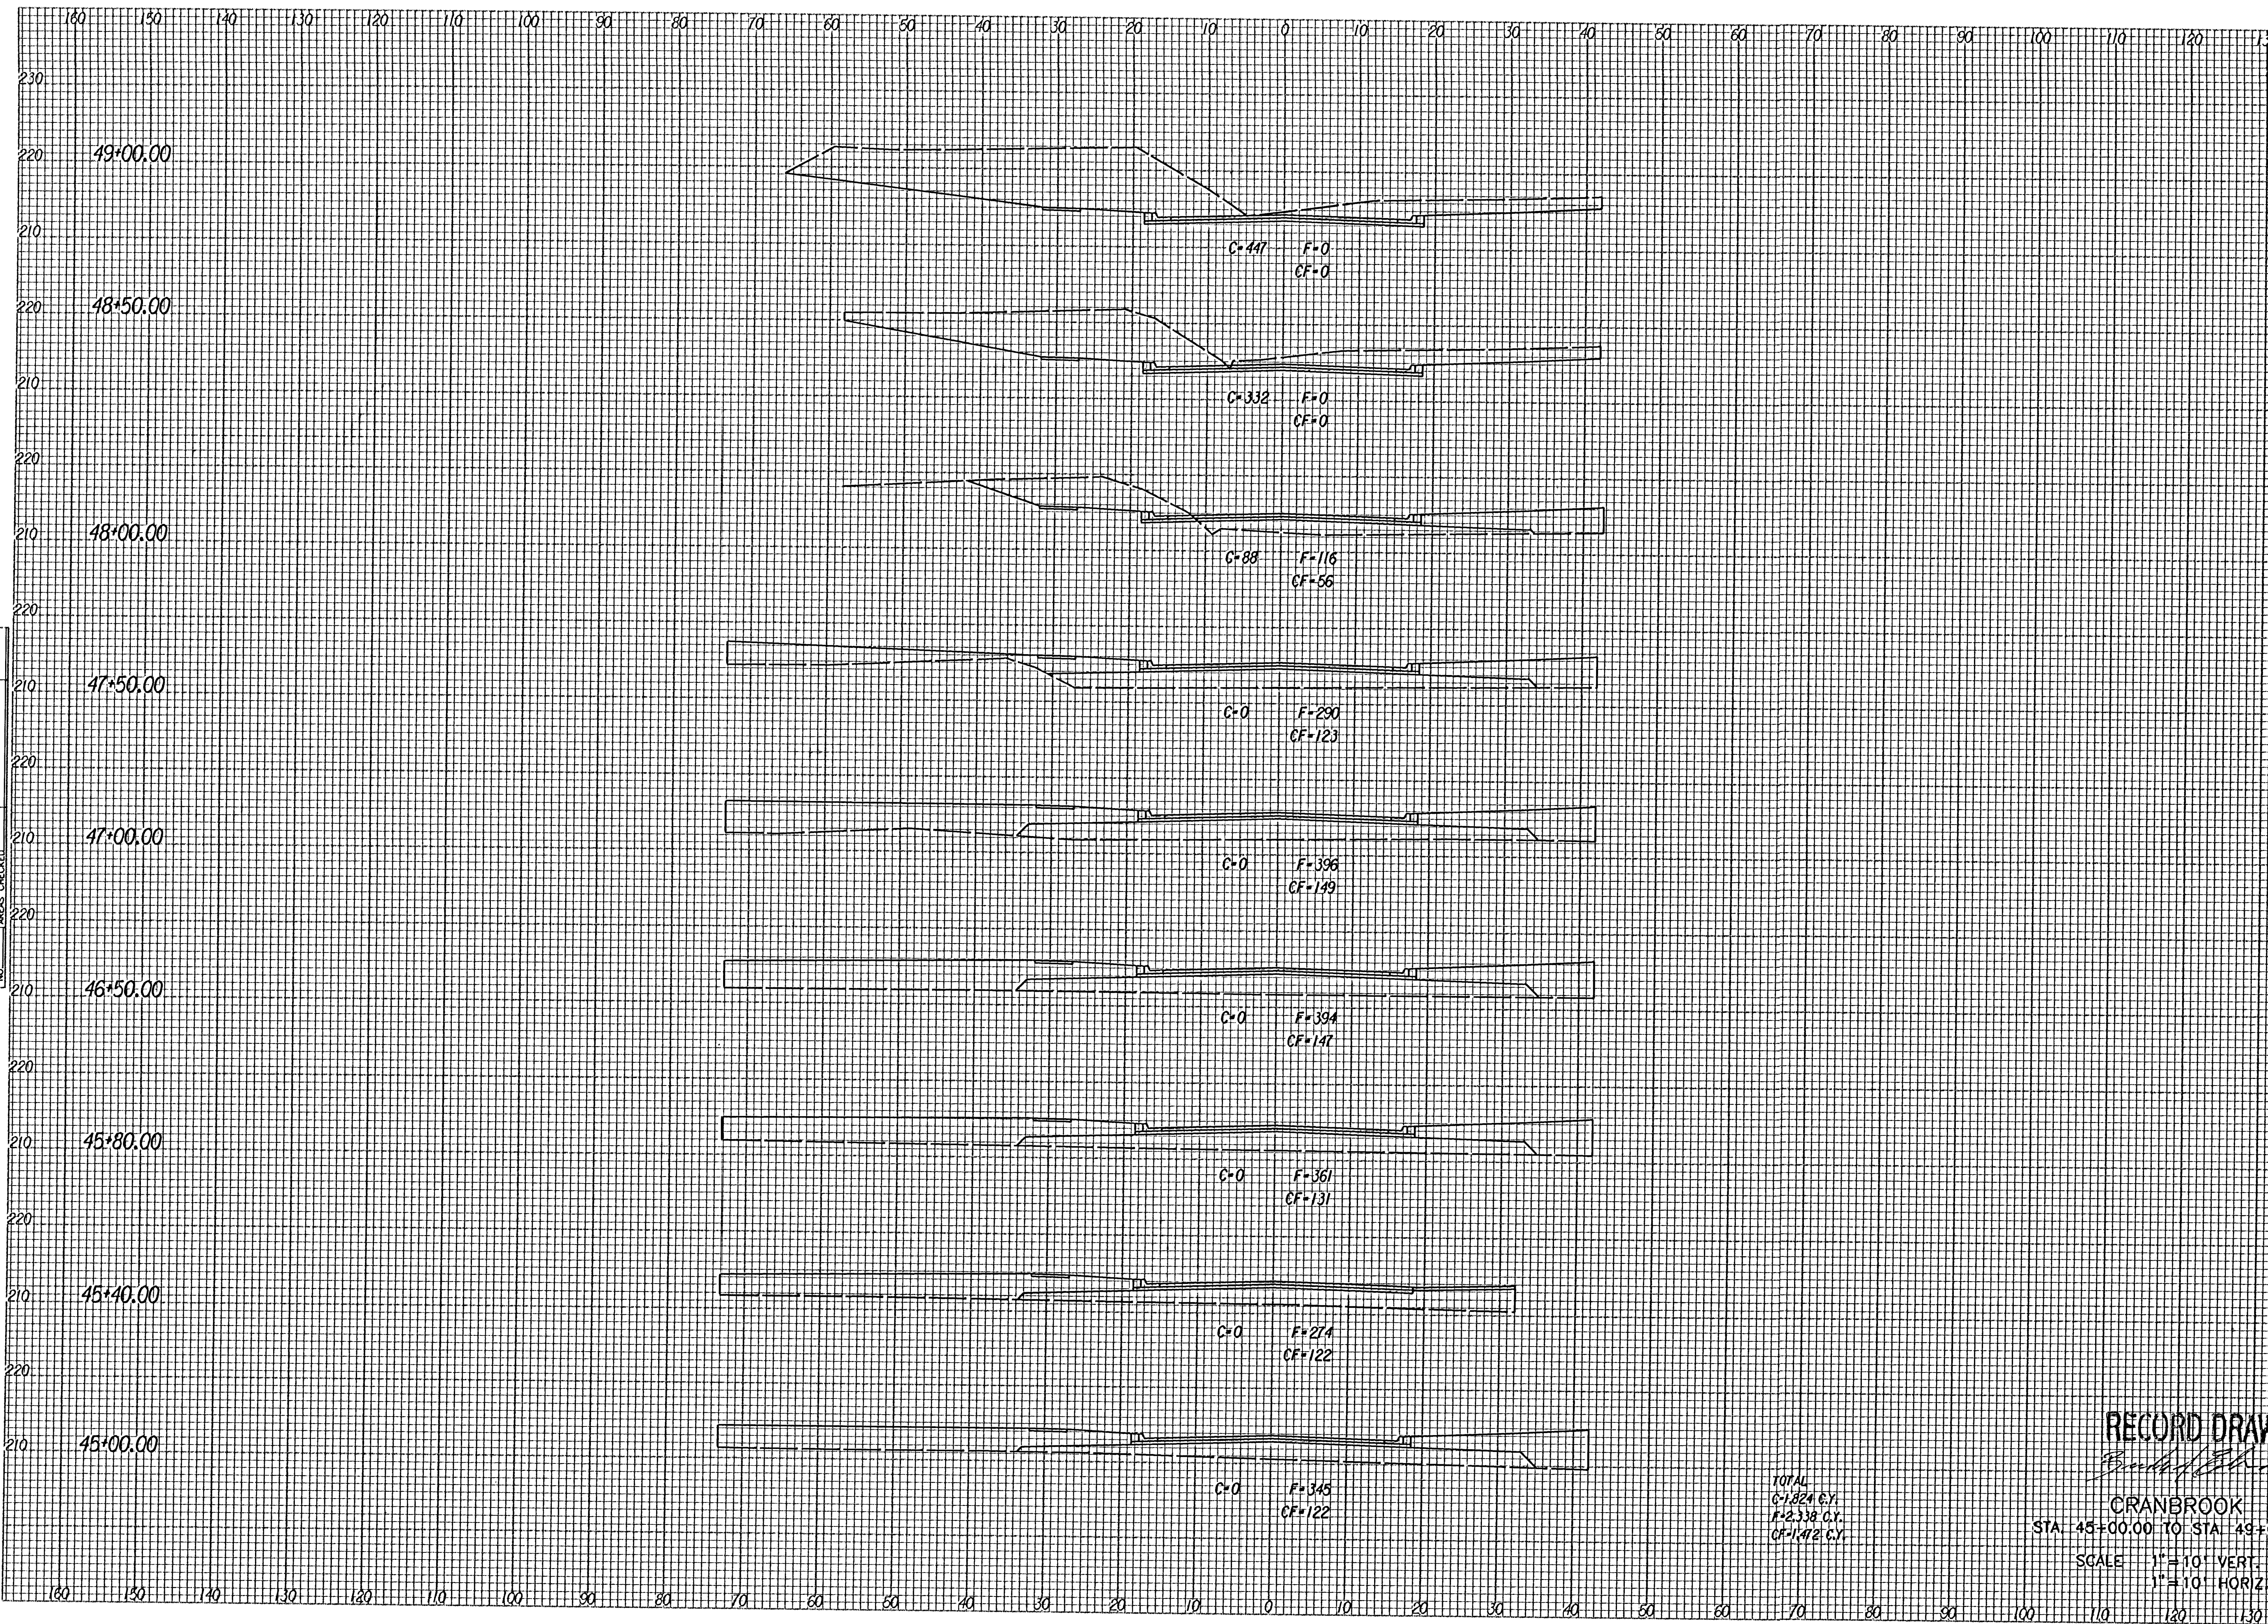

NO.	TEMPLATE AREAS CHECKED

49+00.00	220
48+50.00	210
48+50.00	220
48+00.00	210
48+00.00	220
47+50.00	210
47+50.00	220
47+00.00	210
47+00.00	220
46+50.00	210
46+50.00	220
45+80.00	210
45+80.00	220
45+40.00	210
45+40.00	220
45+00.00	210
45+00.00	220

TOTAL
 C=1824 C.Y.
 F=2338 C.Y.
 CF=1472 C.Y.

RECORD DRAWING

Barbara J. [Signature]

CRANBROOK

STA. 45+00.00 TO STA. 49+00.00

SCALE 1" = 10' VERT.
 1" = 10' HORIZ.