


180 150 140 130 120 110 100 90 80 70 60 50 40 30 20 10 0 10 20 30 40 50 60 70 80 90 100 110 120 130

PROJECT NO.	YEAR	SHEET NO.	TOTAL SHEETS
472-83376		40	50

NOTE BOOK TABULATE AREAS CHECKED.

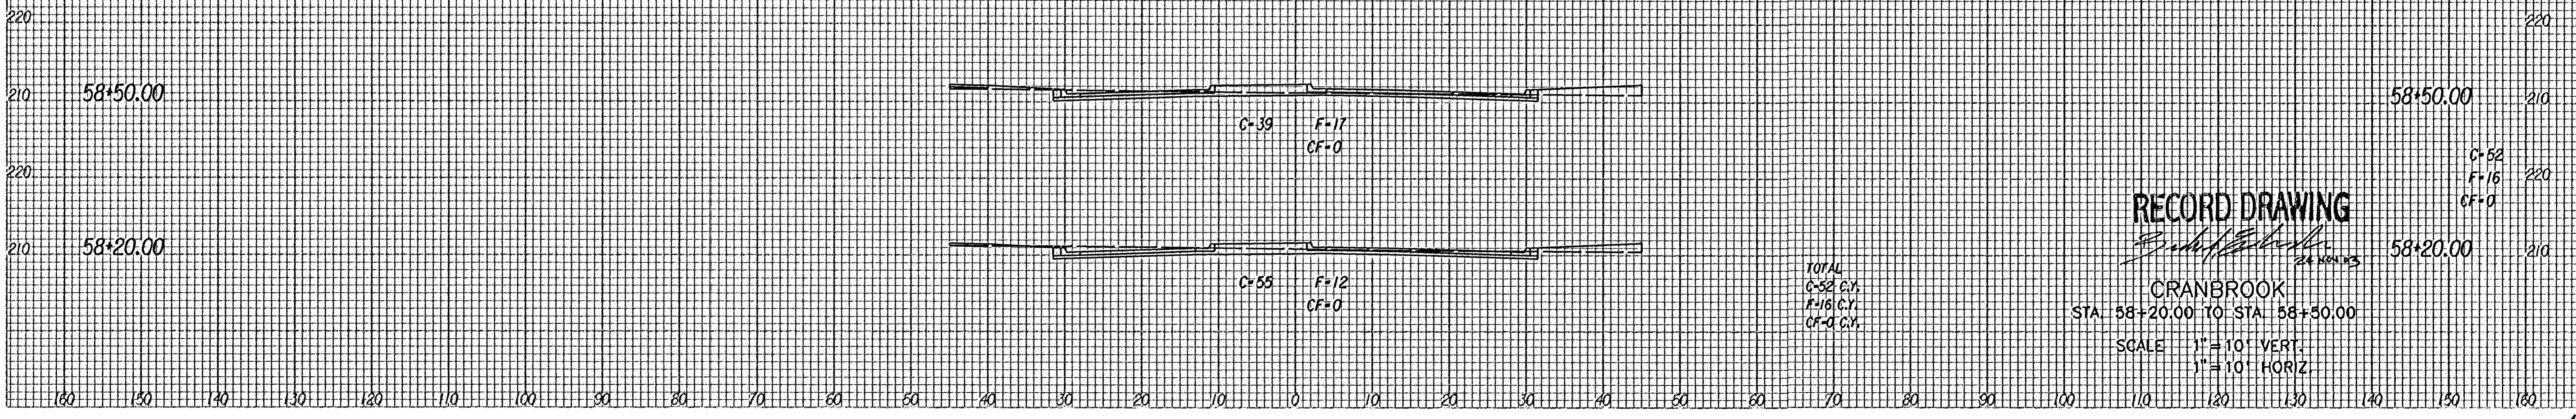

RECORD DRAWING

[Signature]
24 NOV 1953

CRANBROOK

STA. 58+20.00 TO STA. 58+50.00

SCALE 1" = 10' VERT.
1" = 10' HORIZ.

180 150 140 130 120 110 100 90 80 70 60 50 40 30 20 10 0 10 20 30 40 50 60 70 80 90 100 110 120 130 140 150 160