


NOTE BOOK	TEMPLATE	AREAS CHECKED
NO.		

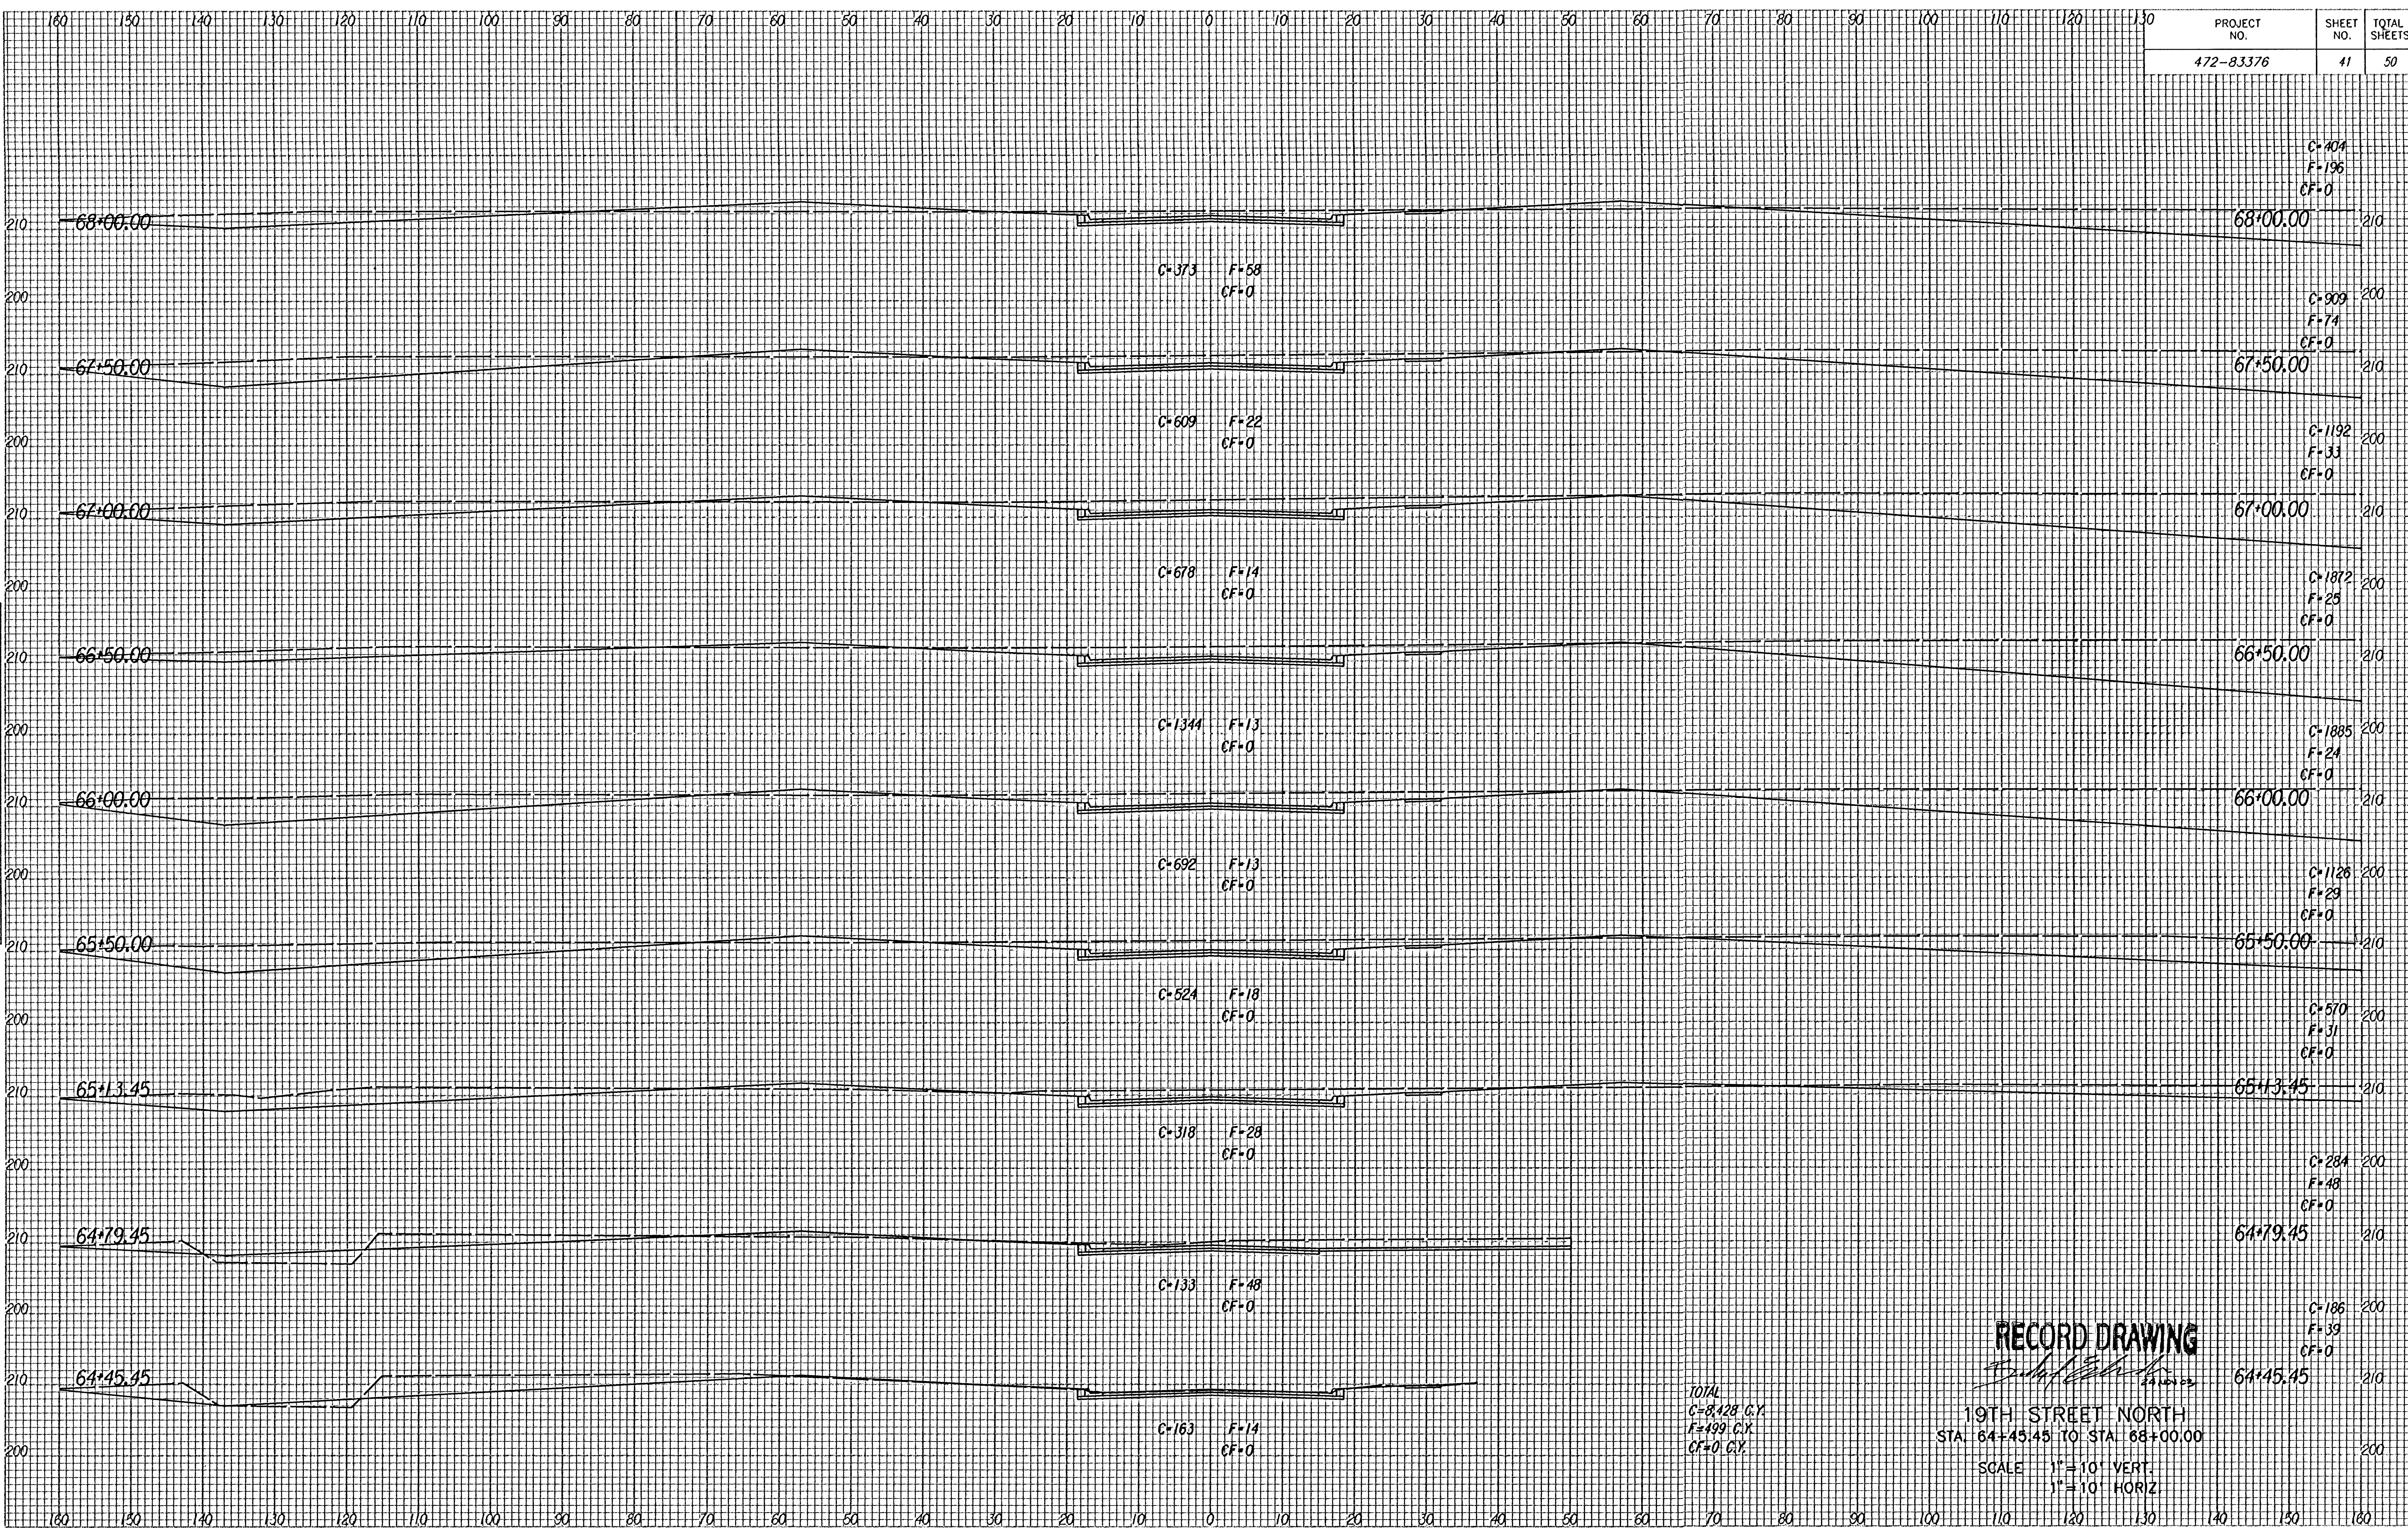

PROJECT NO.	SHEET NO.	TOTAL SHEETS
472-83376	41	50

TOTAL
C=8,428 C.Y.
F=499 C.Y.
CF=0 C.Y.

RECORD DRAWING

19TH STREET NORTH
STA 64+45.45 TO STA 68+00.00

SCALE 1"=10' VERT.
1"=10' HORIZ