


160 150 140 130 120 110 100 90 80 70 60 50 40 30 20 10 0 10 20 30 40 50 60 70 80 90 100 110 120 130

PROJECT NO.	SHEET NO.	TOTAL SHEETS
472-83376	43	50

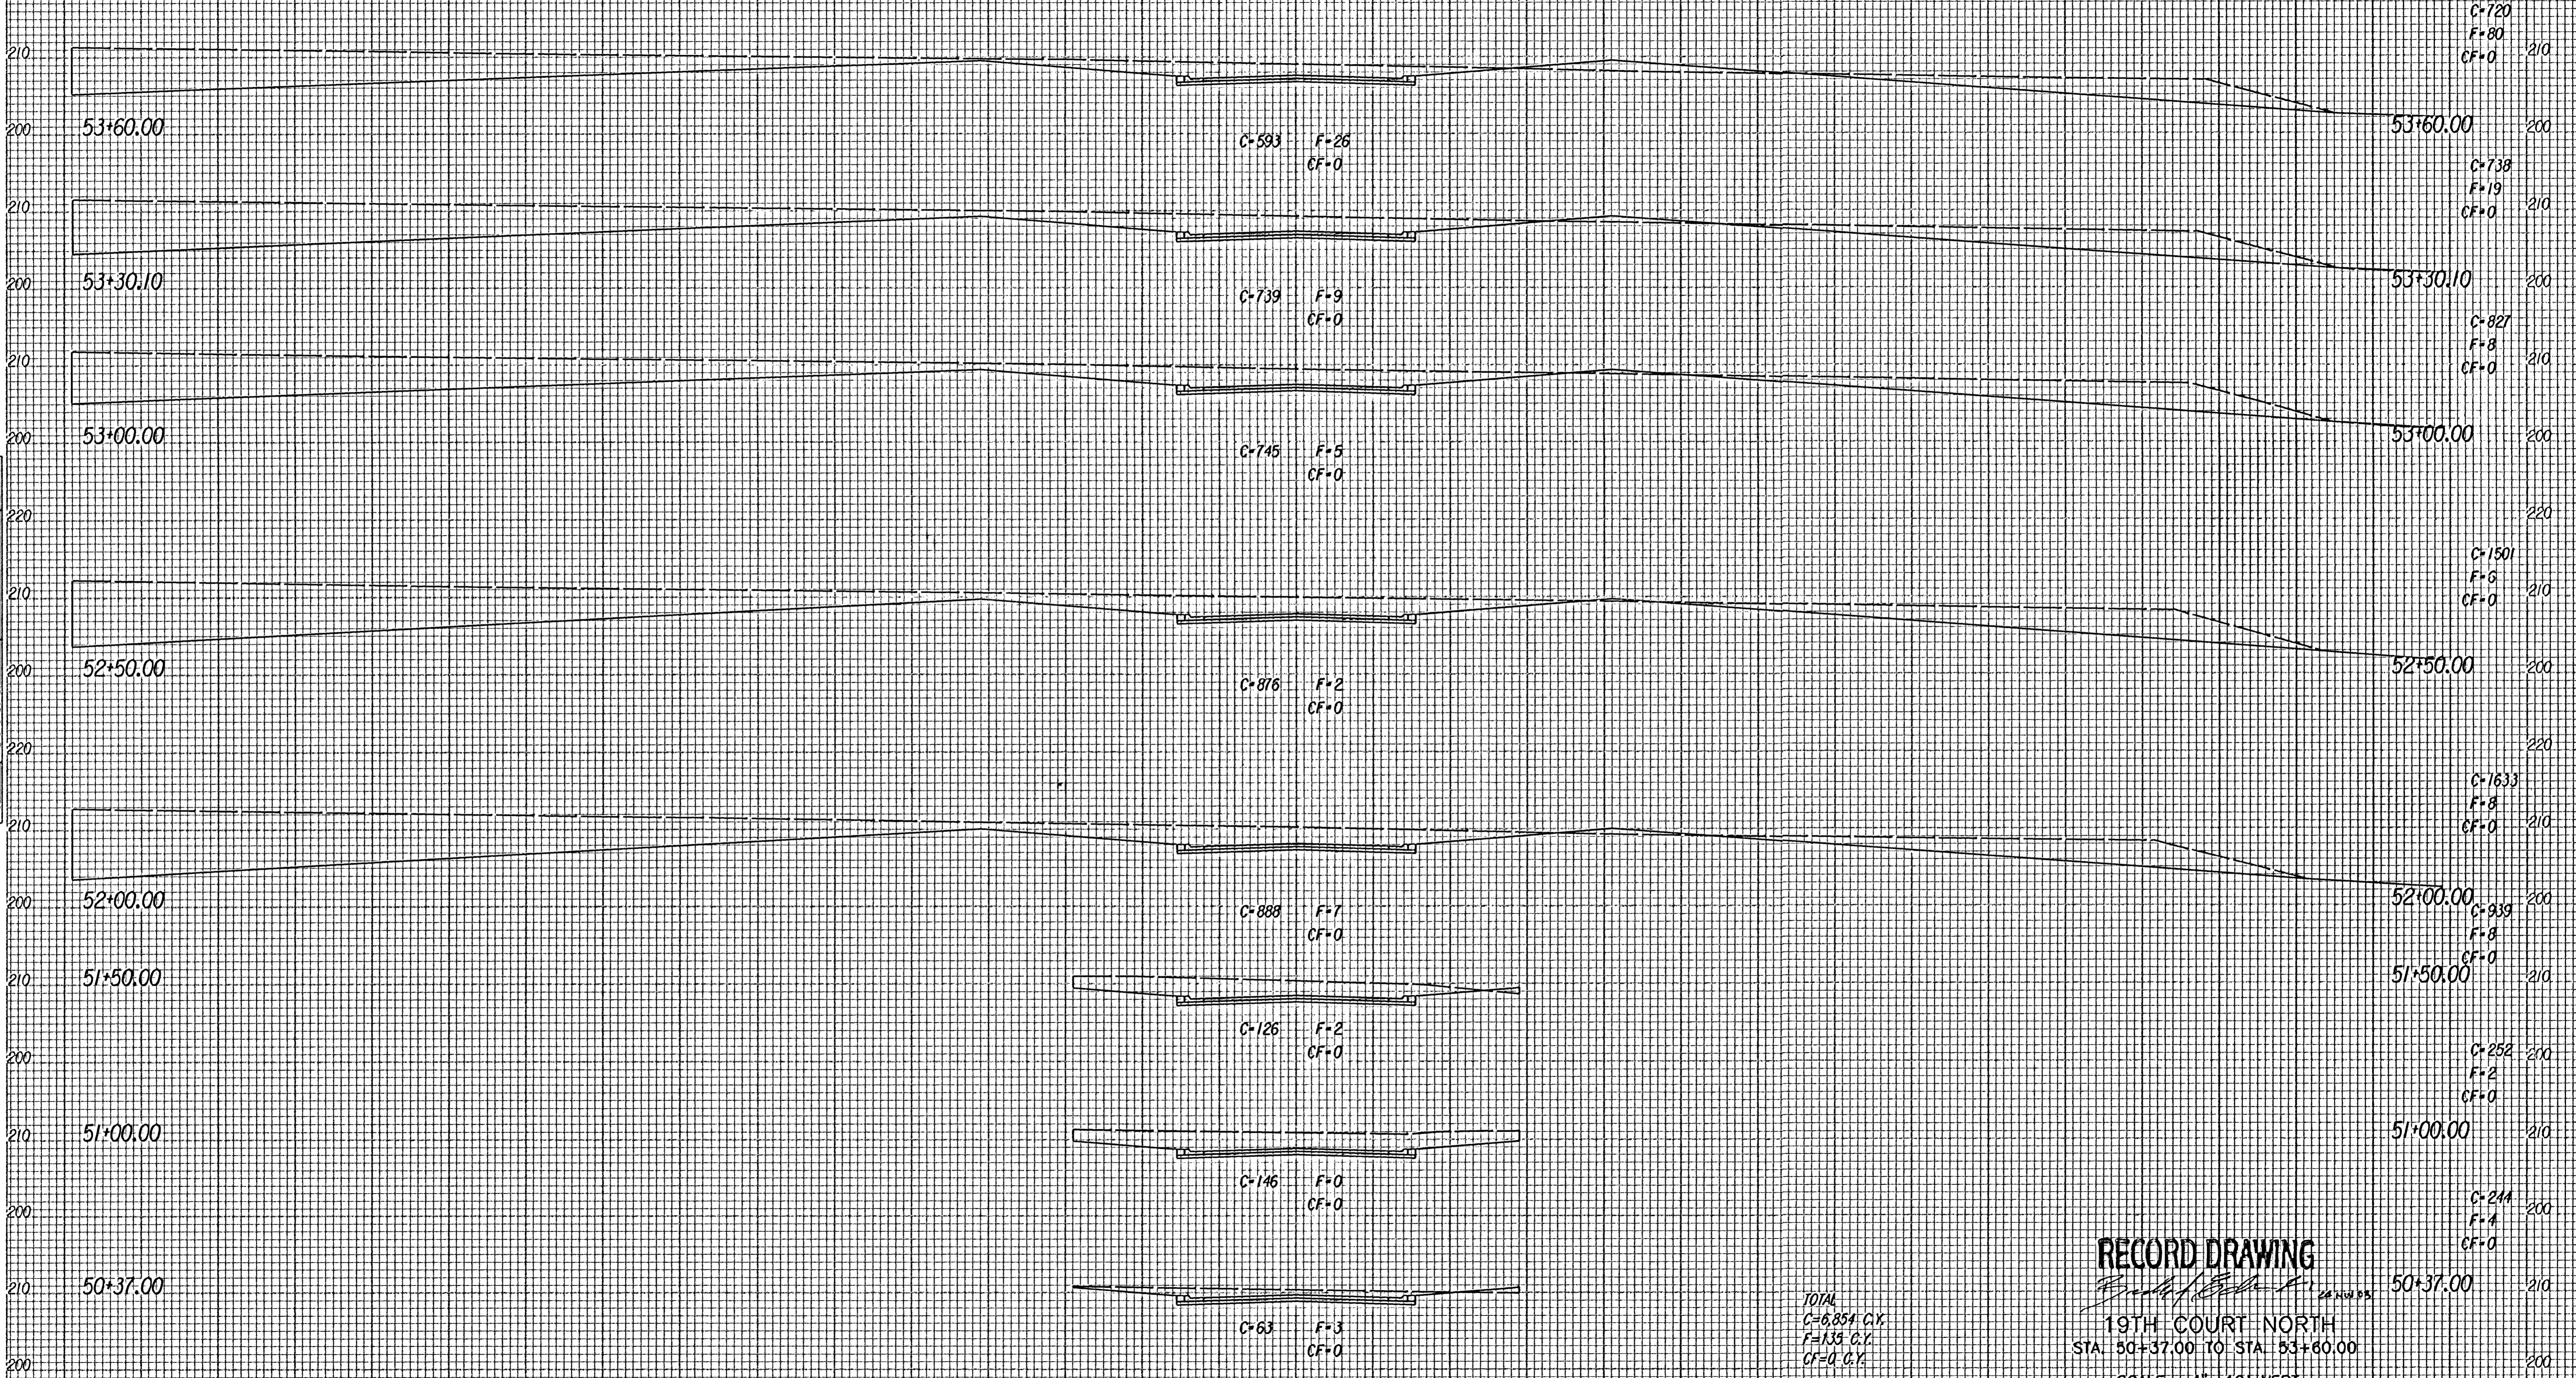

NOTE BOOK TEMPLATE AREAS CHECKED.

C-720  
F-80  
CF-0  
210

C-738  
F-19  
CF-0  
210

C-827  
F-8  
CF-0  
210

C-1501  
F-6  
CF-0  
210

C-1633  
F-8  
CF-0  
210

C-939  
F-8  
CF-0  
210

C-252  
F-2  
CF-0  
210

C-244  
F-4  
CF-0  
210

TOTAL  
C=6854 C.Y.  
F=133 C.Y.  
CF=0 C.Y.

**RECORD DRAWING**  
19TH COURT NORTH  
STA. 50+37.00 TO STA. 53+60.00  
SCALE 1" = 10' VERT.  
1" = 10' HORIZ.

160 150 140 130 120 110 100 90 80 70 60 50 40 30 20 10 0 10 20 30 40 50 60 70 80 90 100 110 120 130 140 150 160