

160 150 140 130 120 110 100 90 80 70 60 50 40 30 20 10 0 10 20 30 40 50 60 70 80 90 100 110 120 130


PROJECT NO.	SHEET NO.	TOTAL SHEETS
472-83376	48	50

NOTE BOOK TEMPLATE
AREAS CHECKED
NO.

220

210

48+66.31

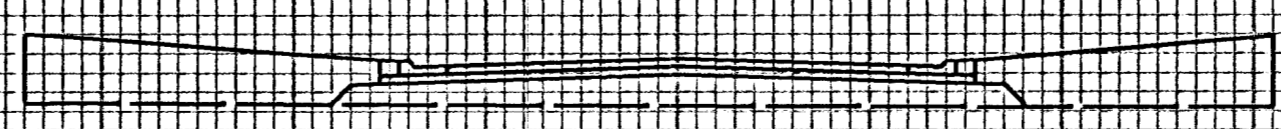

0-0 F=144
CF=47

RECORD DRAWING

[Signature] 24 NOV 65

CHURCHILL
STA. 48+66.31

48+66.31

SCALE 1" = 10' VERT.
1" = 10' HORIZ

160 150 140 130 120 110 100 90 80 70 60 50 40 30 20 10 0 10 20 30 40 50 60 70 80 90 100 110 120 130 140 150 160