




| | | |
|--------------------------|-----------------|--------------------|
| PROJECT NO. 472-83377 | SHEET NO. 10 | TOTAL SHEETS 23 |
|--------------------------|-----------------|--------------------|

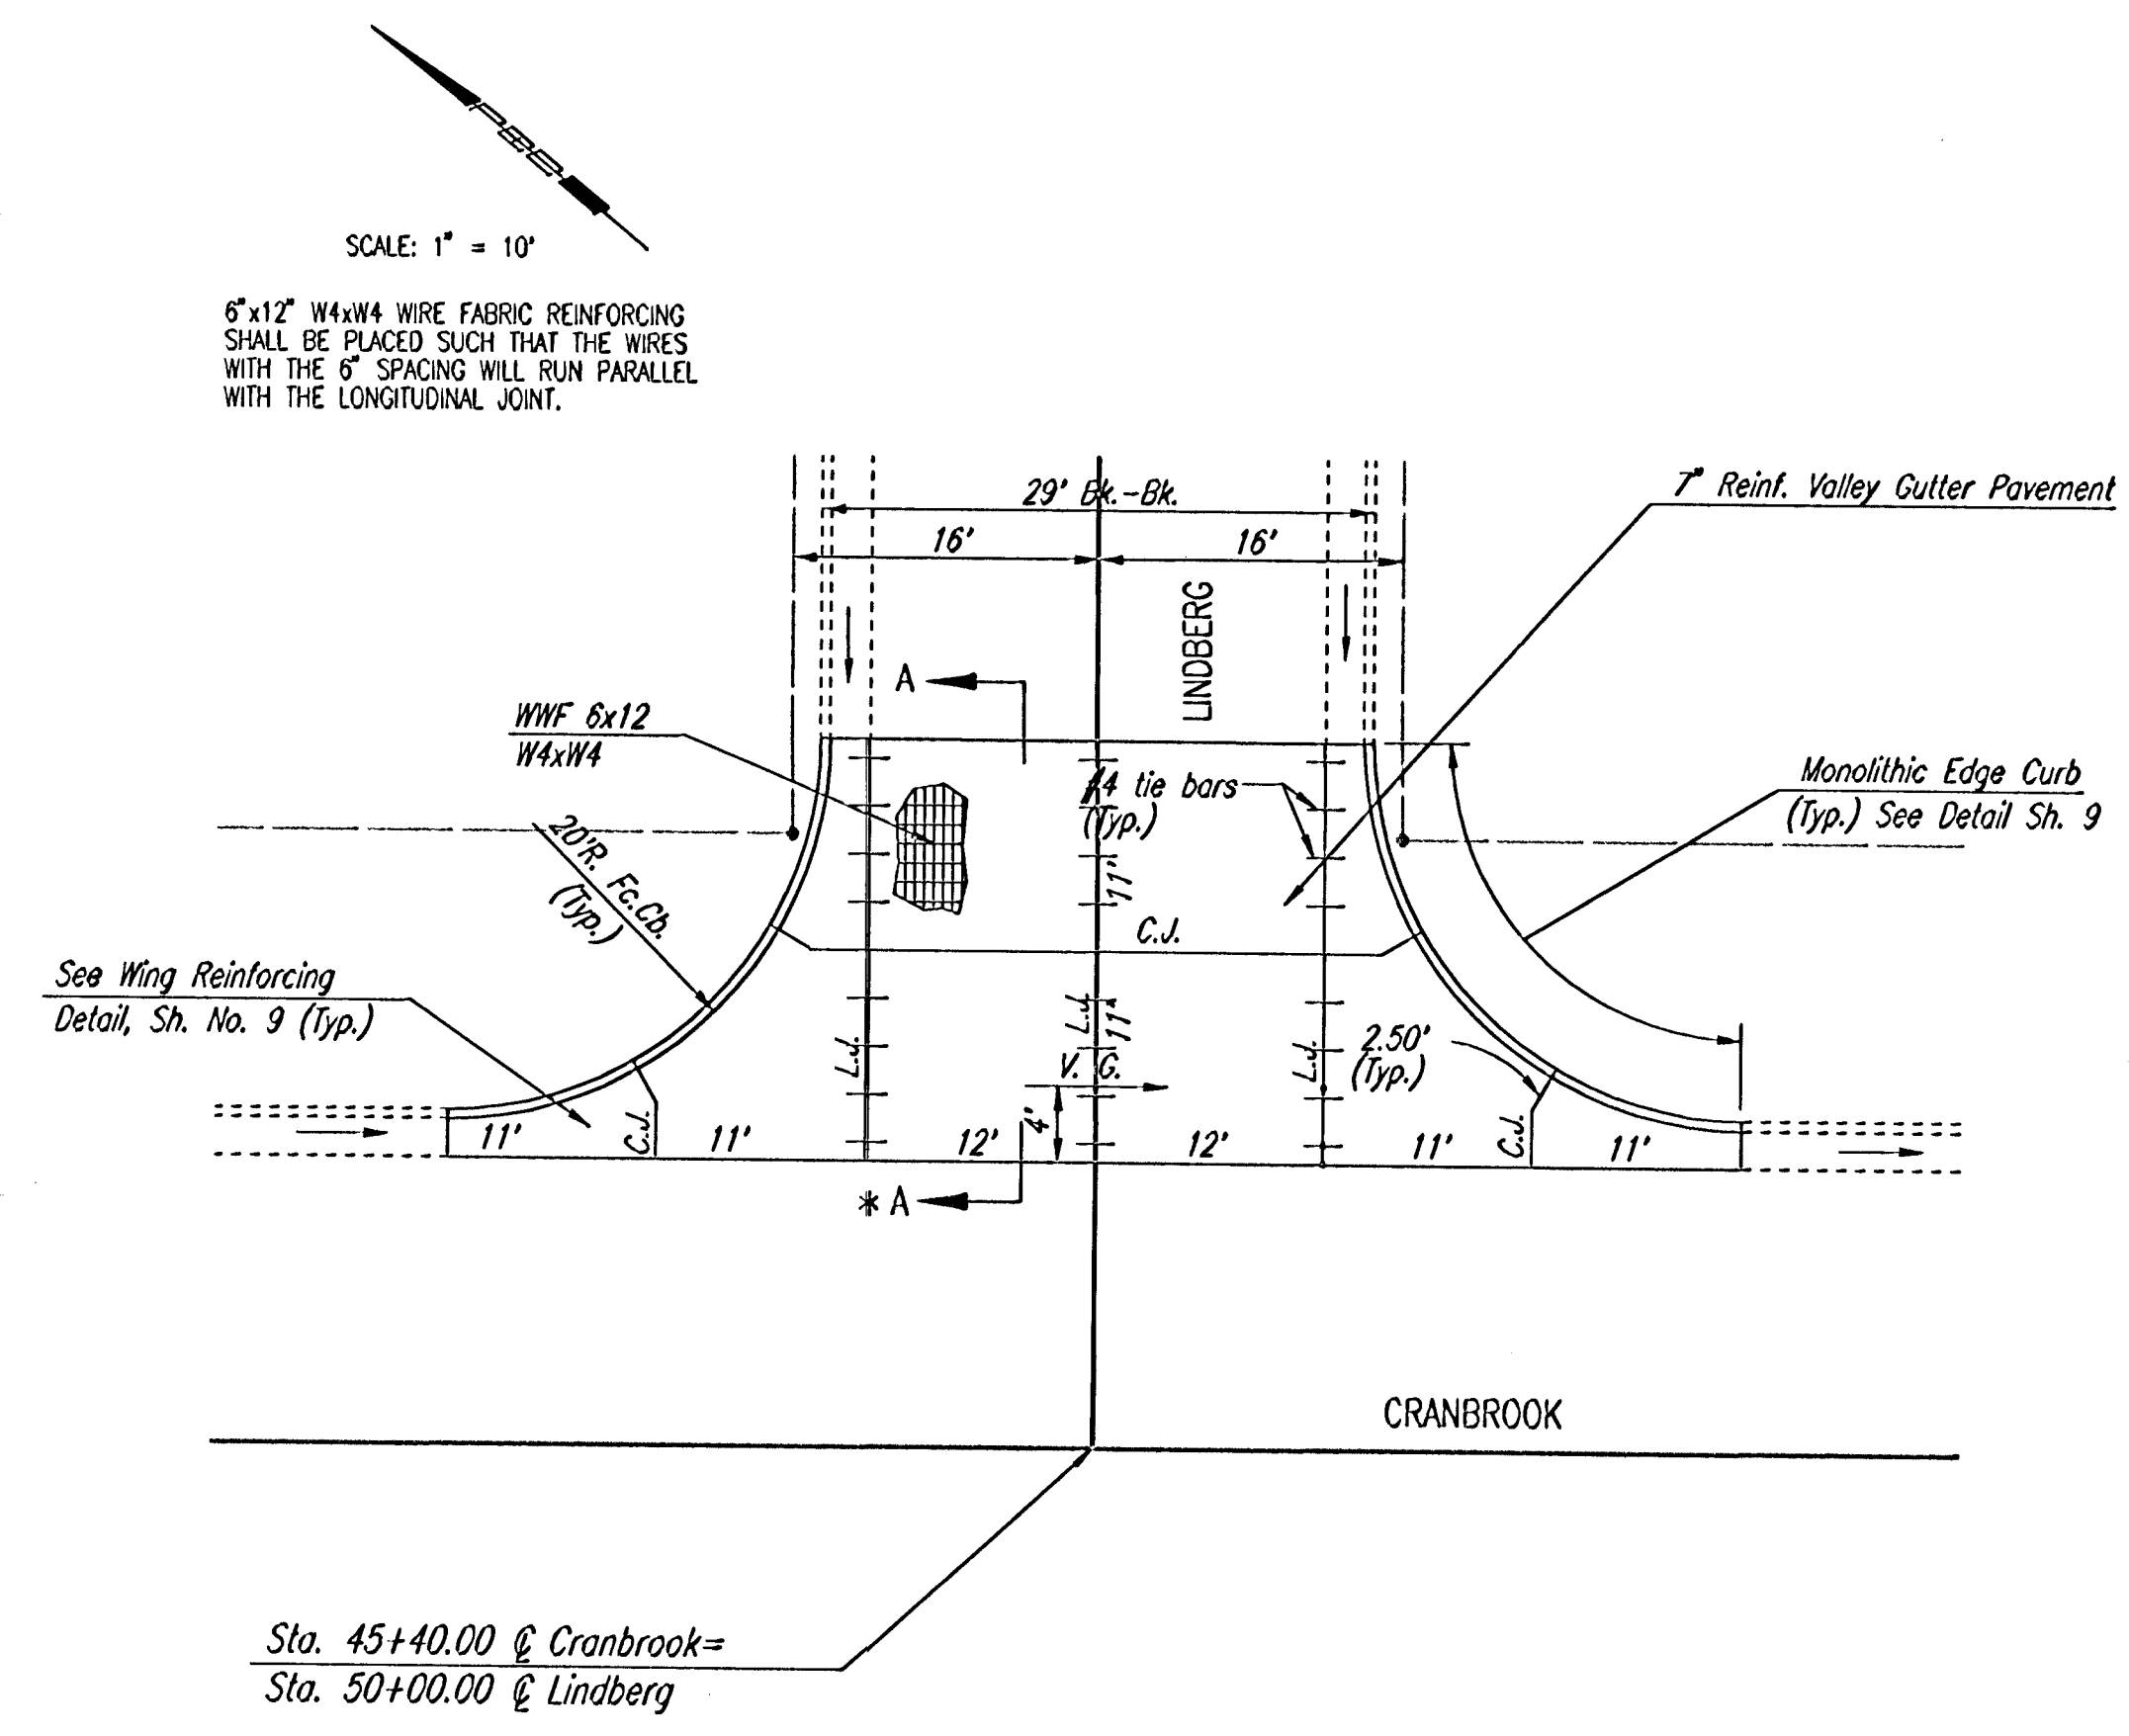

PLAN
REINFORCED VALLEY GUTTER

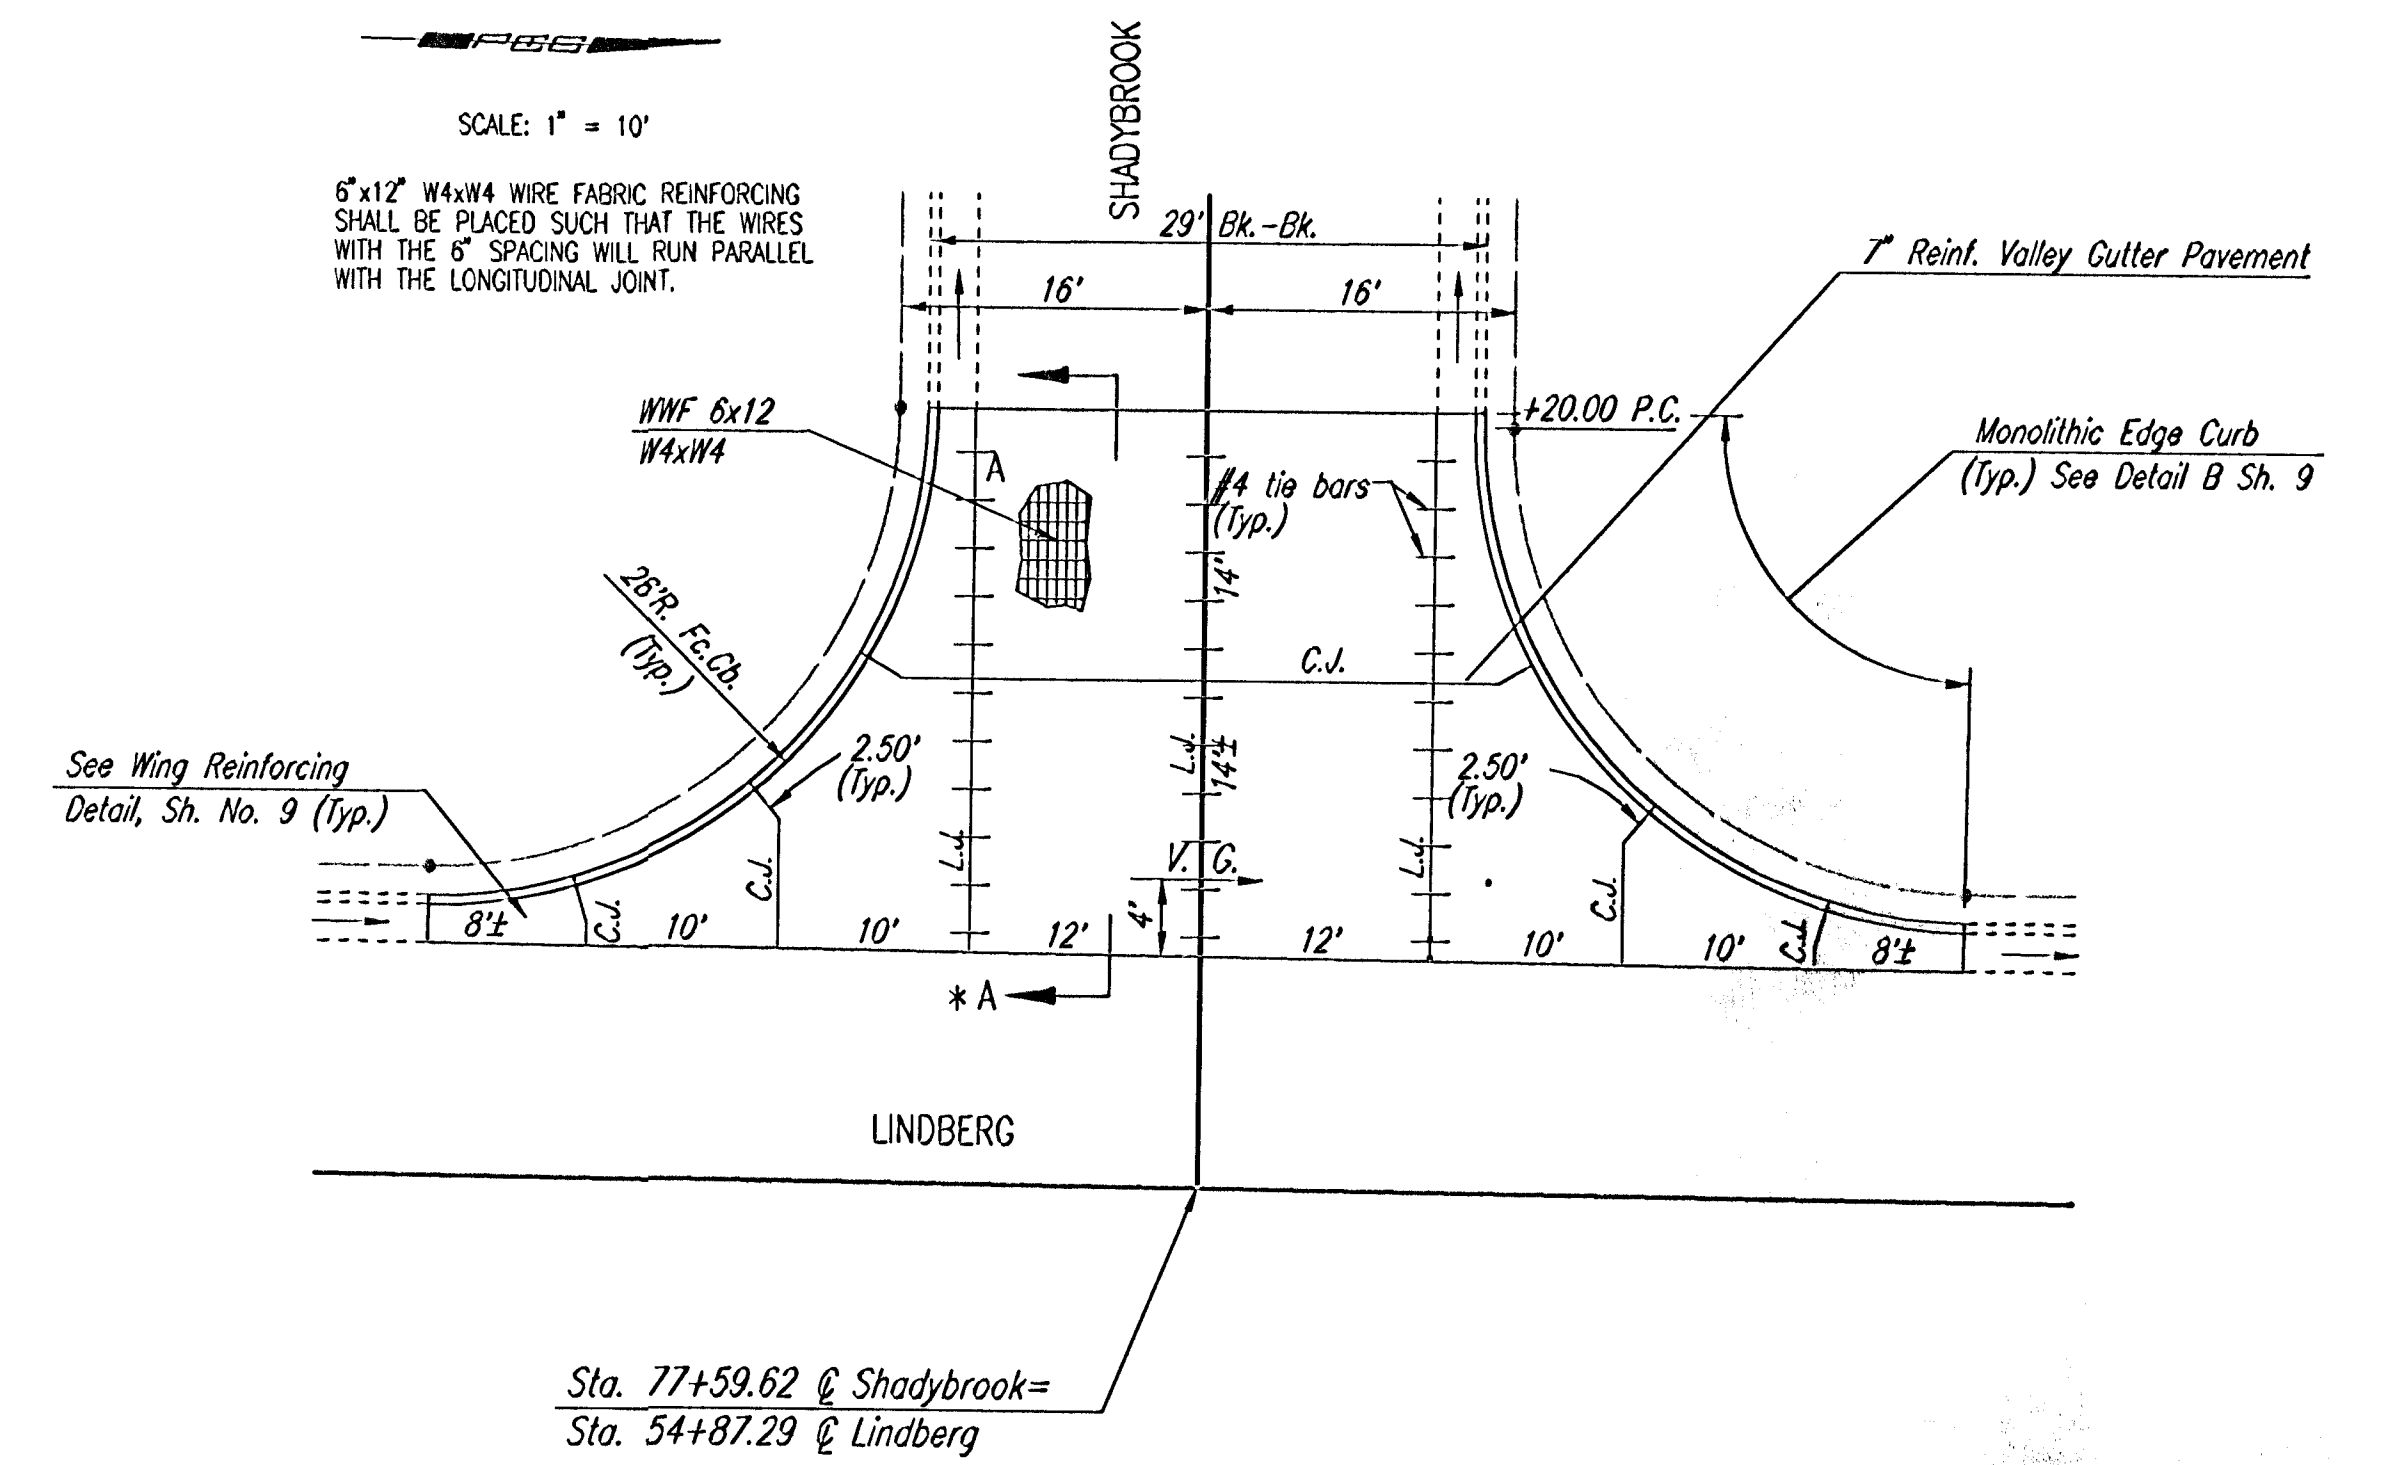

PLAN
REINFORCED VALLEY GUTTER

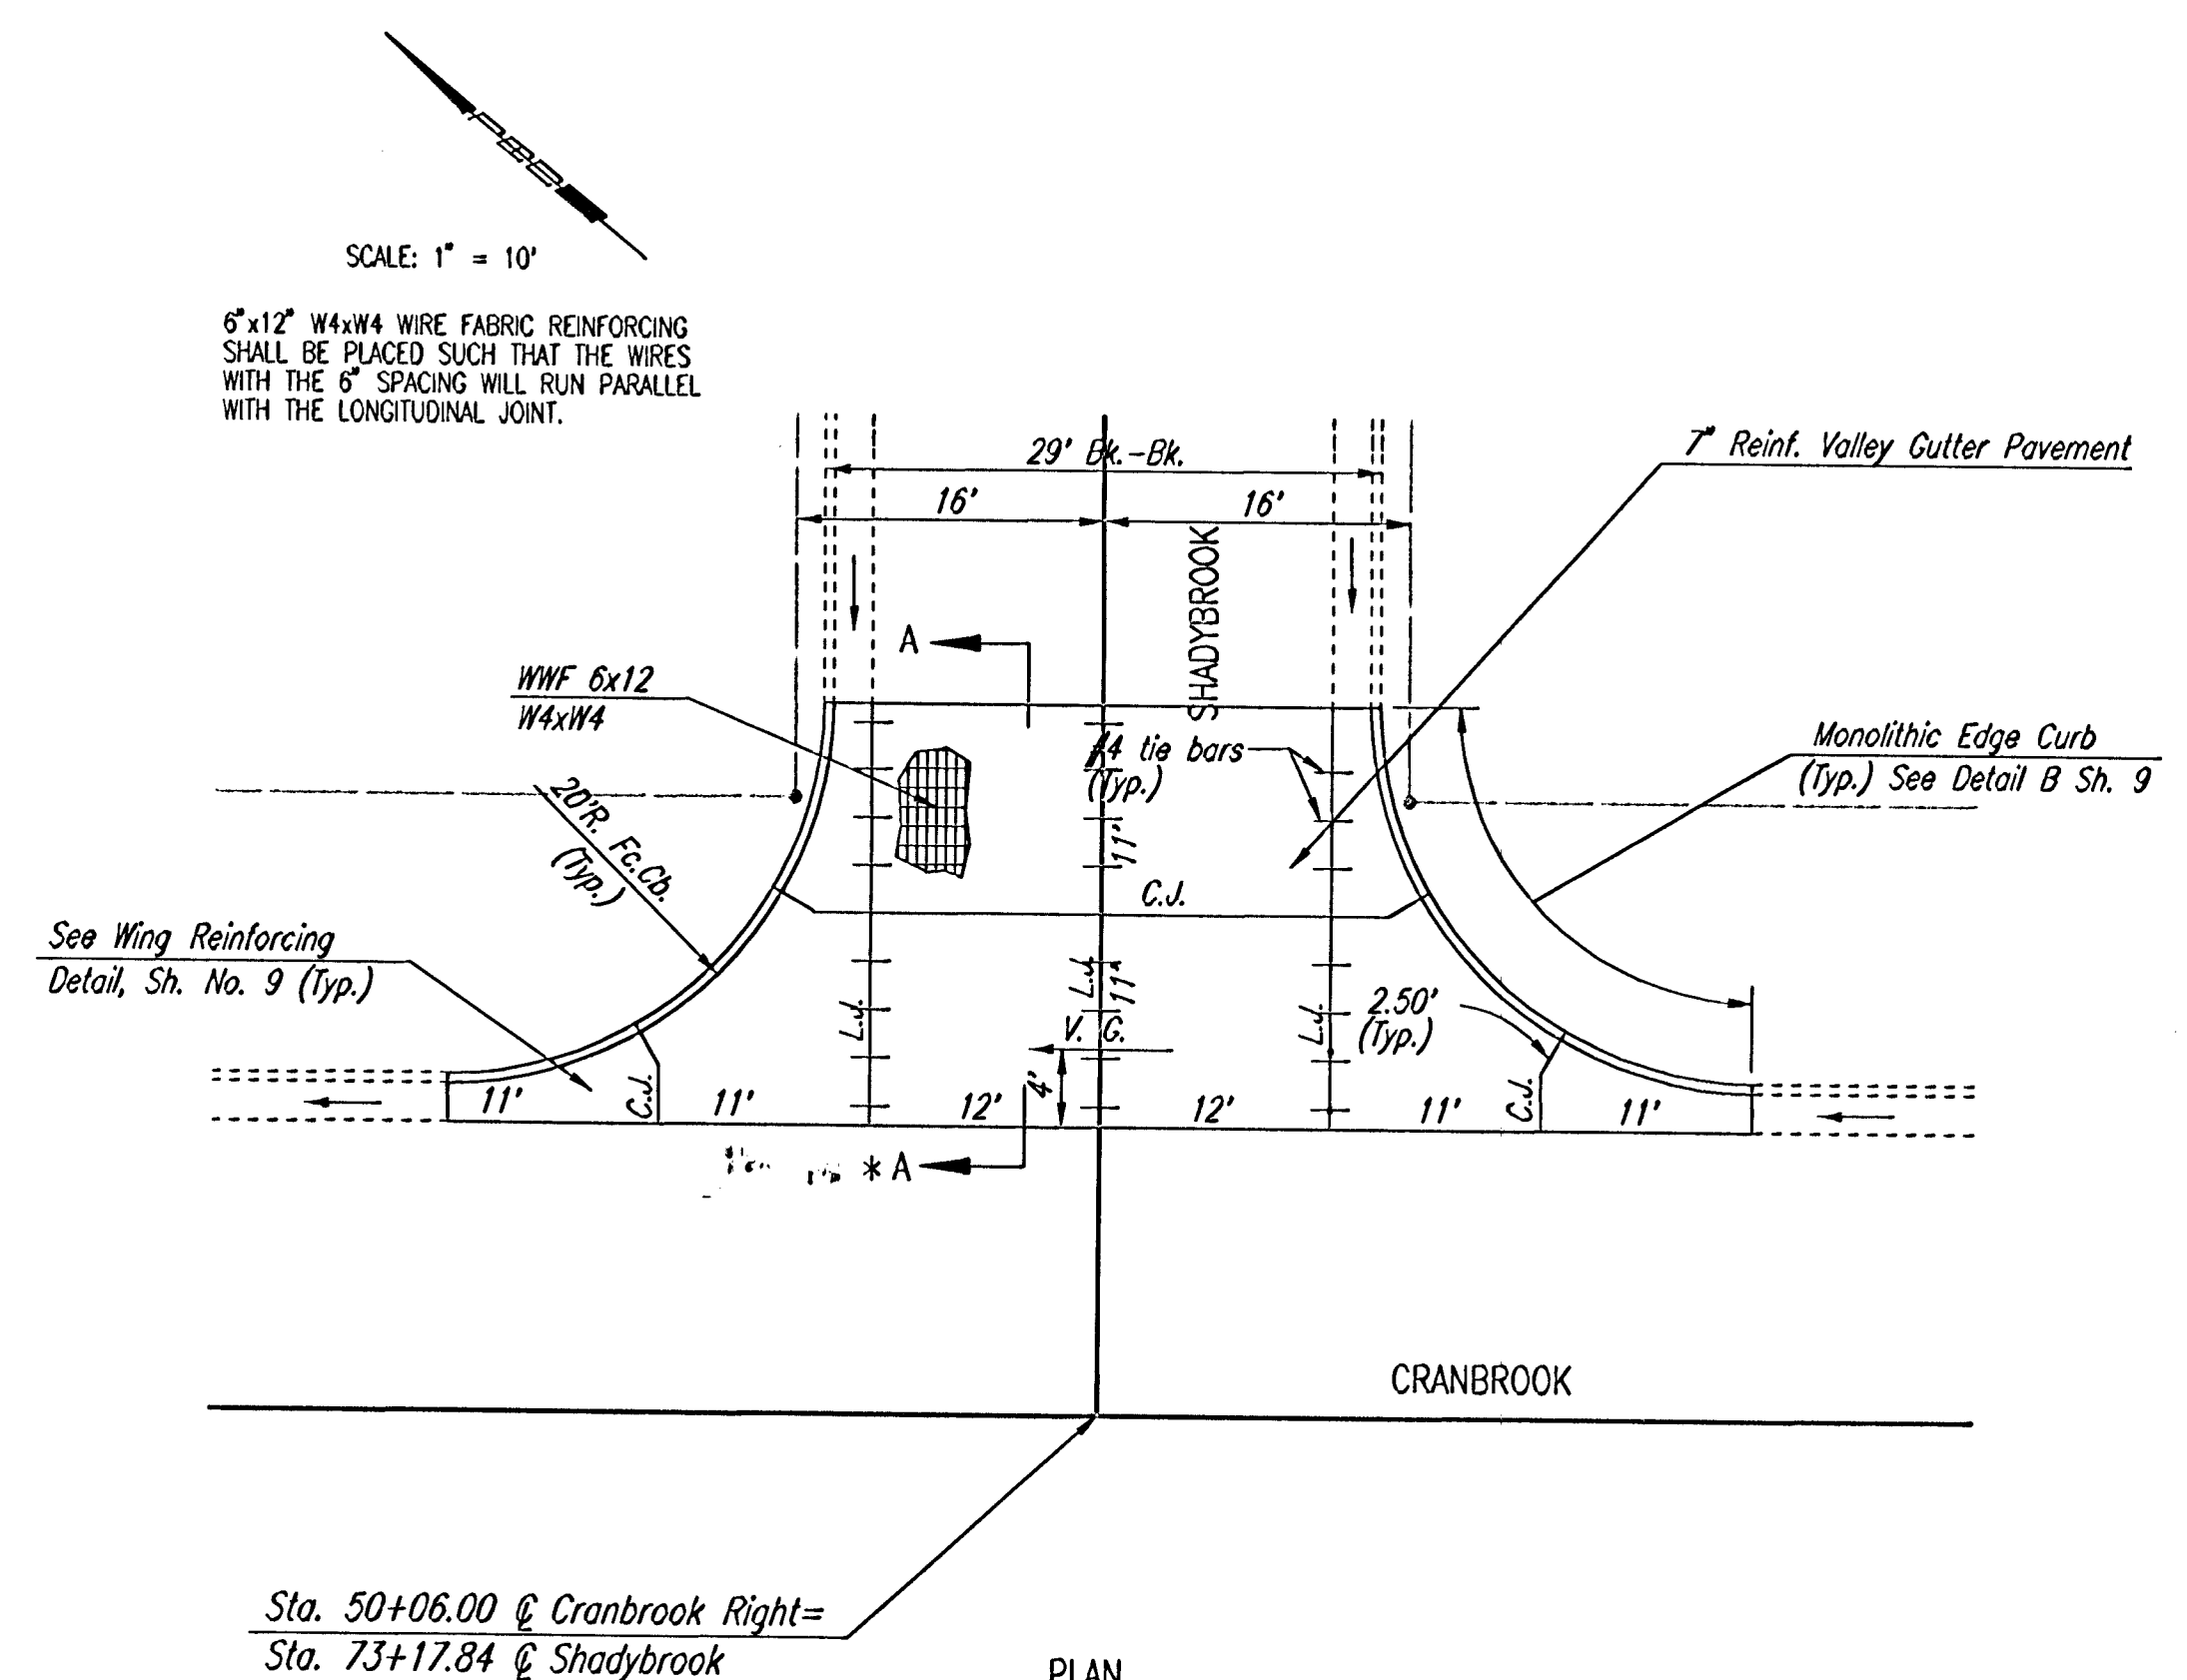

PLAN
REINFORCED VALLEY GUTTER

RECORD DRAWING
24 Nov 03

REMINGTON PLACE - PHASE 3

VALLEY GUTTER PLANS

Professional Engineering Consultants, P.A.
303 S. TOPEKA • WICHITA, KANSAS 67202
316-262-2691 • FAX 316-262-3003

| | |
|--------------------|-------------------|
| Designed by BER | Checked by |
| Drawn by DEP | Date DEC, 2002 |
| | Job No. 02398-004 |

* See Sh. No. 9 for Section A-A

DSNR: RRY OPER: DEP SCALE: 1"=10.00
 C:\2002\02398\004\VALGUT\PLANS 12-03-2002 03:45:52 pm