


160 150 140 130 120 110 100 90 80 70 60 50 40 30 20 10 0 10 20 30 40 50 60 70 80 90 100 110 120 130

PROJECT NO.	SHEET NO.	TOTAL SHEETS
472-83377	20	23

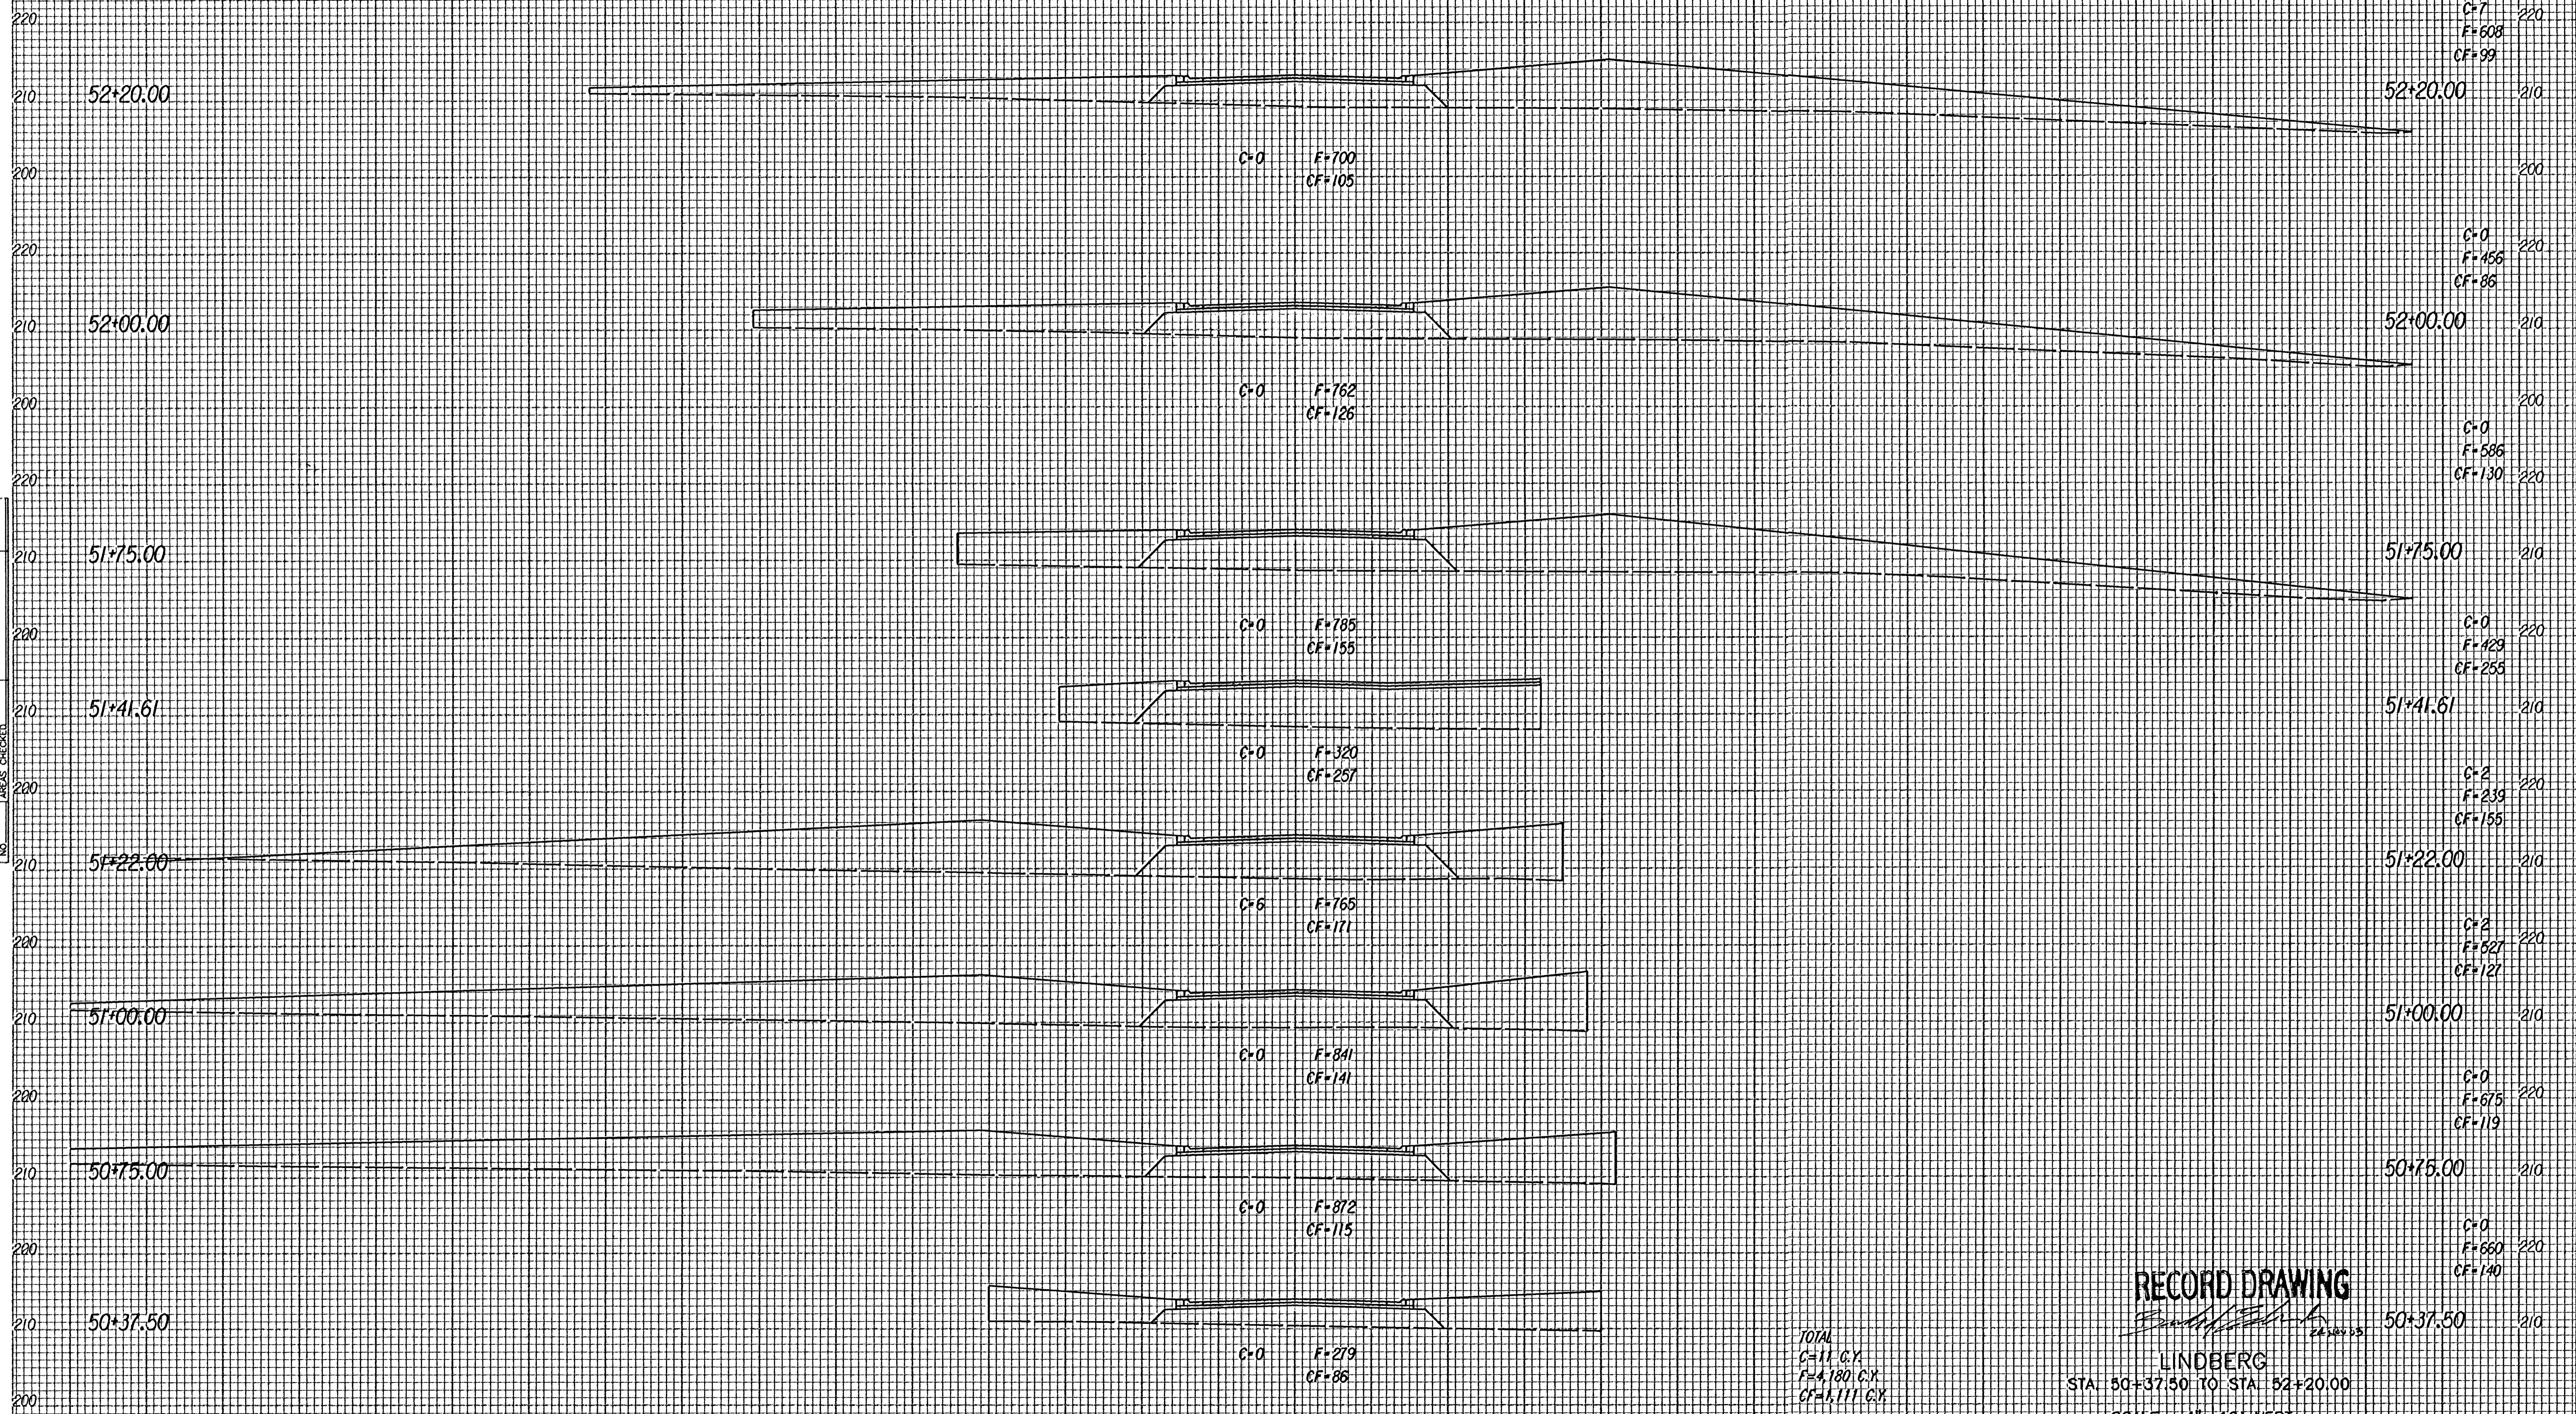

NOTE BOOK TEMPLATE AREAS CHECKED

TOTAL
 C=11 C.Y.
 F=4180 C.Y.
 CF=1,111 C.Y.

RECORD DRAWING

[Signature]

LINDBERG

STA. 50+37.50 TO STA. 52+20.00

SCALE 1" = 10' VERT.
 1" = 10' HORIZ.

160 150 140 130 120 110 100 90 80 70 60 50 40 30 20 10 0 10 20 30 40 50 60 70 80 90 100 110 120 130 140 150 160