


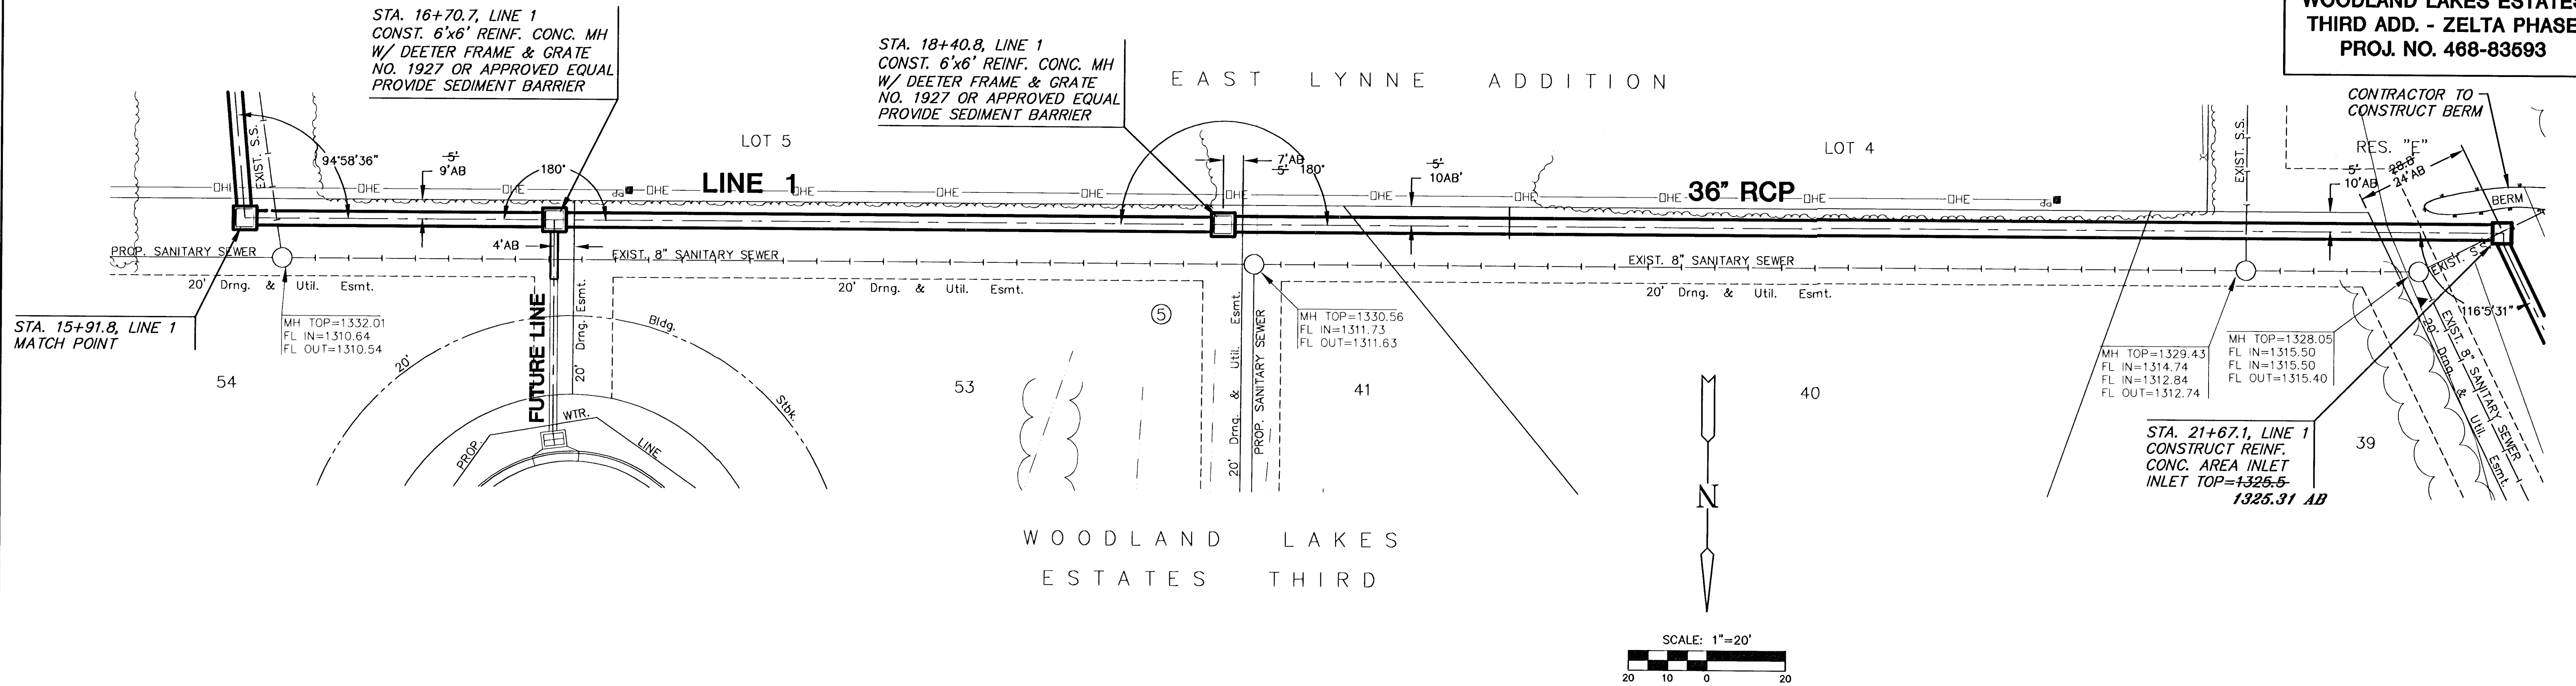

PLAN LINE 1

AS-BUILT FEBRUARY 2004

