
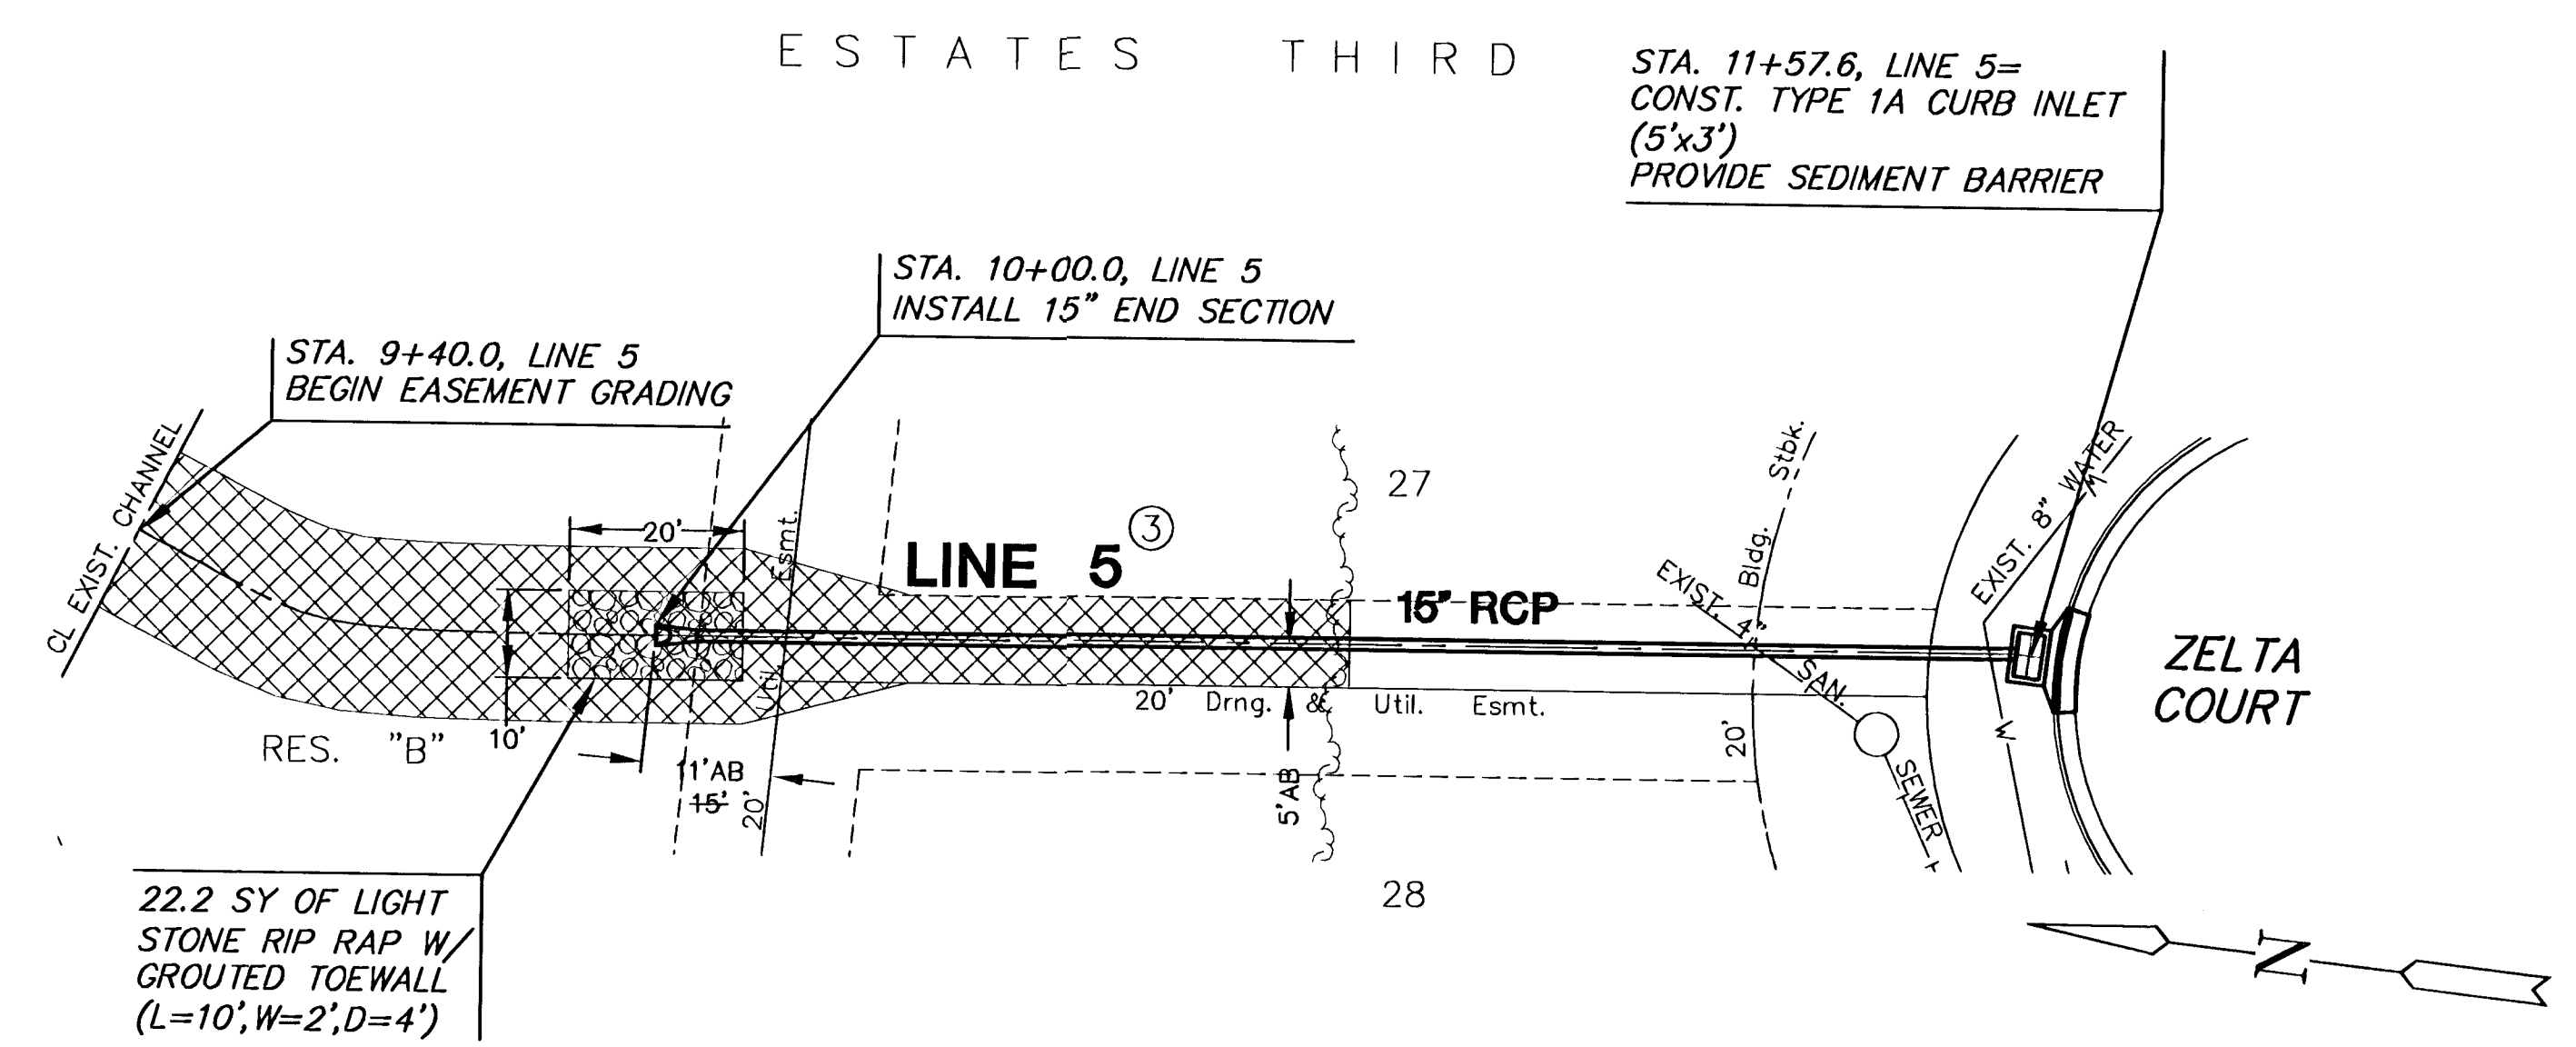


WOODLAND LAKES
ESTATES THIRD

WOODLAND LAKES
ESTATES THIRD



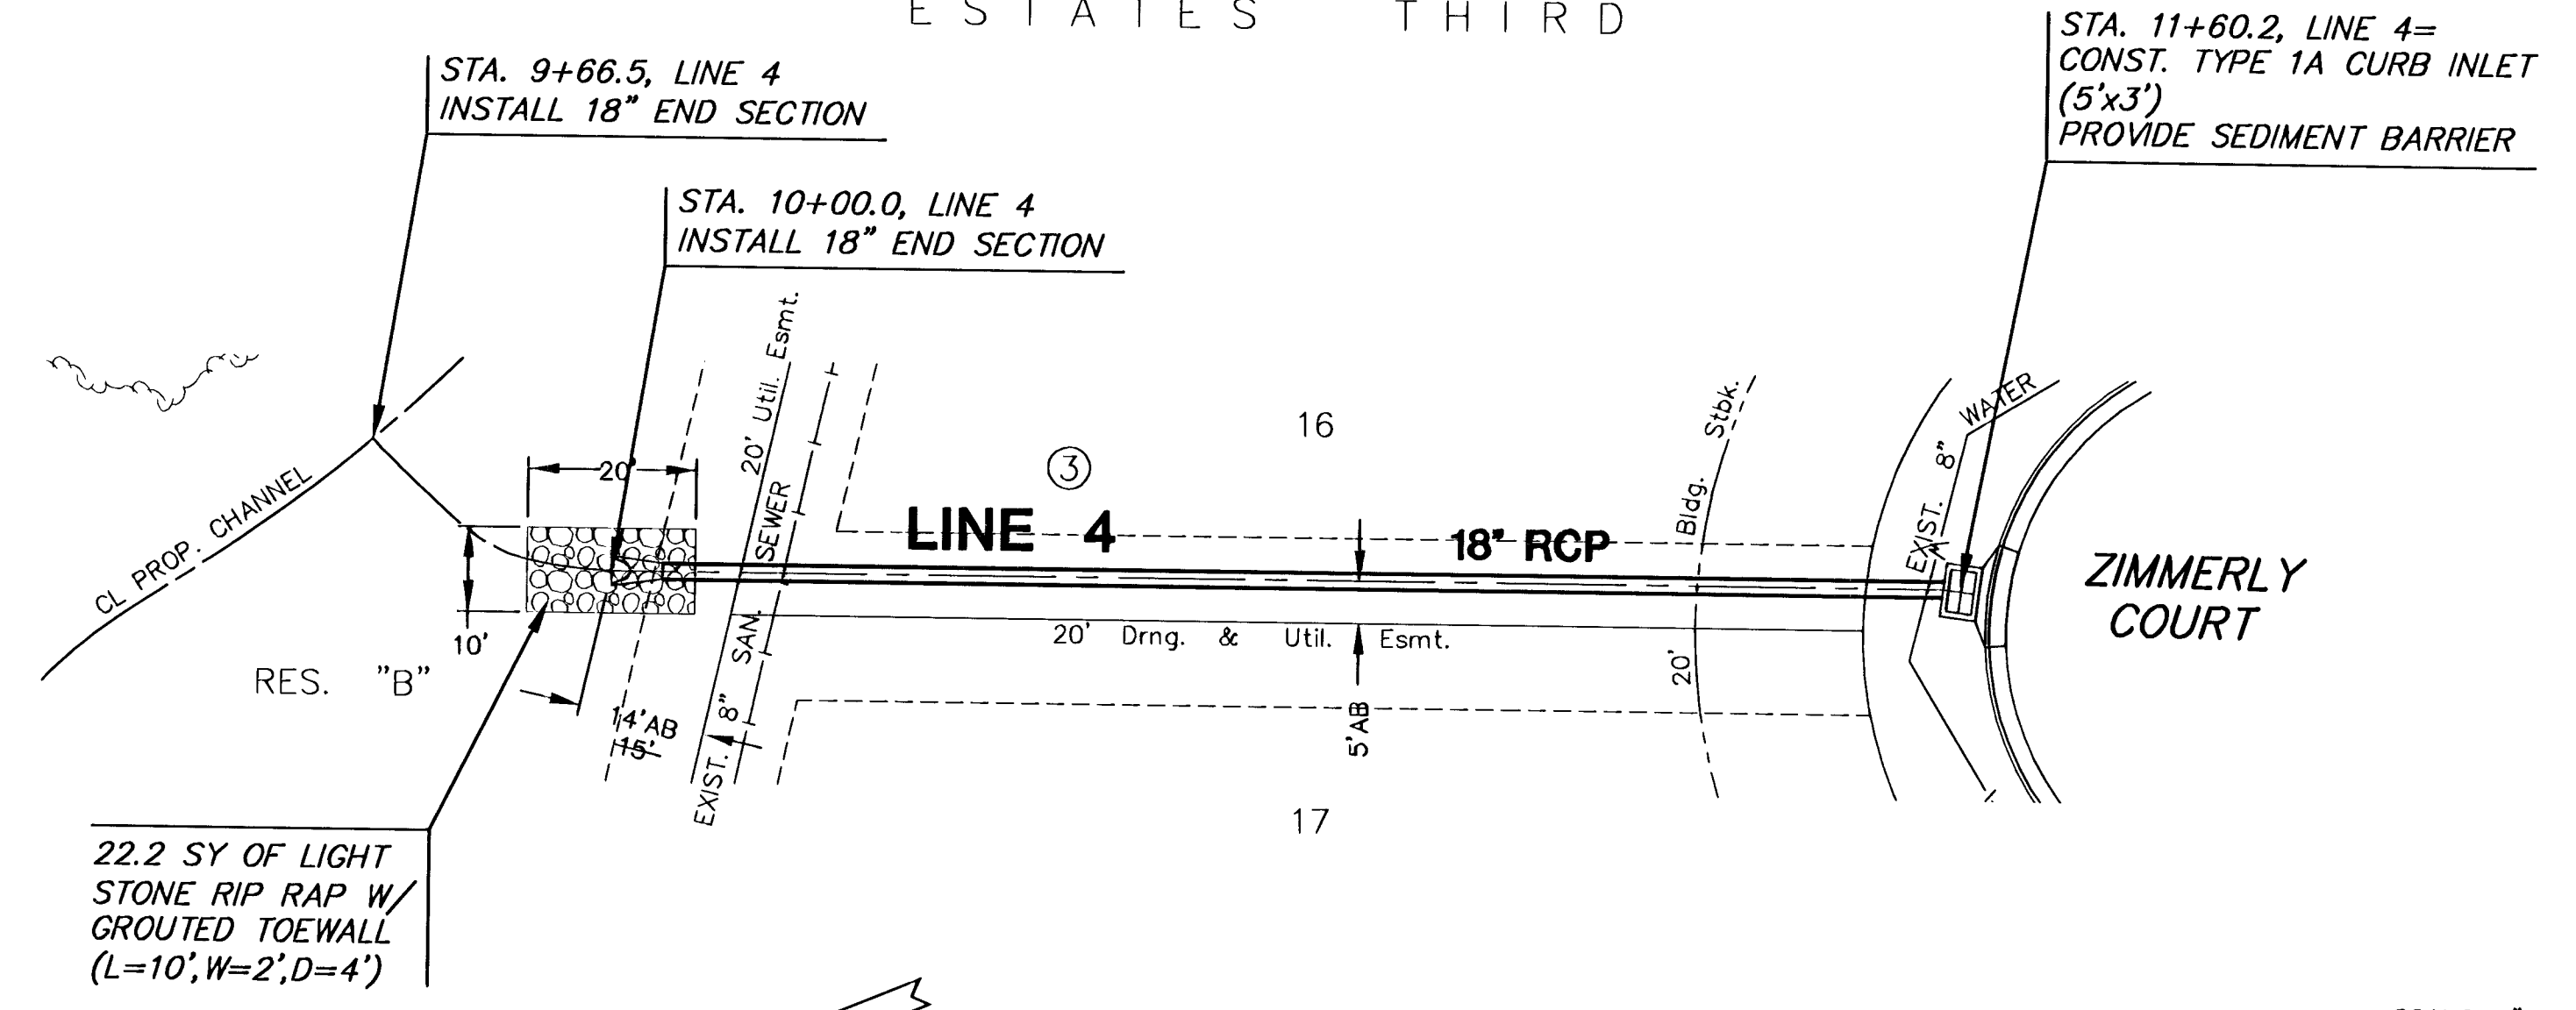


PLAN LINE 4

PLAN LINE 5

FOR INFORMATION ONLY:
ESMT. GRADING: LINE 4
CUT.....21 C.Y.
FILL.....0 C.Y.

FOR INFORMATION ONLY:
ESMT. GRADING: LINE 5
CUT.....37 C.Y.
FILL.....0 C.Y.

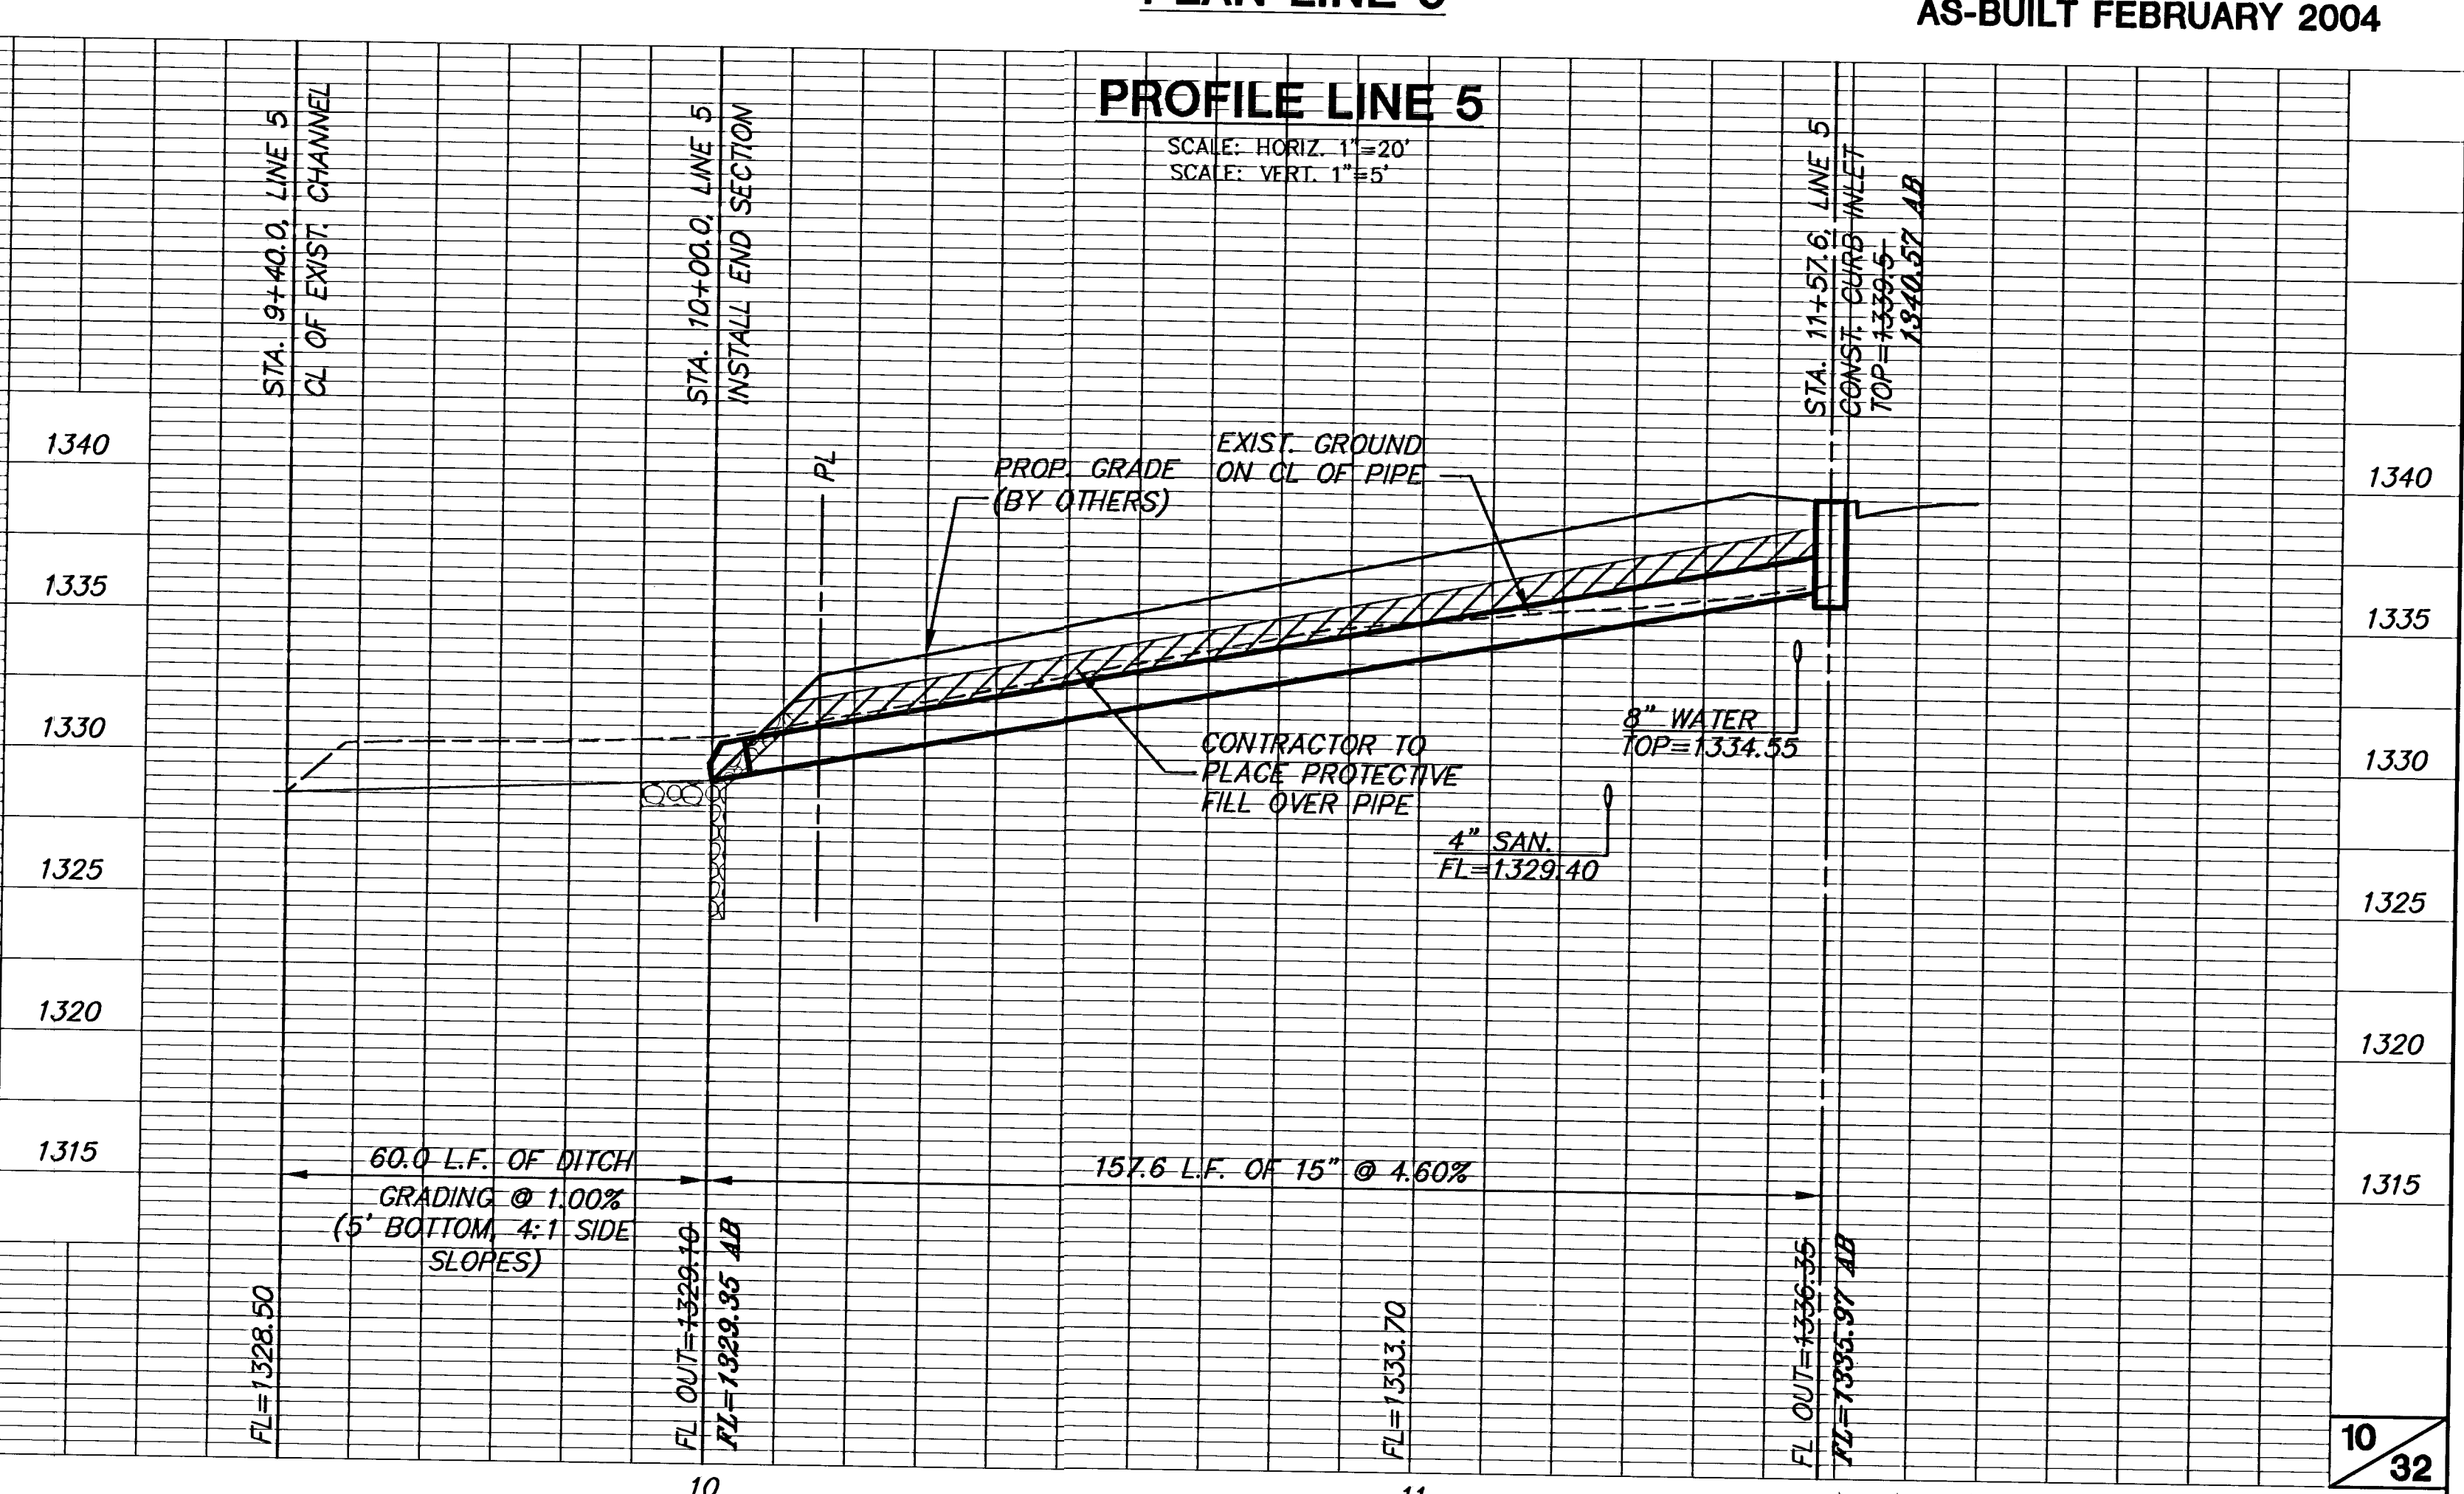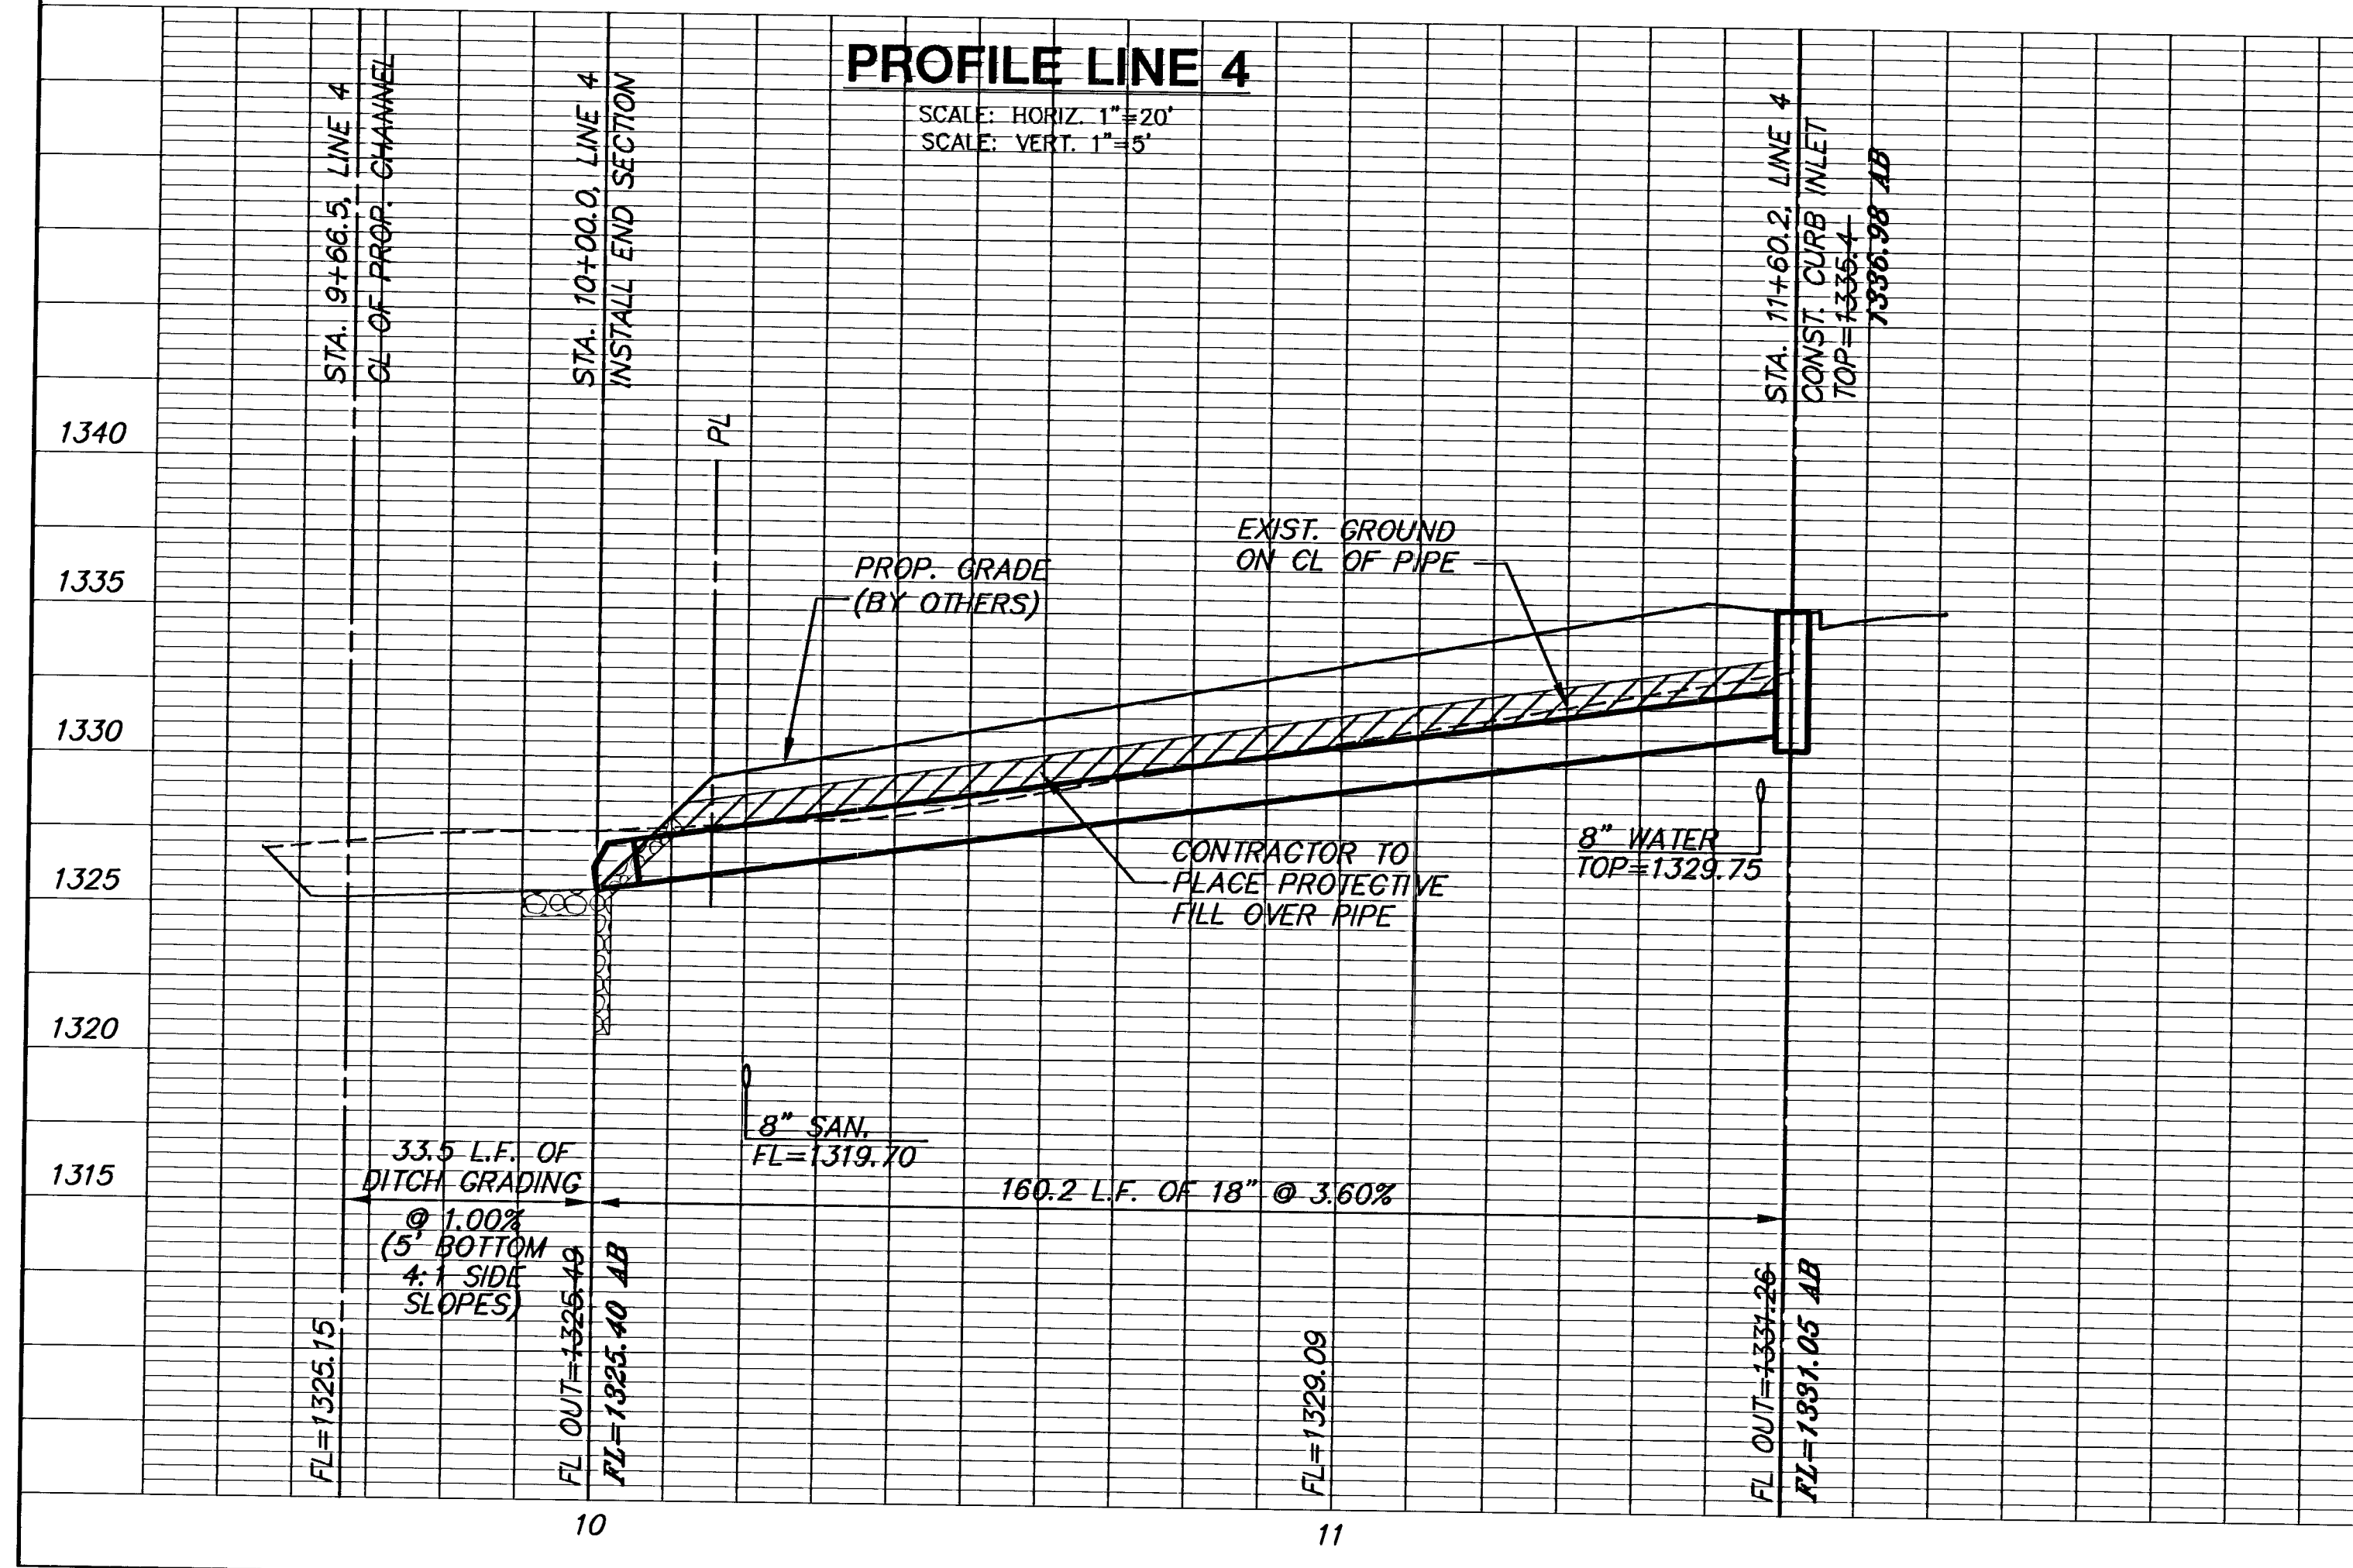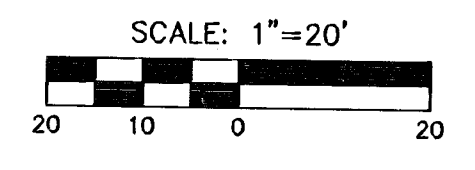

AS-BUILT FEBRUARY 2004