

MH TOP=1334.77  
 FL IN=1323.30  
 FL OUT=1323.20









MH TOP=1328.63  
 FL IN=1318.28  
 FL OUT=1318.18

MH TOP=13XX.XX  
 FL IN=  
 FL OUT=


NORMAL POOL=1329.00  
 100 YR=1332.00

Install 55.5 S.Y. of North American  
 Green C-350 Erosion Mat (or  
 Approved Equal) (Install per  
 Manufacturer's Recommendations)


LEGEND

- |   |  |  |                     |
|---|--|--|---------------------|
|  | =LIMIT OF TREE REMOVAL                                   |  | =LIMITS OF GRADING  |
|  | =PROPOSED WETLANDS MITIGATION<br>(SEE DETAIL ON SHEET 2) |  | =EXIST. CONTOUR     |
|  | =NORMAL POOL   |  | =PROP. CONTOUR      |
|   |  |  | =AS-BUILT CONTOUR   |
|   |  |  | =AS-BUILT SPOT ELV. |

PLAN VIEW

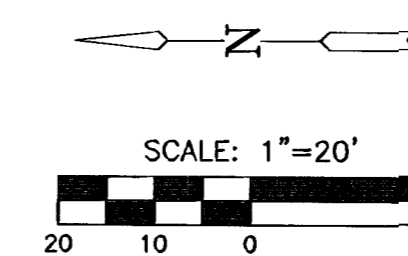

AS-BUILT FEBRUARY 2004

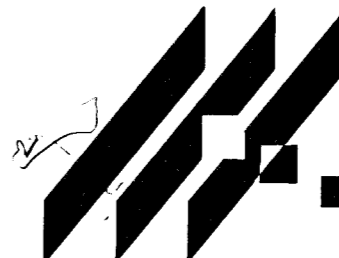 <b>MKEC</b> ENGINEERING CONSULTANTS 411 N. WEBB ROAD WICHITA, KS. 67206 316-684-9600	<b>WOODLAND LAKES ESTATES</b> <b>THIRD ADDITION - ZELTA PHASE</b> <small>PROJECT NAME</small>		
	<b>POND GRADING</b> <small>SHEET TITLE</small>		
	<small>DESIGN BY:</small> BSH	<small>DRAWN BY:</small> JAS/DMU	<small>CHECKED BY:</small> ASH
	<small>DATE:</small> JULY 2003	<small>JOB NO.:</small> 02172	<small>SHEET/OF:</small> 18 / 32