


BENCHMARK:
 HOOVER ROAD AND 35TH STREET SOUTH
 CITY OF WICHITA - BENCHMARK DISC.
 NE CORNER OF DECK ON R.C.B.C. ON
 35TH ST. S., 100.00 FEET WEST OF HOOVER RD.
 ELEV. = 1297.24 NGVD29

Scale: 1" = 40' Horizontal
 1" = 5' Vertical



As Built 3/12/07 KR

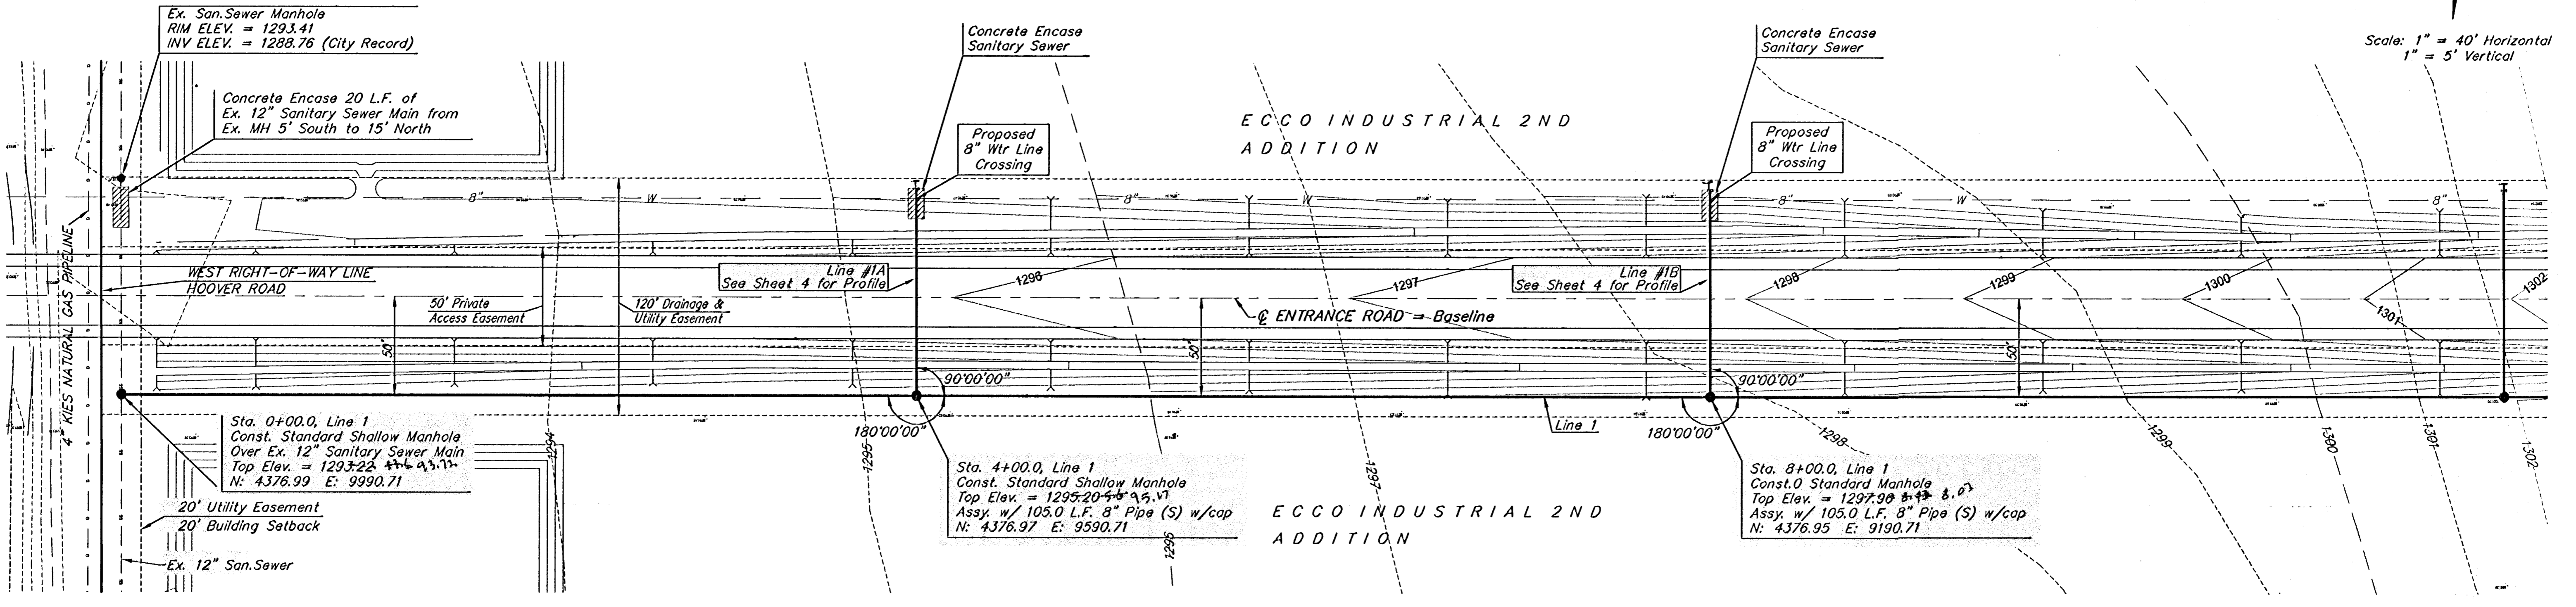