


MARK ALL END OF STUBS WITH A #4 REBAR INSIDE A 3/4" I.D. PLASTIC PIPE. THE REBAR SHALL EXTEND FROM THE TOP OF THE RISER TO A POINT 6" (MAX.) BELOW THE GROUND SURFACE. THE PLASTIC PIPE SHALL EXTEND FROM THE TOP OF THE RISER TO A POINT 4 FEET (MIN.) ABOVE THE GROUND SURFACE. THE TOP 4 FEET OF THE PLASTIC PIPE SHALL BE PAINTED FLOURESCENT GREEN.

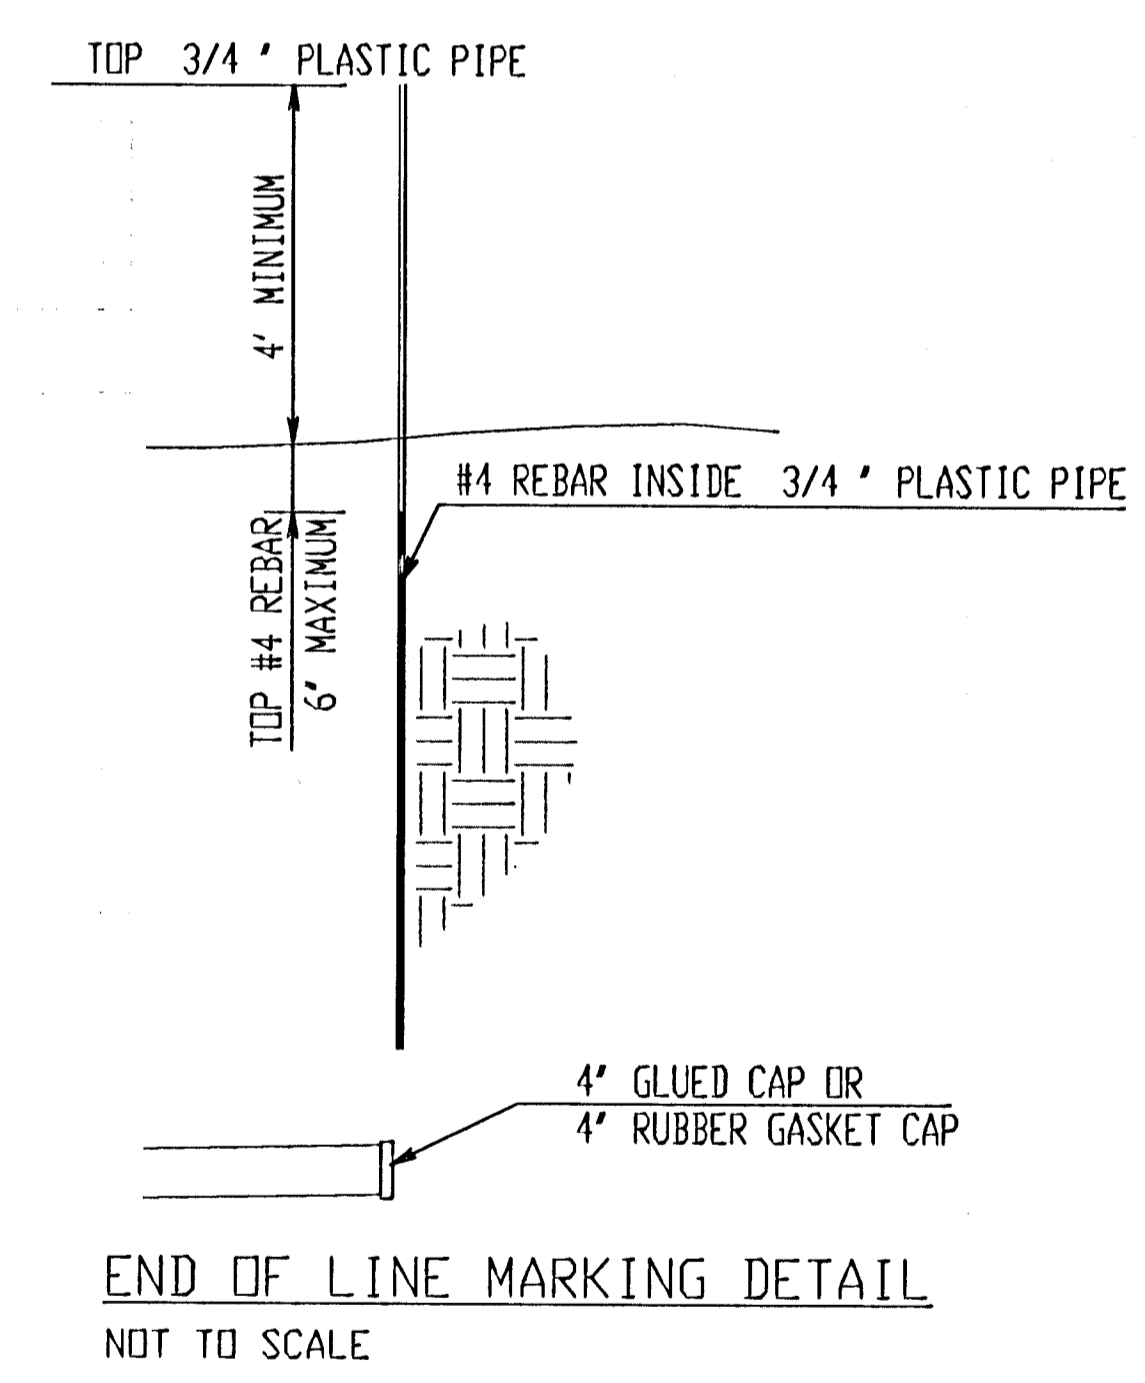

Scale: 1" = 5' Vertical

As Built 3/12/07 KSK