

SITE BENCHMARK
"□" Cut on Top of Curb
Along 34th Street North,
150' East of SW Corner of
Lot 7, Comotara Industrial
Park Fifth Addition.
Elev. = 1419.19 M.S.L.

SITE BENCHMARK:
"□" Cut on Top
of Curb
Elev. = 1419.19 M.S.L.

CAUTION!
Ex. UG Gas
crossing.
Depths Unknown.

Sta 0+00, Begin Line 1
Construct Std. Reinf. Conc.
Manhole over Existing 36"
RCP (5.5'x5.5' O.D.)
Remove 18.1 L.F. Ex. 8" SWS
Top Elev. = 1419.50

CAUTION!
Ex. UG Gas
Crossing
Depth Unknown



CAUTION!
Ex. UG
Electric

Sta 0+18.1, Line 1
Construct Std. Shallow
Manhole (4' Dia.)
1 - 12" PVC Stub (N)
Top Elev. = 1421.50

Sta 1+17.9, Line 1
Construct Type 1
Inlet (3'x5')
Top Elev. = 120.35
Install Sediment Barrier

Scale: 1" = 20' Horizontal
1" = 5' Vertical
• = Iron

Scale: 1" = 20' Horizontal
1" = 5' Vertical
• = Iron

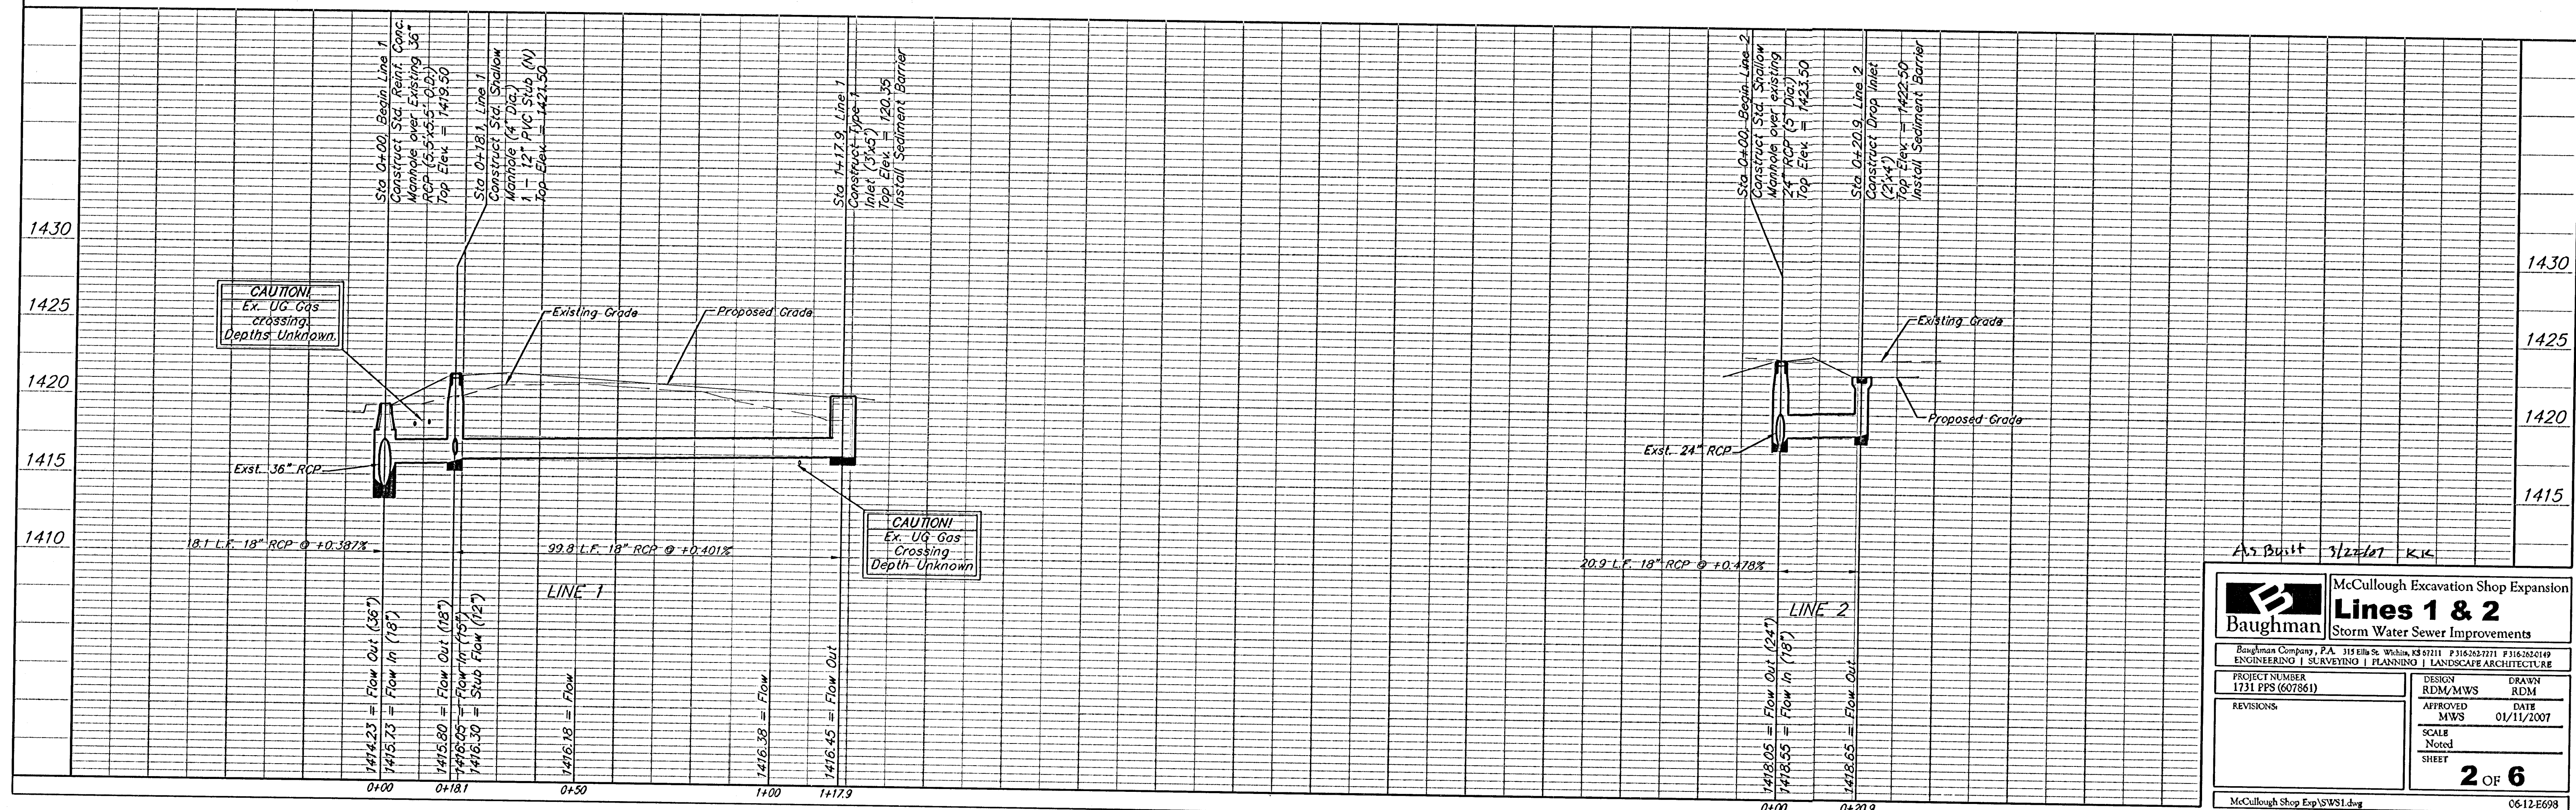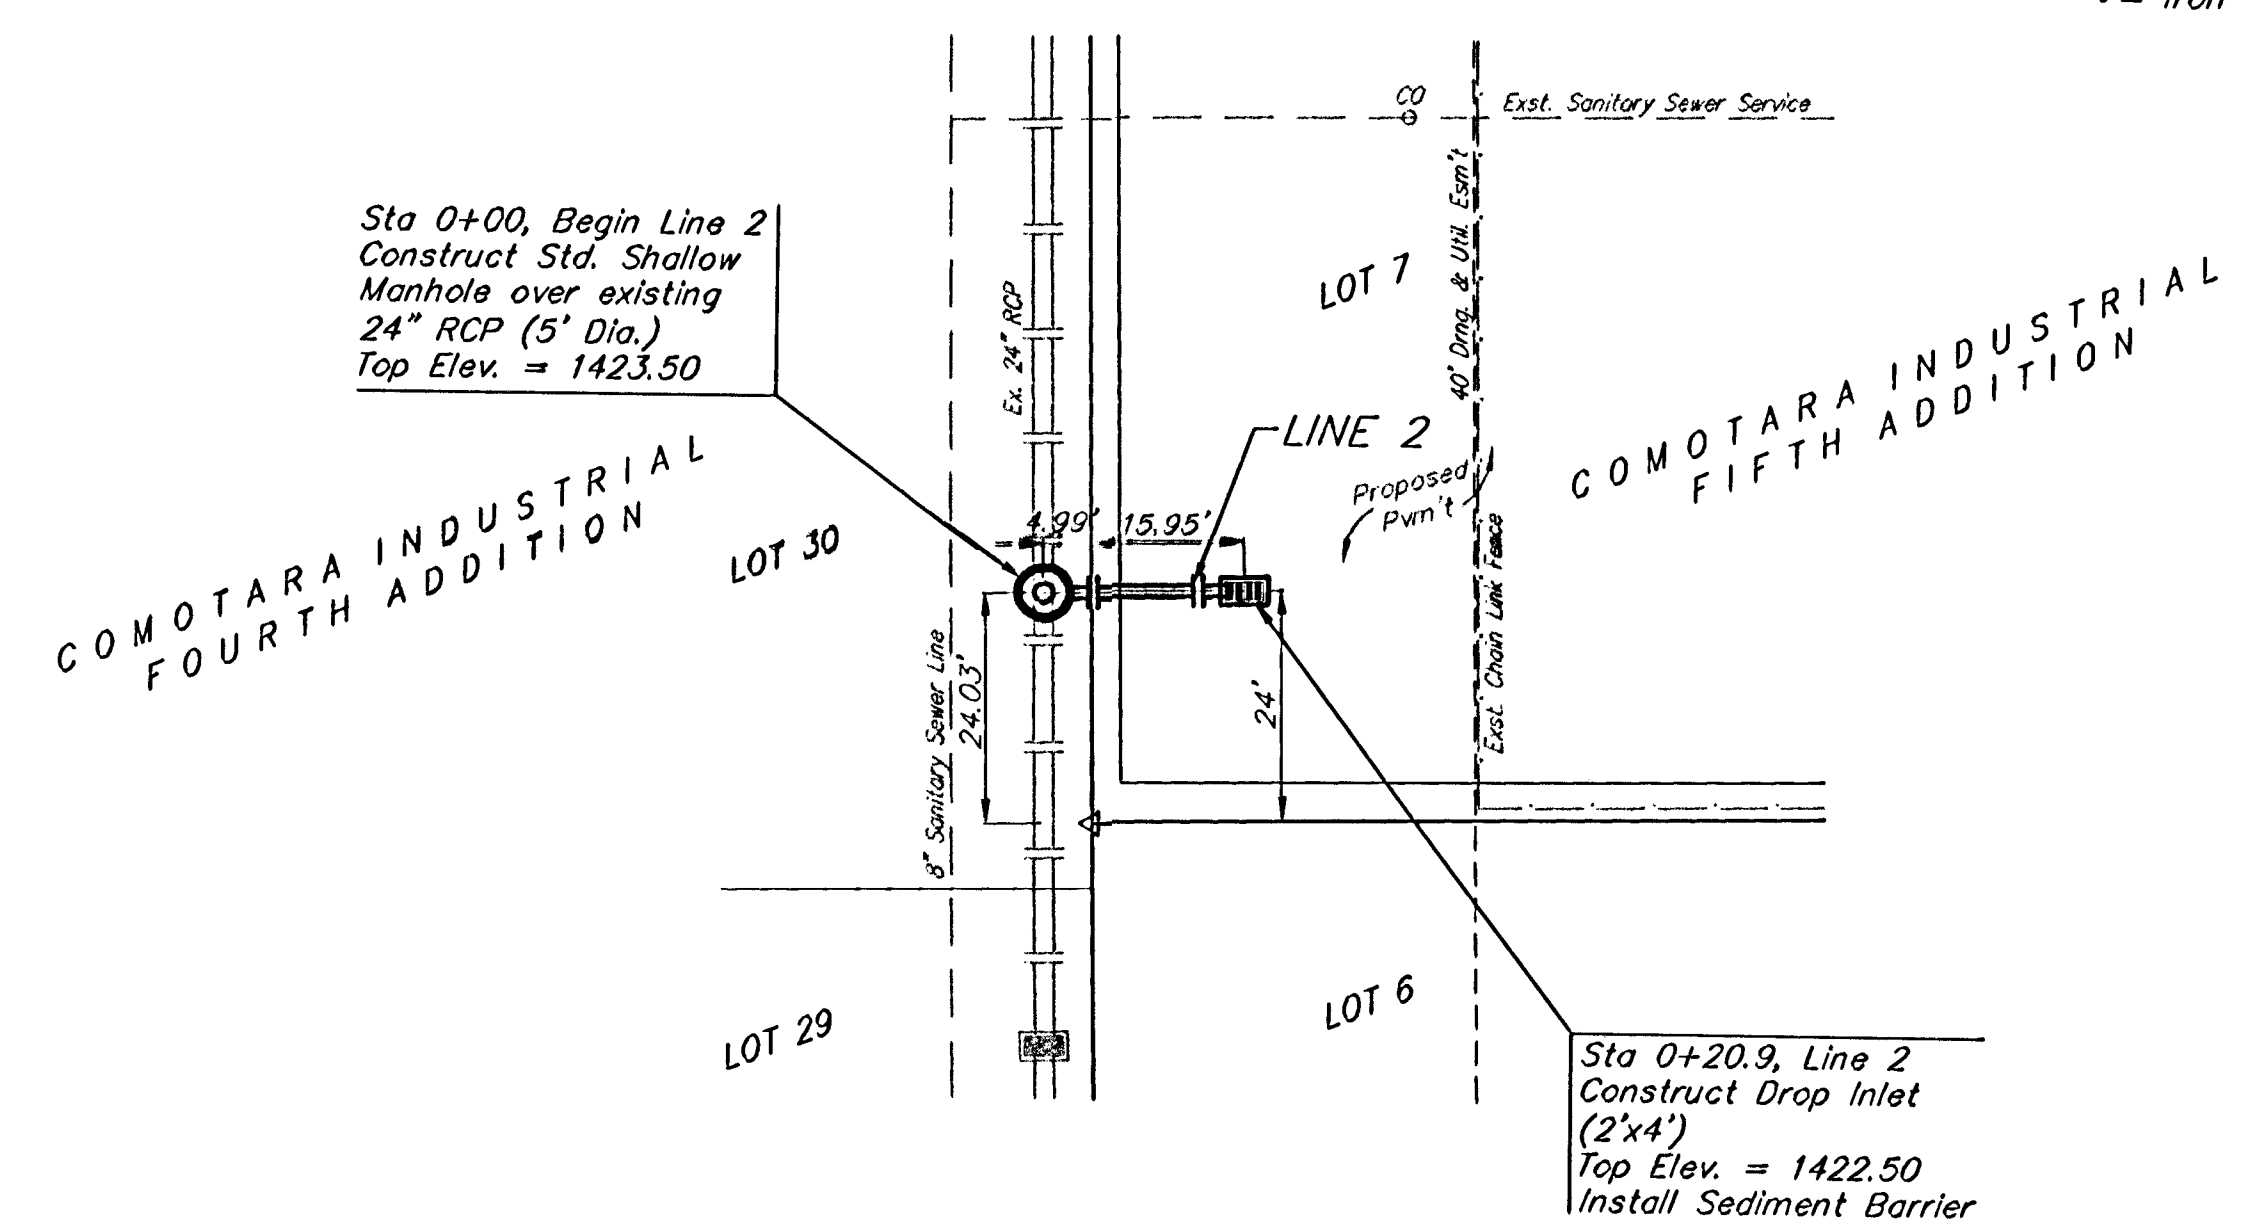

As Built 3/22/07 KIC

McCullough Excavation Shop Expansion
Lines 1 & 2
Storm Water Sewer Improvements

Baughman Company, P.A. 315 Ellis St. Winton, NJ 07091 P3162627111 P3162627112 P3162627113	
ENGINEERING SURVEYING PLANNING LANDSCAPE ARCHITECTURE	
PROJECT NUMBER 1731 PPS (607861)	DESIGN RDM/MWS
REVISIONS:	DRAWN RDM
	APPROVED MWS
	DATE 01/11/2007
	SCALE Noted
	SHEET 2 OF 6

McCullough Shop Exp SWS1.dwg 0612.E098