


SANITARY SEWER PLANS FOR
SALVATION ARMY
HIAWATHA CAMPUS

LINE 1
SHEET TITLE
06635
PROJECT NUMBER

SRS
DESIGN BY
DM
DRAWN BY
MAB
CHECKED BY

ISSUED
December 2006
REVISED
2/28/07 PROFILE RAISE 2';
REMOVE FLOWABLE FILL

SHEET NO.
5 of 10

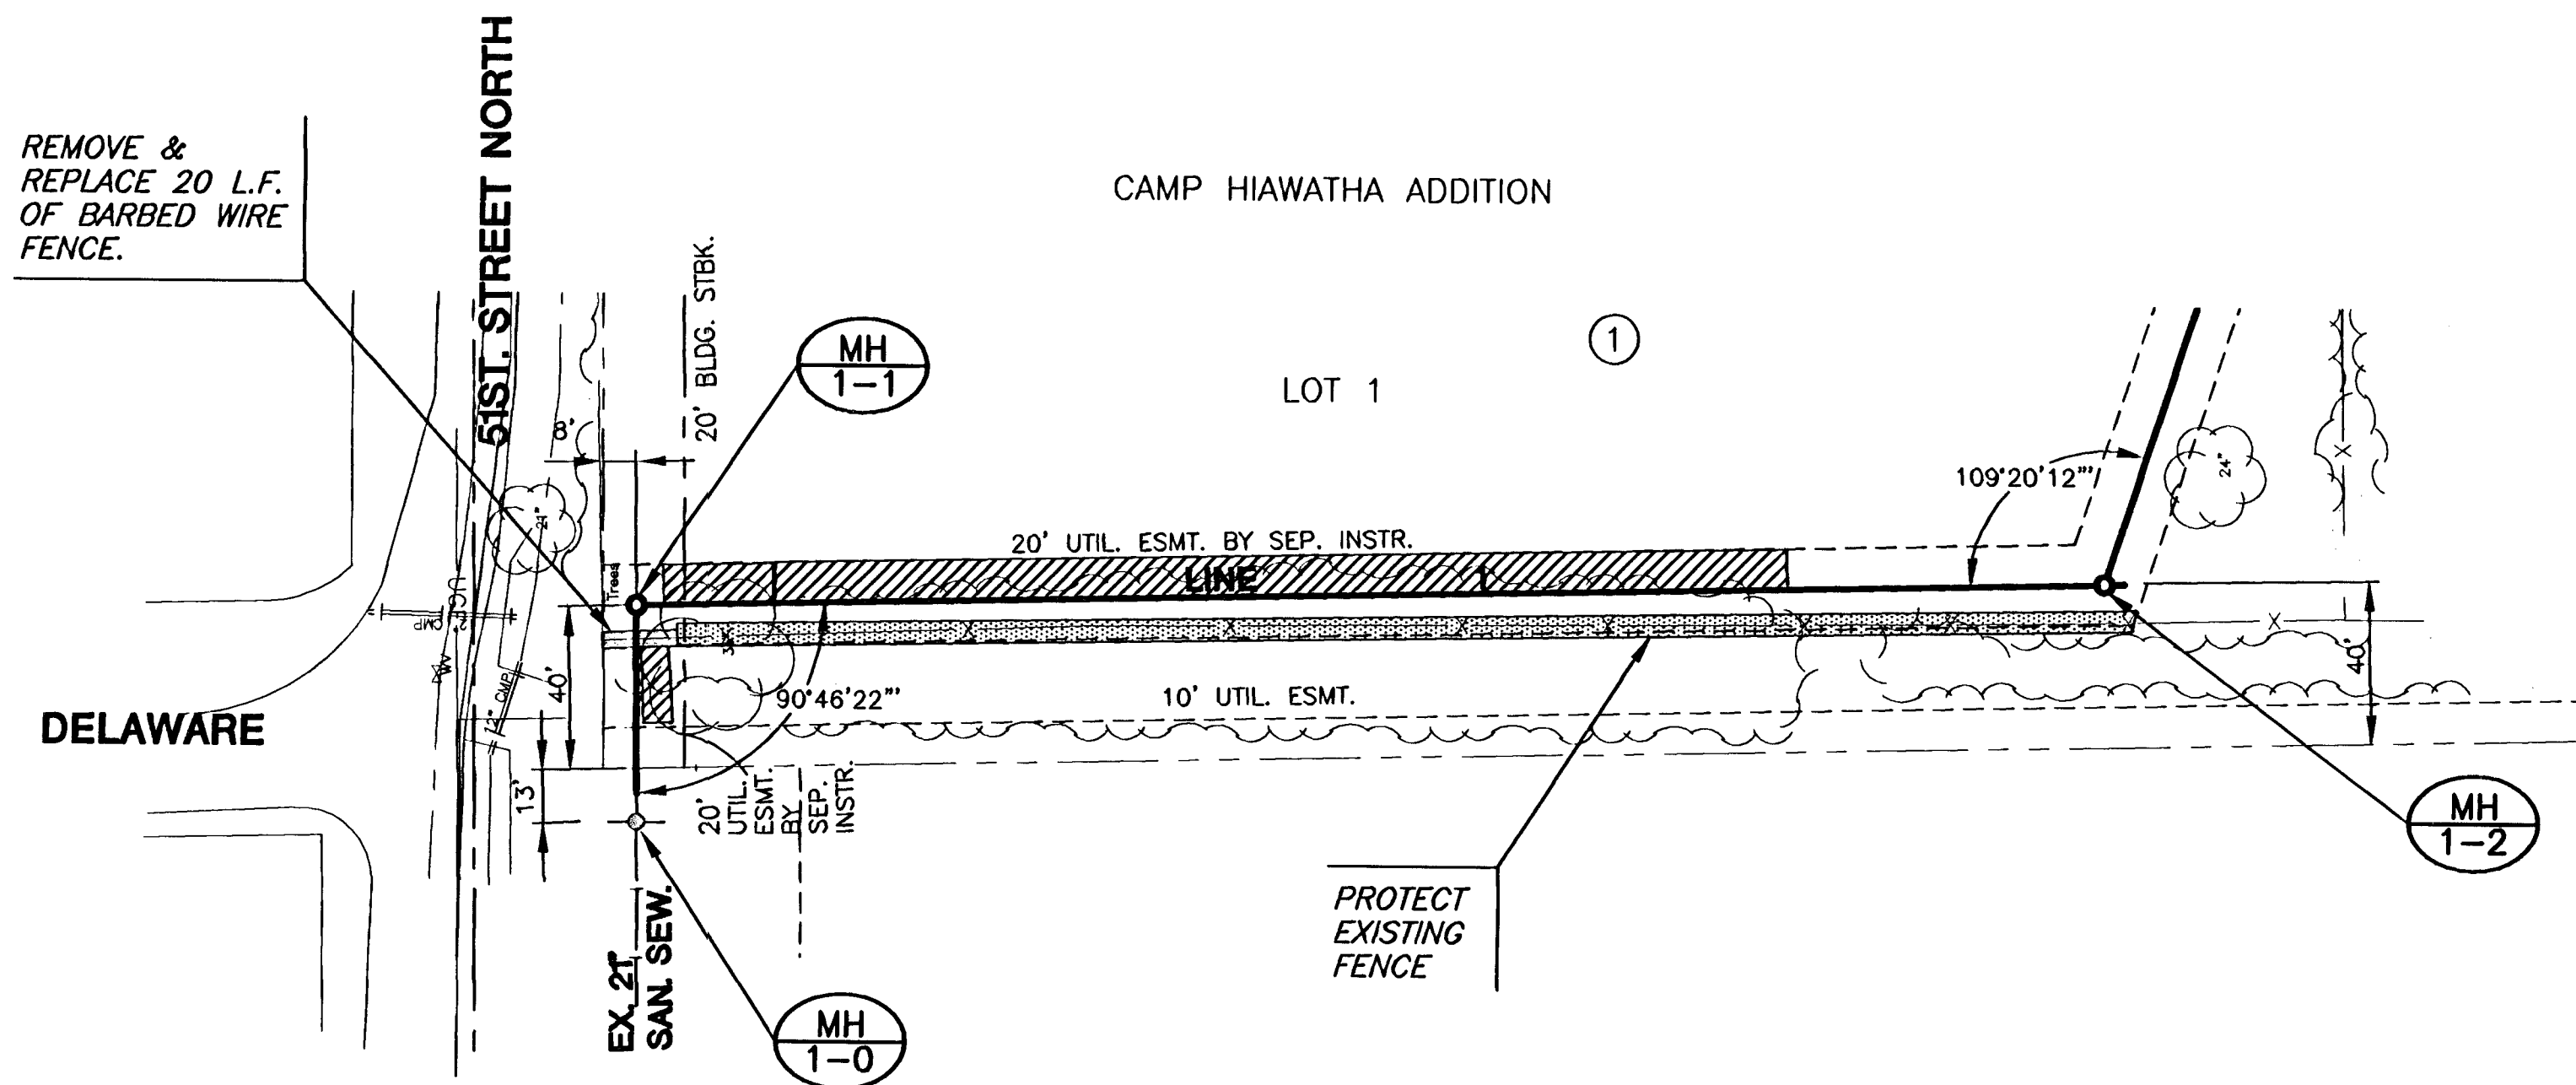

PLAN LINE 1

/// = TREE TRIMMING

AS-BUILT APRIL 2007

