

AS-BUILT APRIL 2007

MKEC
ENGINEERING
CONSULTANTS, INC.
411 N. WEBB ROAD
WICHITA, KS. 67206
316-684-9600

SANITARY SEWER PLANS FOR
SALVATION ARMY
HIAWATHA CAMPUS

LINE 1


SHEET TITLE
06635
PROJECT NUMBER

ISSUED
December 2006
DESIGN BY
DM
DRAWN BY
MAB
CHECKED BY


REVIS
**2/28/07 PROFILE RAISE 2';
REMOVE FLOWABLE FILL**

SHEET NO.

6 of 10

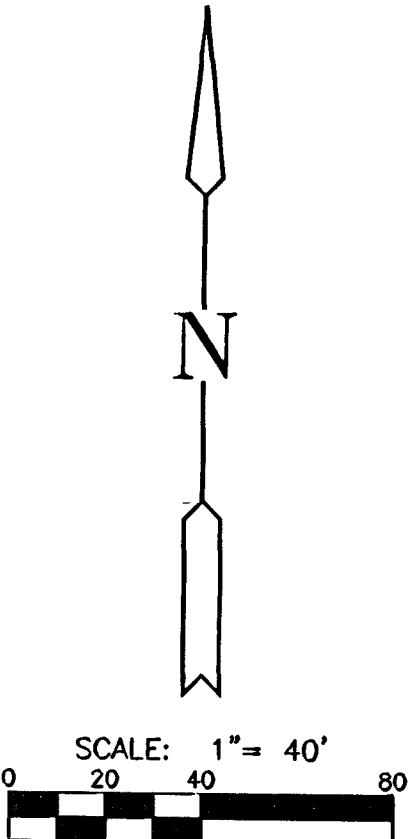


- [Hatched box] = FENCE REMOVAL
- [Solid black box] = PROPOSED SIDEWALK
- [Dotted box] = PAVEMENT REMOVAL
- [Diagonal lines] = TREE TRIMMING
- [Circle with X] = TREE REMOVAL

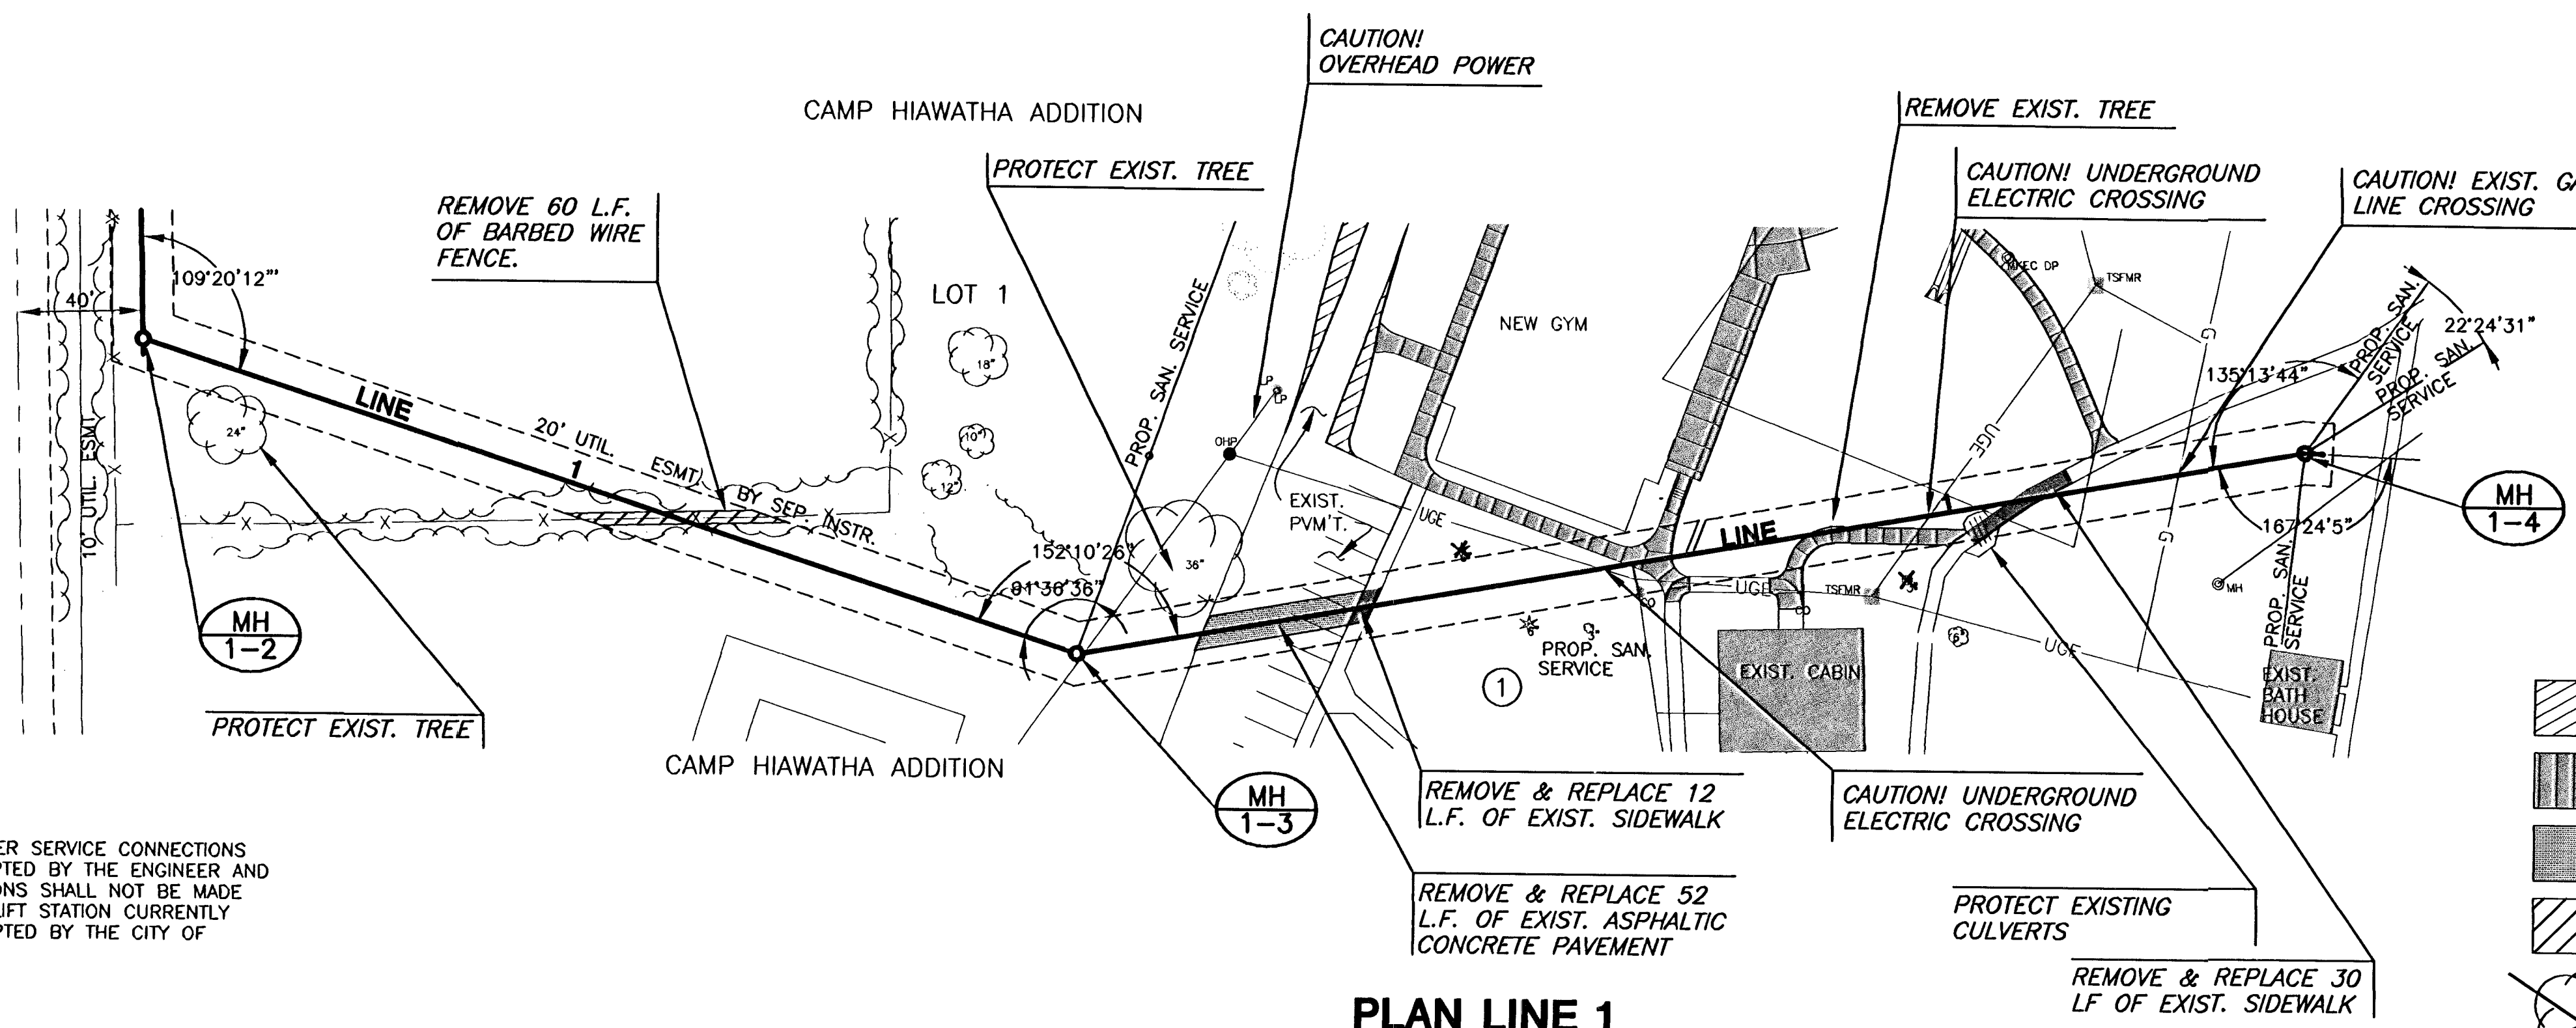

PLAN LINE 1

PROFILE LINE 1

SCALE: HORIZ. 1"=40'
SCALE: VERT. 1"=6'

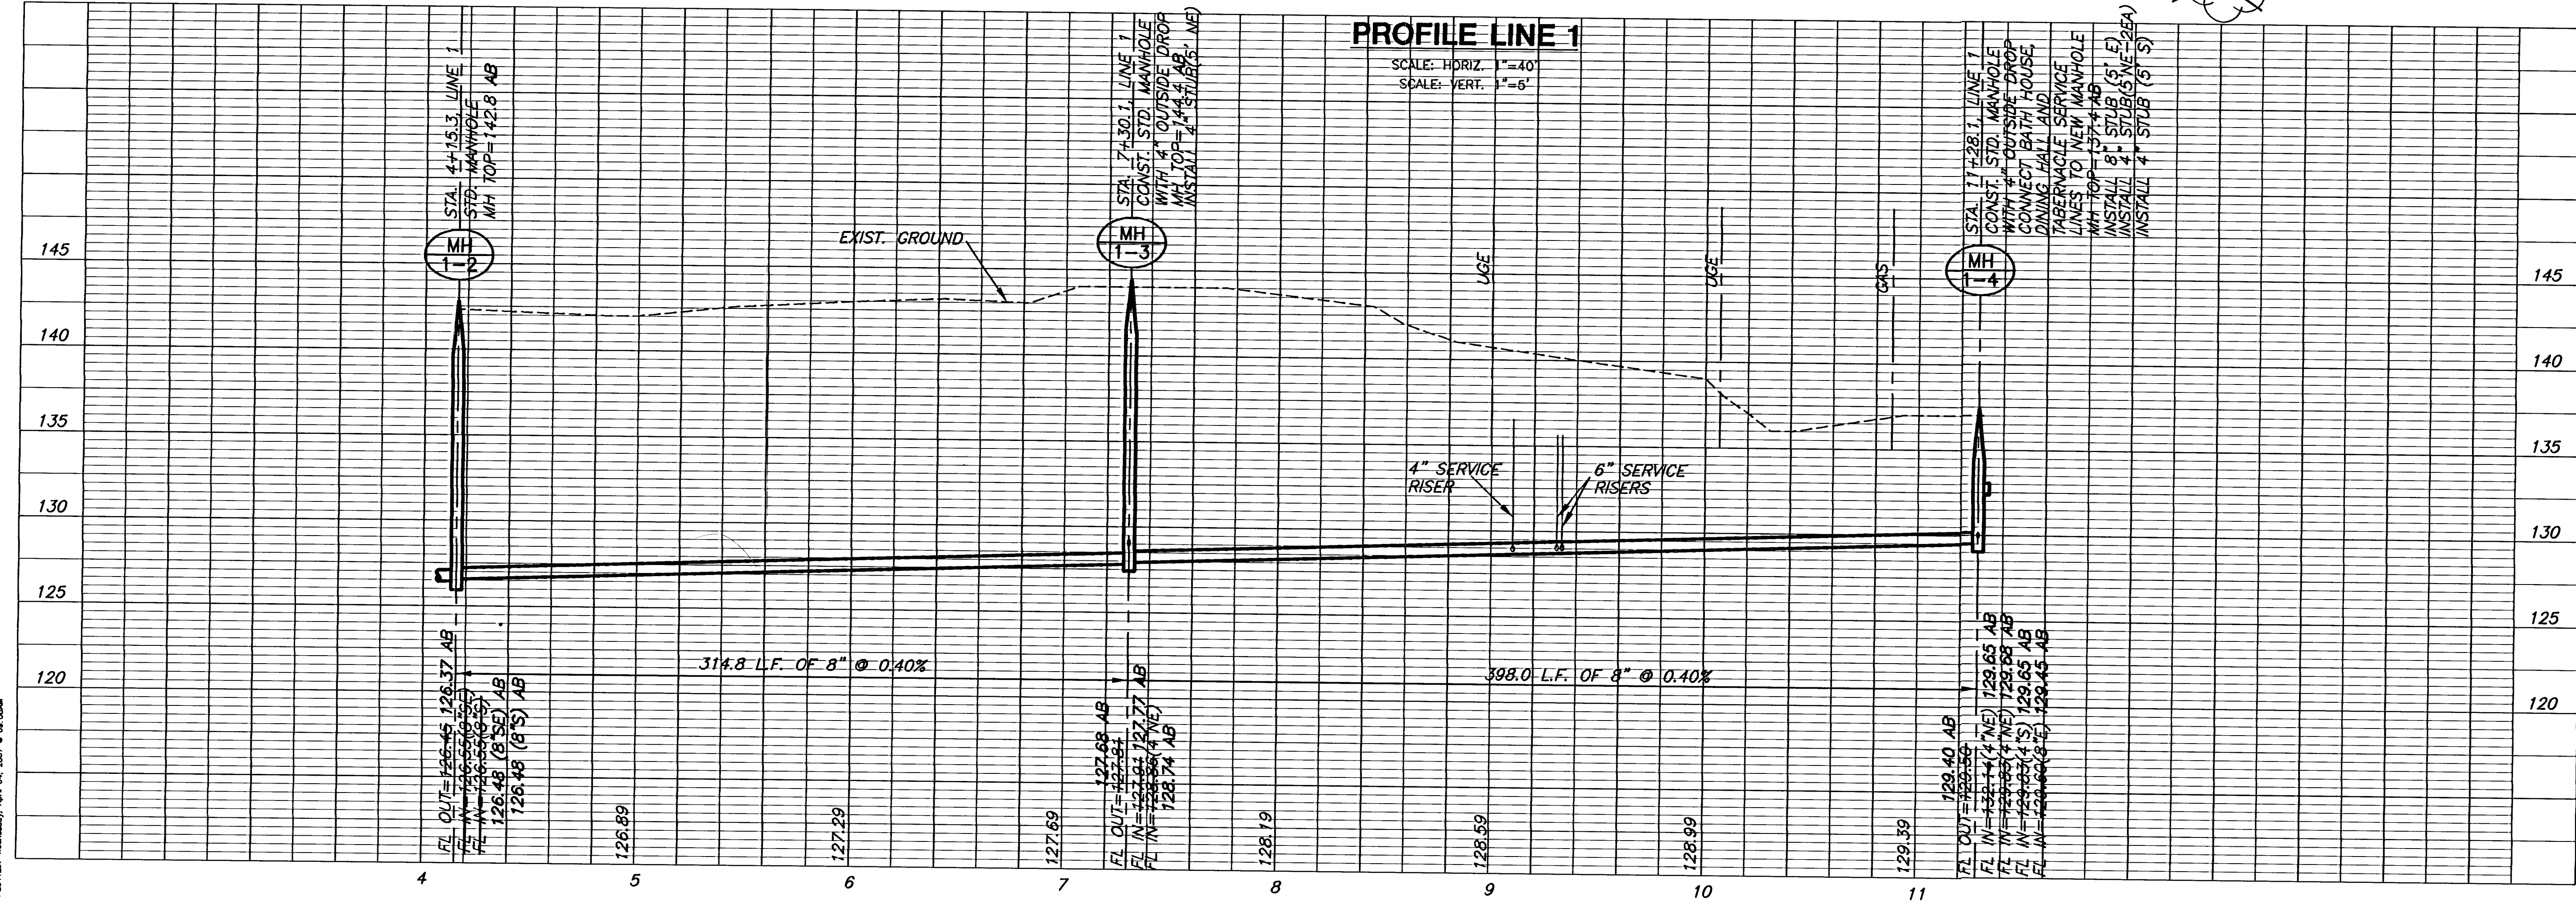

NOTE:
CONTRACTOR SHALL NOT MAKE ANY SANITARY SEWER SERVICE CONNECTIONS
UNTIL SEWER MAINS HAE BEEN TESTED AND ACCEPTED BY THE ENGINEER AND
THE CITY OF WICHITA. SEWER SERVICE CONNECTIONS SHALL NOT BE MADE
UNTIL THE NORTHWEST INTERCEPTOR SEWER AND LIFT STATION CURRENTLY
UNDER CONSTRUCTION ARE COMPLETED AND ACCEPTED BY THE CITY OF
WICHITA.

PLOTTED: Wednesday, April 04, 2007 9:06:00AM

J:\CWL\06635\DWG\SAN\AS-BUILT\06635B2.DWG