

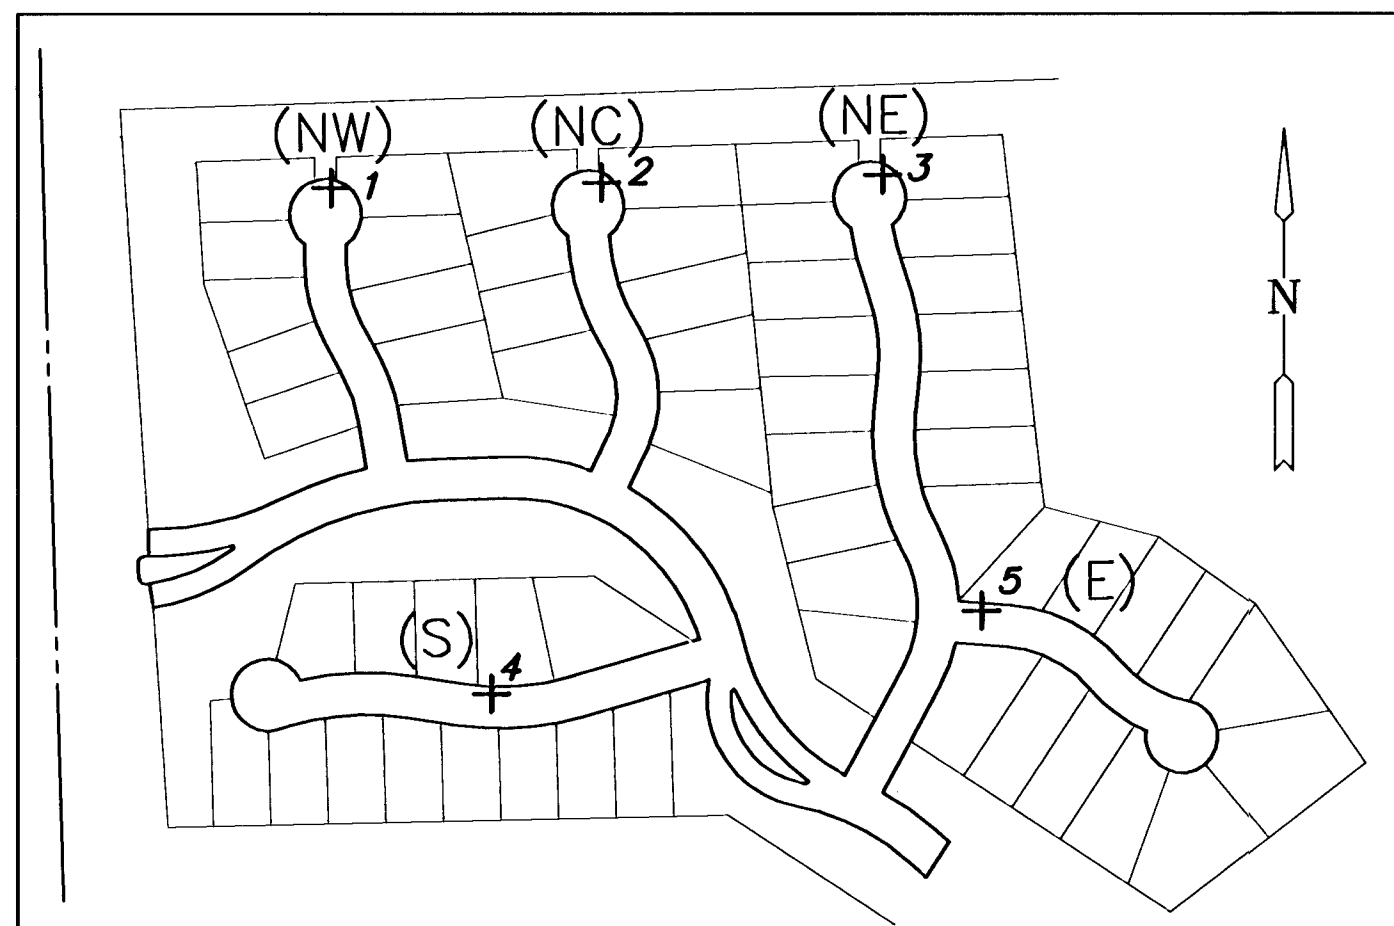


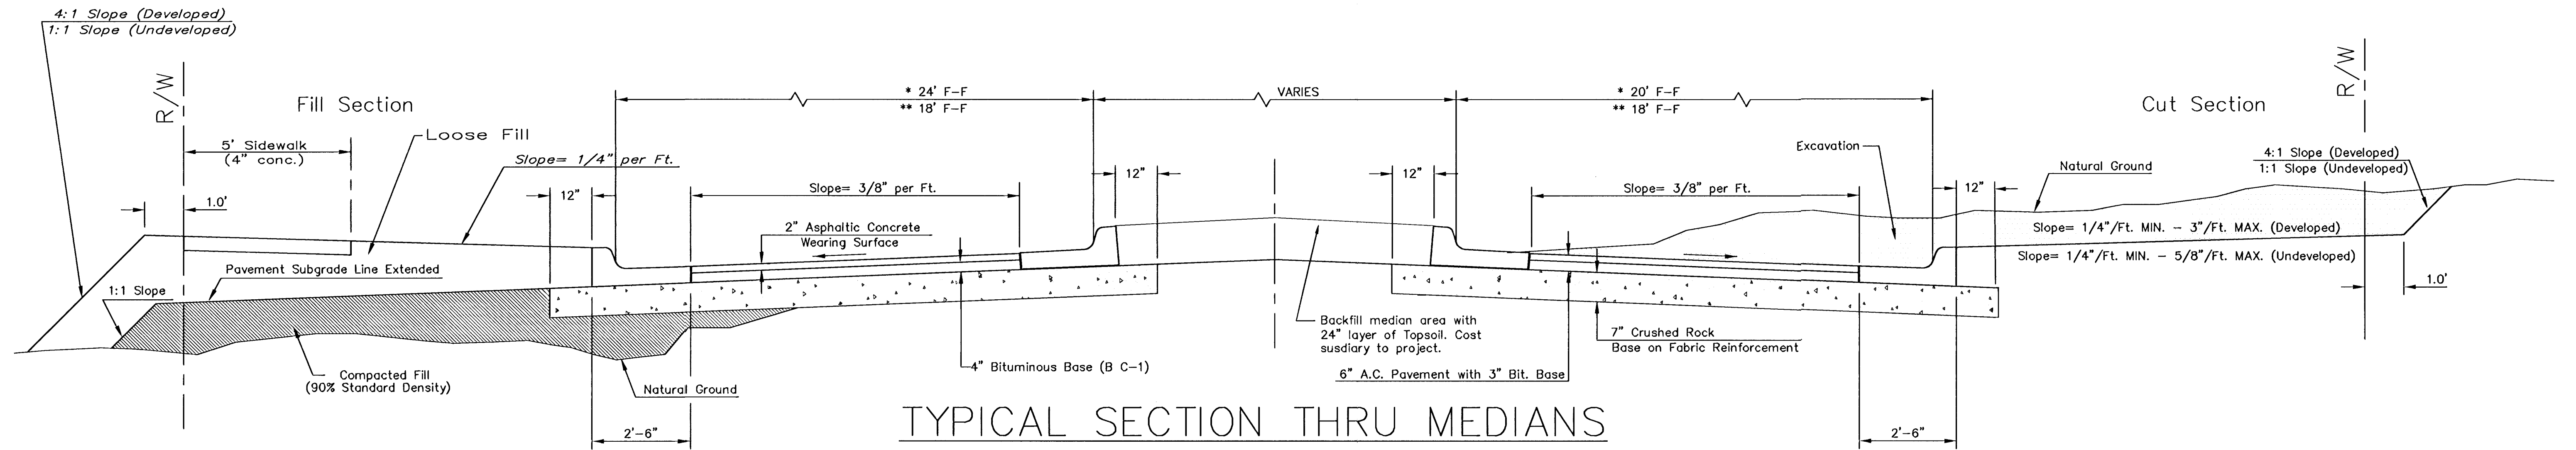

SUBDIVISION BENCH MARK LOCATION MAP



SUBDIVISION BENCH MARKS				
NO.	STREET	FROM CL	DESCRIPTION	ELEVATIONS
1	WESTLAKES CT (NW), STA. 4+29.28	5.0' RT	SE SIDE OF INLET HOOKUP, END OF CUL DE SAC	165.58
2	WESTLAKES CT (NC), STA. 4+66.32	5.0' RT	SE SIDE OF INLET HOOKUP, END OF CUL DE SAC	165.34
3	WESTLAKES CT (NE), STA. 9+22.58	5.0' RT	SE SIDE OF INLET HOOKUP, END OF CUL DE SAC	165.27
4	WESTLAKES CT (S), STA. 0+31.52	14.5' LT	TOP OF CURB AT NE END OF RETURN, STA. 0+31.52	166.94
5	WESTLAKES CT (E), STA. 3+21.58	14.5' RT	SE SIDE OF INLET HOOKUP, STA. 3+21.58	166.77

NOTE:
 CONTRACTOR SHALL INSTALL SUBDIVISION BENCH MARKS ("FLAT SURVEY MARKERS NO. 8134-08 3" TOP DIAMETER" PROVIDED BY KANSAS BLUE PRINT CO., INC.) COSTS TO BE CONSIDERED SUBSIDIARY TO CONSTRUCTION OF COMBINED CURB AND GUTTER.

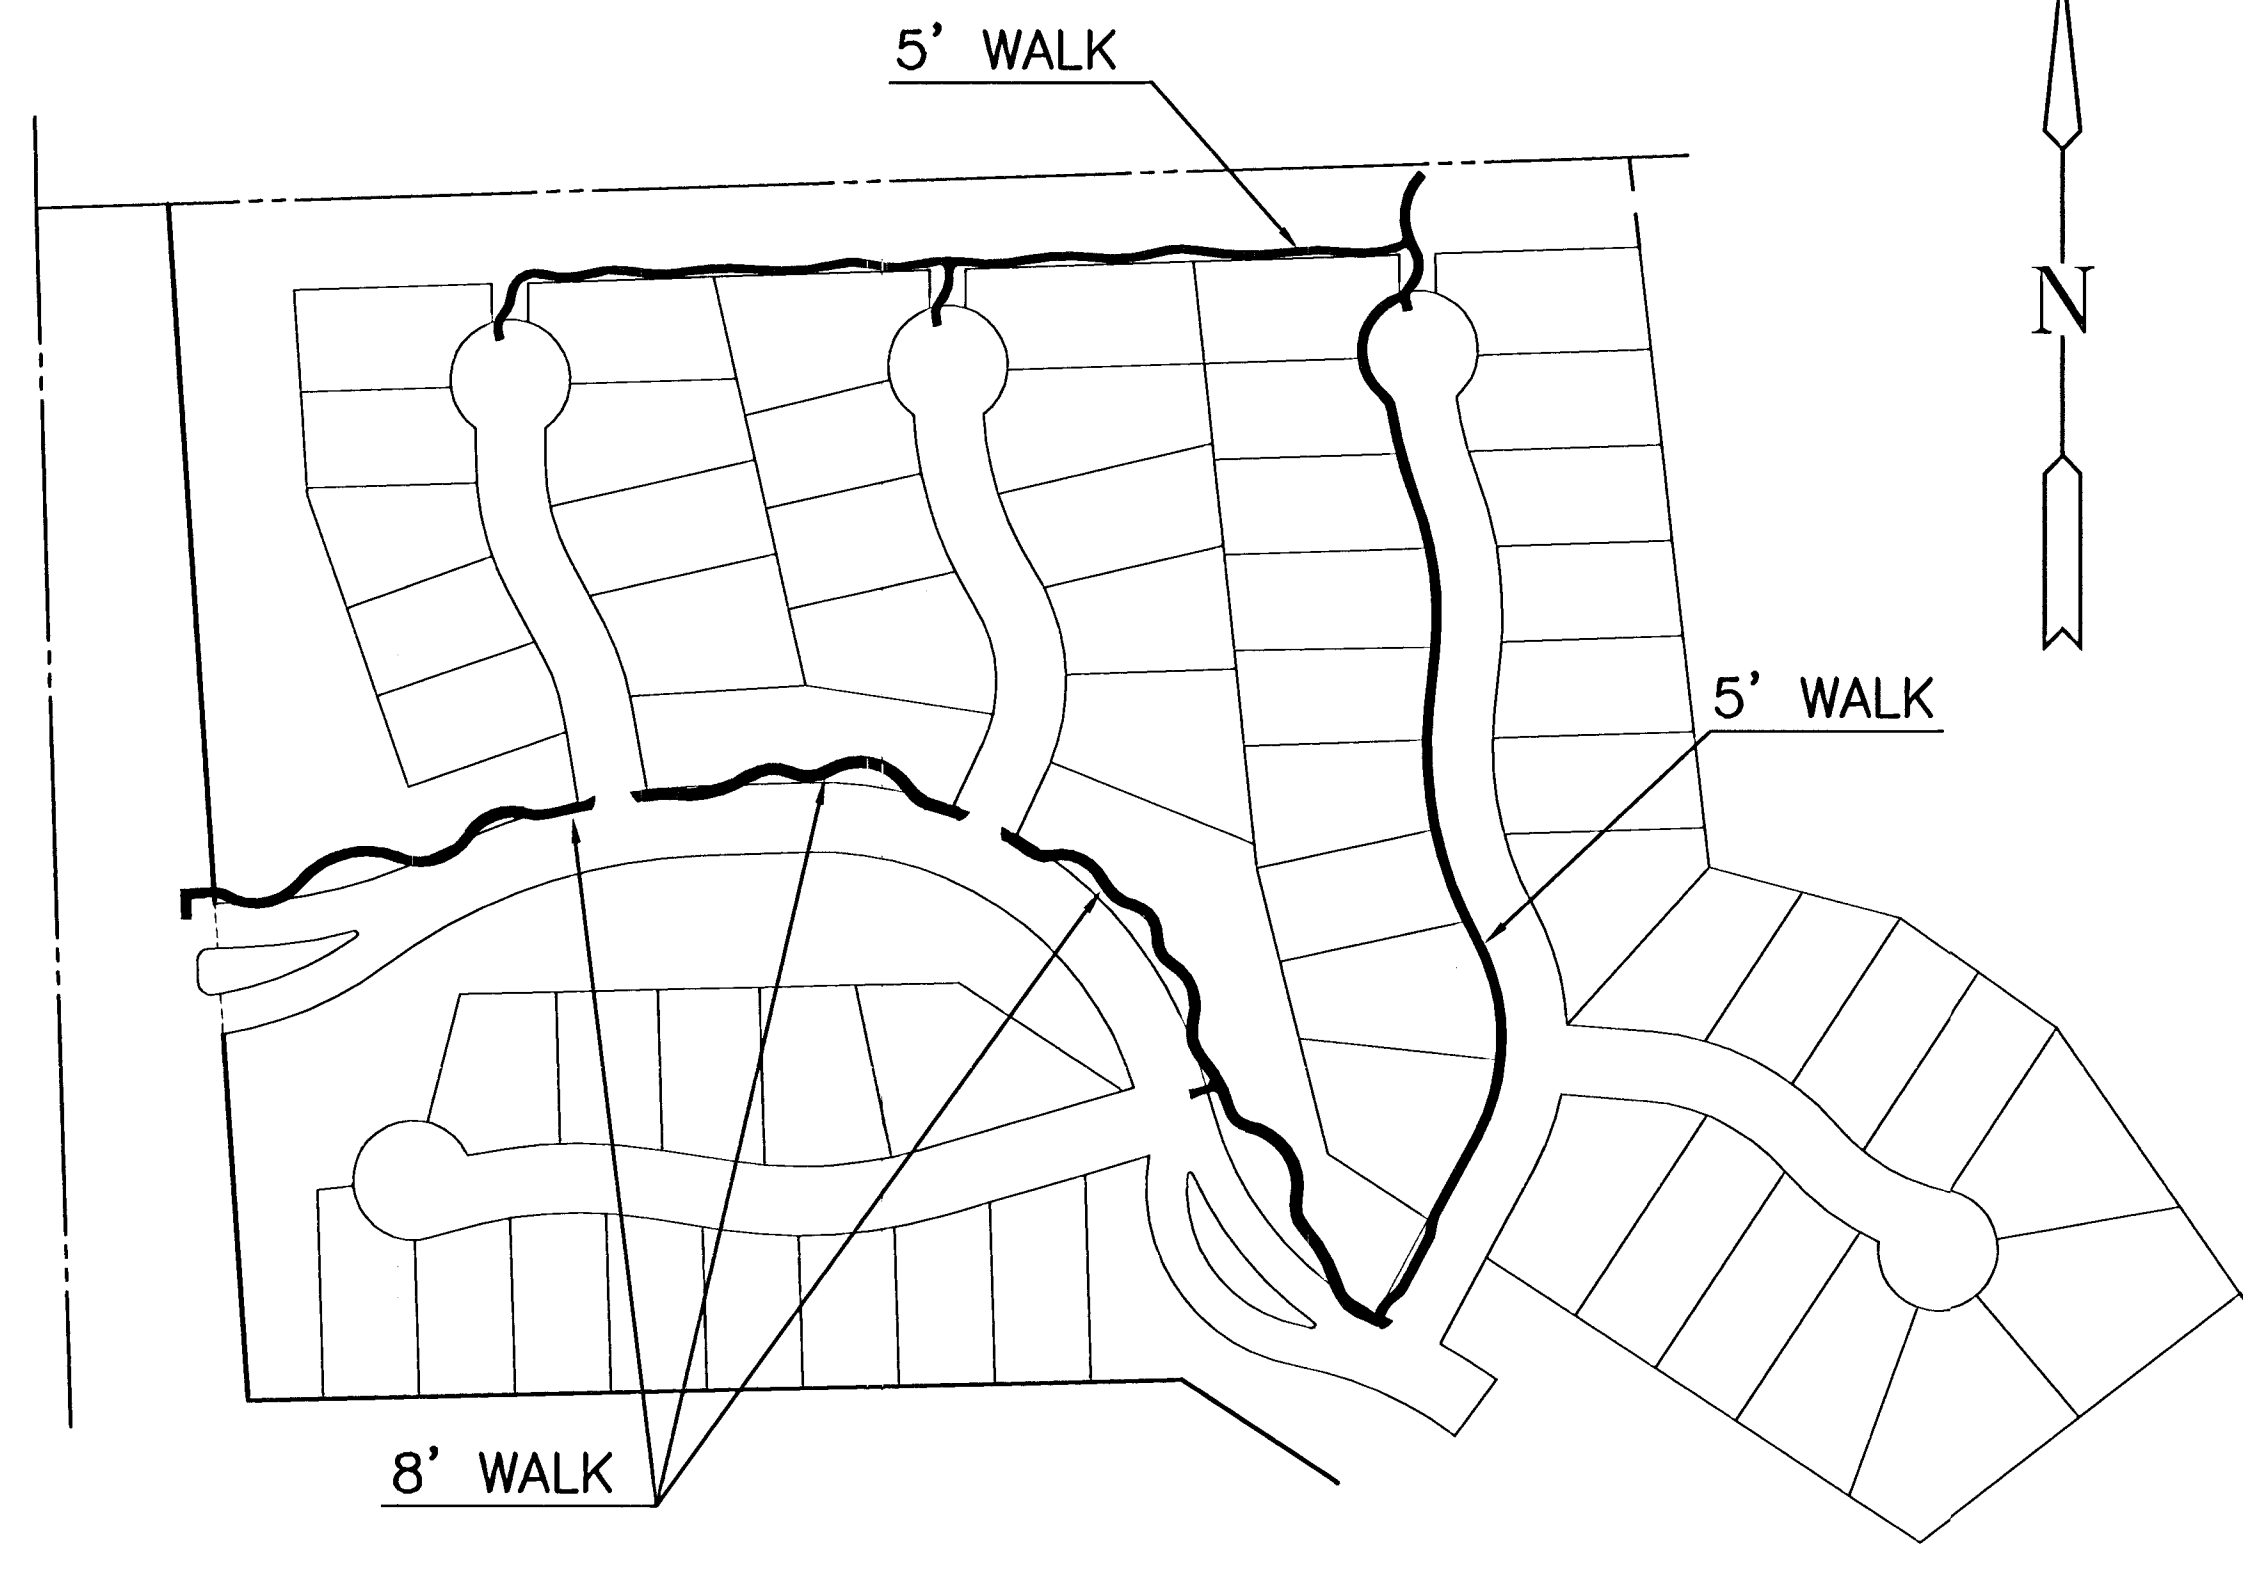

SIDEWALK LOCATION MAP

SIDEWALK ALIGNMENT TO BE APPROVED BY MKEC LANDSCAPE ARCHITECT. CONTRACTOR SHALL EXPECT TO COMPLETE FINAL GRADING AND SHAPING OF SIDEWALK ALIGNMENT ALONG BERM AND ALONG THE NORTH EDGE OF THE PROJECT. CONTRACTOR SHALL BE REQUIRED TO VERIFY AND CONSTRUCT MAXIMUM 5% GRADE FOR LONGITUDINAL GRADE OF SIDEWALK AND 2% MAXIMUM CROSS SECTIONAL GRADE. CONTRACTOR SHALL ALSO BE RESPONSIBLE FOR BLENDING BERM GRADING INTO EDGES OF SIDEWALK. ALL COST SHALL BE SUBSIDIARY TO SIDEWALK CONSTRUCTION.

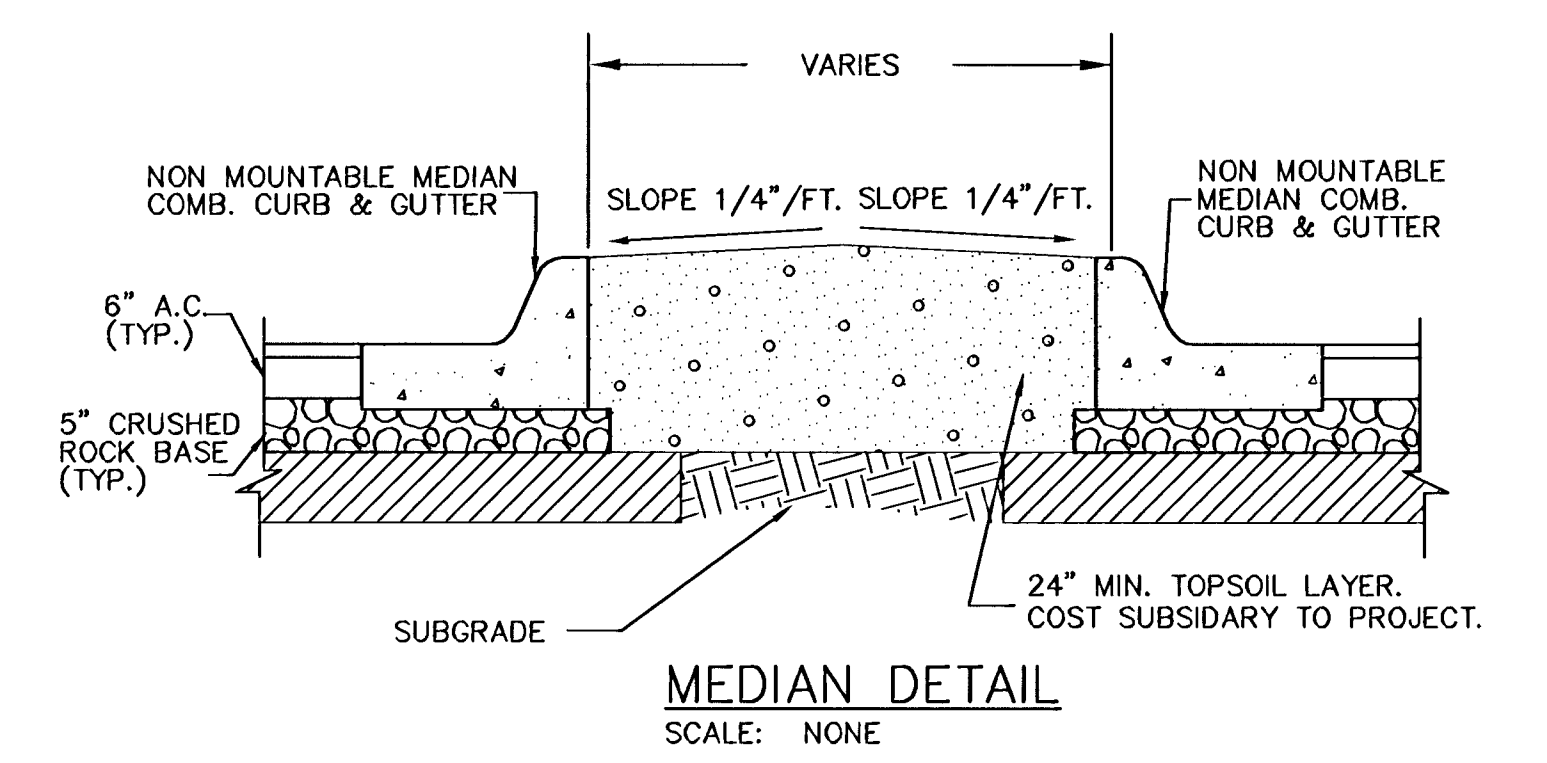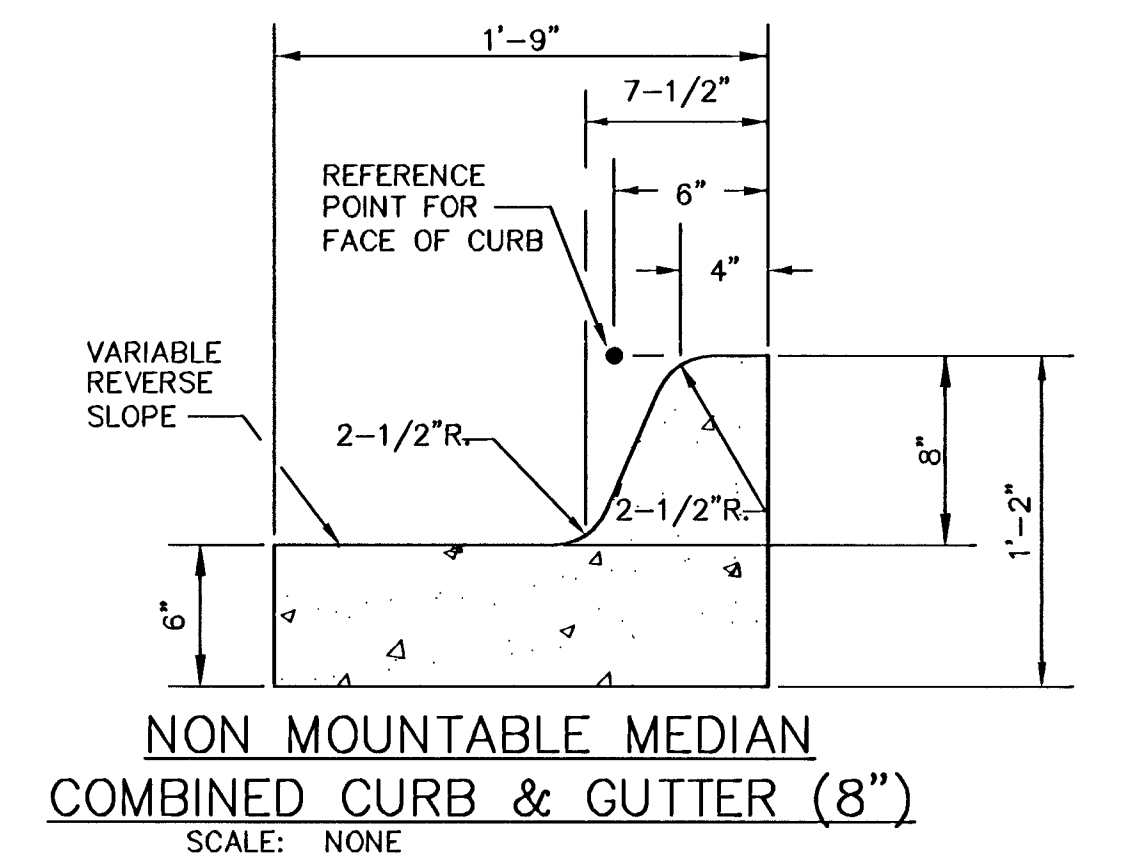

AS-BUILT JUNE 2005

G:\CIVIL\99118\dwg\PAV\PH_8\as-built\99118ED6.dwg

MKEC
 ENGINEERING
 CONSULTANTS
 411 N. WEBB ROAD
 WICHITA, KS. 67206
 316 - 684 - 9600

FOX RIDGE ADDITION
 PROJECT NAME

PAVING DETAILS
 SHEET TITLE

DK DESIGN BY. DM DRAWN BY. DK CHECKED BY.
 SEPTEMBER 2004 99118ED6 5 / 50
 DATE JOB NO. SHEET/OF