



OLD TOWN PARKING DISTRICT PARKING LOTS #9 AND #10

SRB

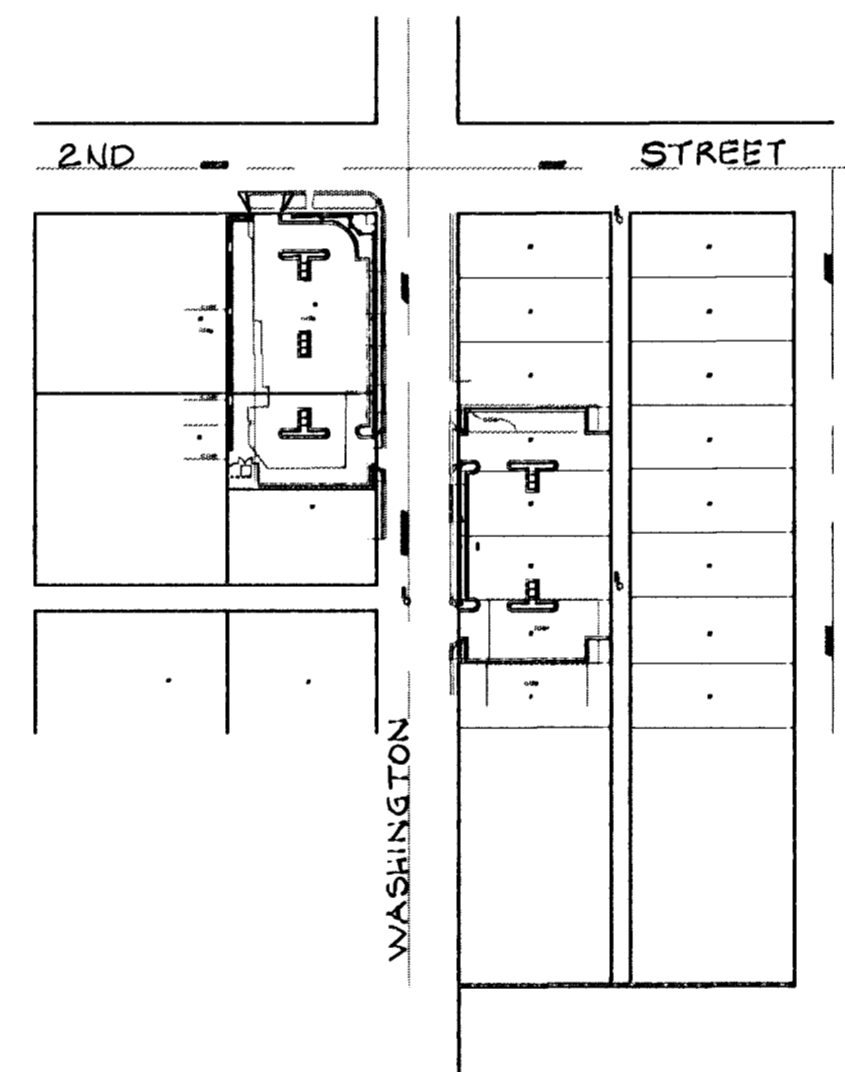

INDEX OF SHEETS

- 1. TITLE SHEET
- 2. GENERAL NOTES & DETAILS
- 3. TYPICAL SECTIONS
- 4. SCREEN WALL DETAILS
- 5. PLAN - LOT #9
- 6. PLAN - LOT #10
- 7-10. LIGHTING PLANS & DETAILS
- 11-12. LANDSCAPE PLANS & DETAILS
- 13-14. IRRIGATION PLANS & DETAILS (NOT INCLUDED)

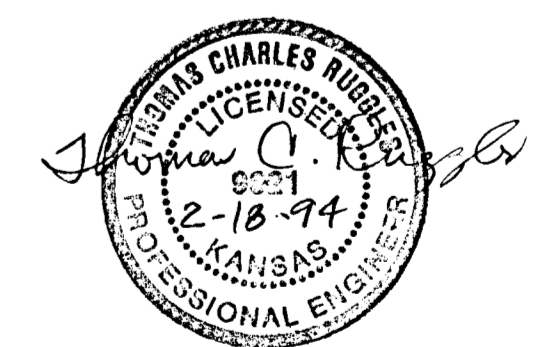

CITY OF WICHITA, KANSAS
MICHAEL E. LINDEBAK - CITY ENGINEER

RECORD COPY REVISED 7-11-94

SRB	841 SOUTH HILLSIDE WICHITA, KANSAS 67211	316-652-7754 FAX 652-7932
SAVOY, RUGGLES & BOHM, P. A. ENGINEERING & SURVEYING		