


BENCH MARK #2: "□" cut on top of curb @ West end of
return, NW corner of 2nd St. & Mosley Elev. 111.16

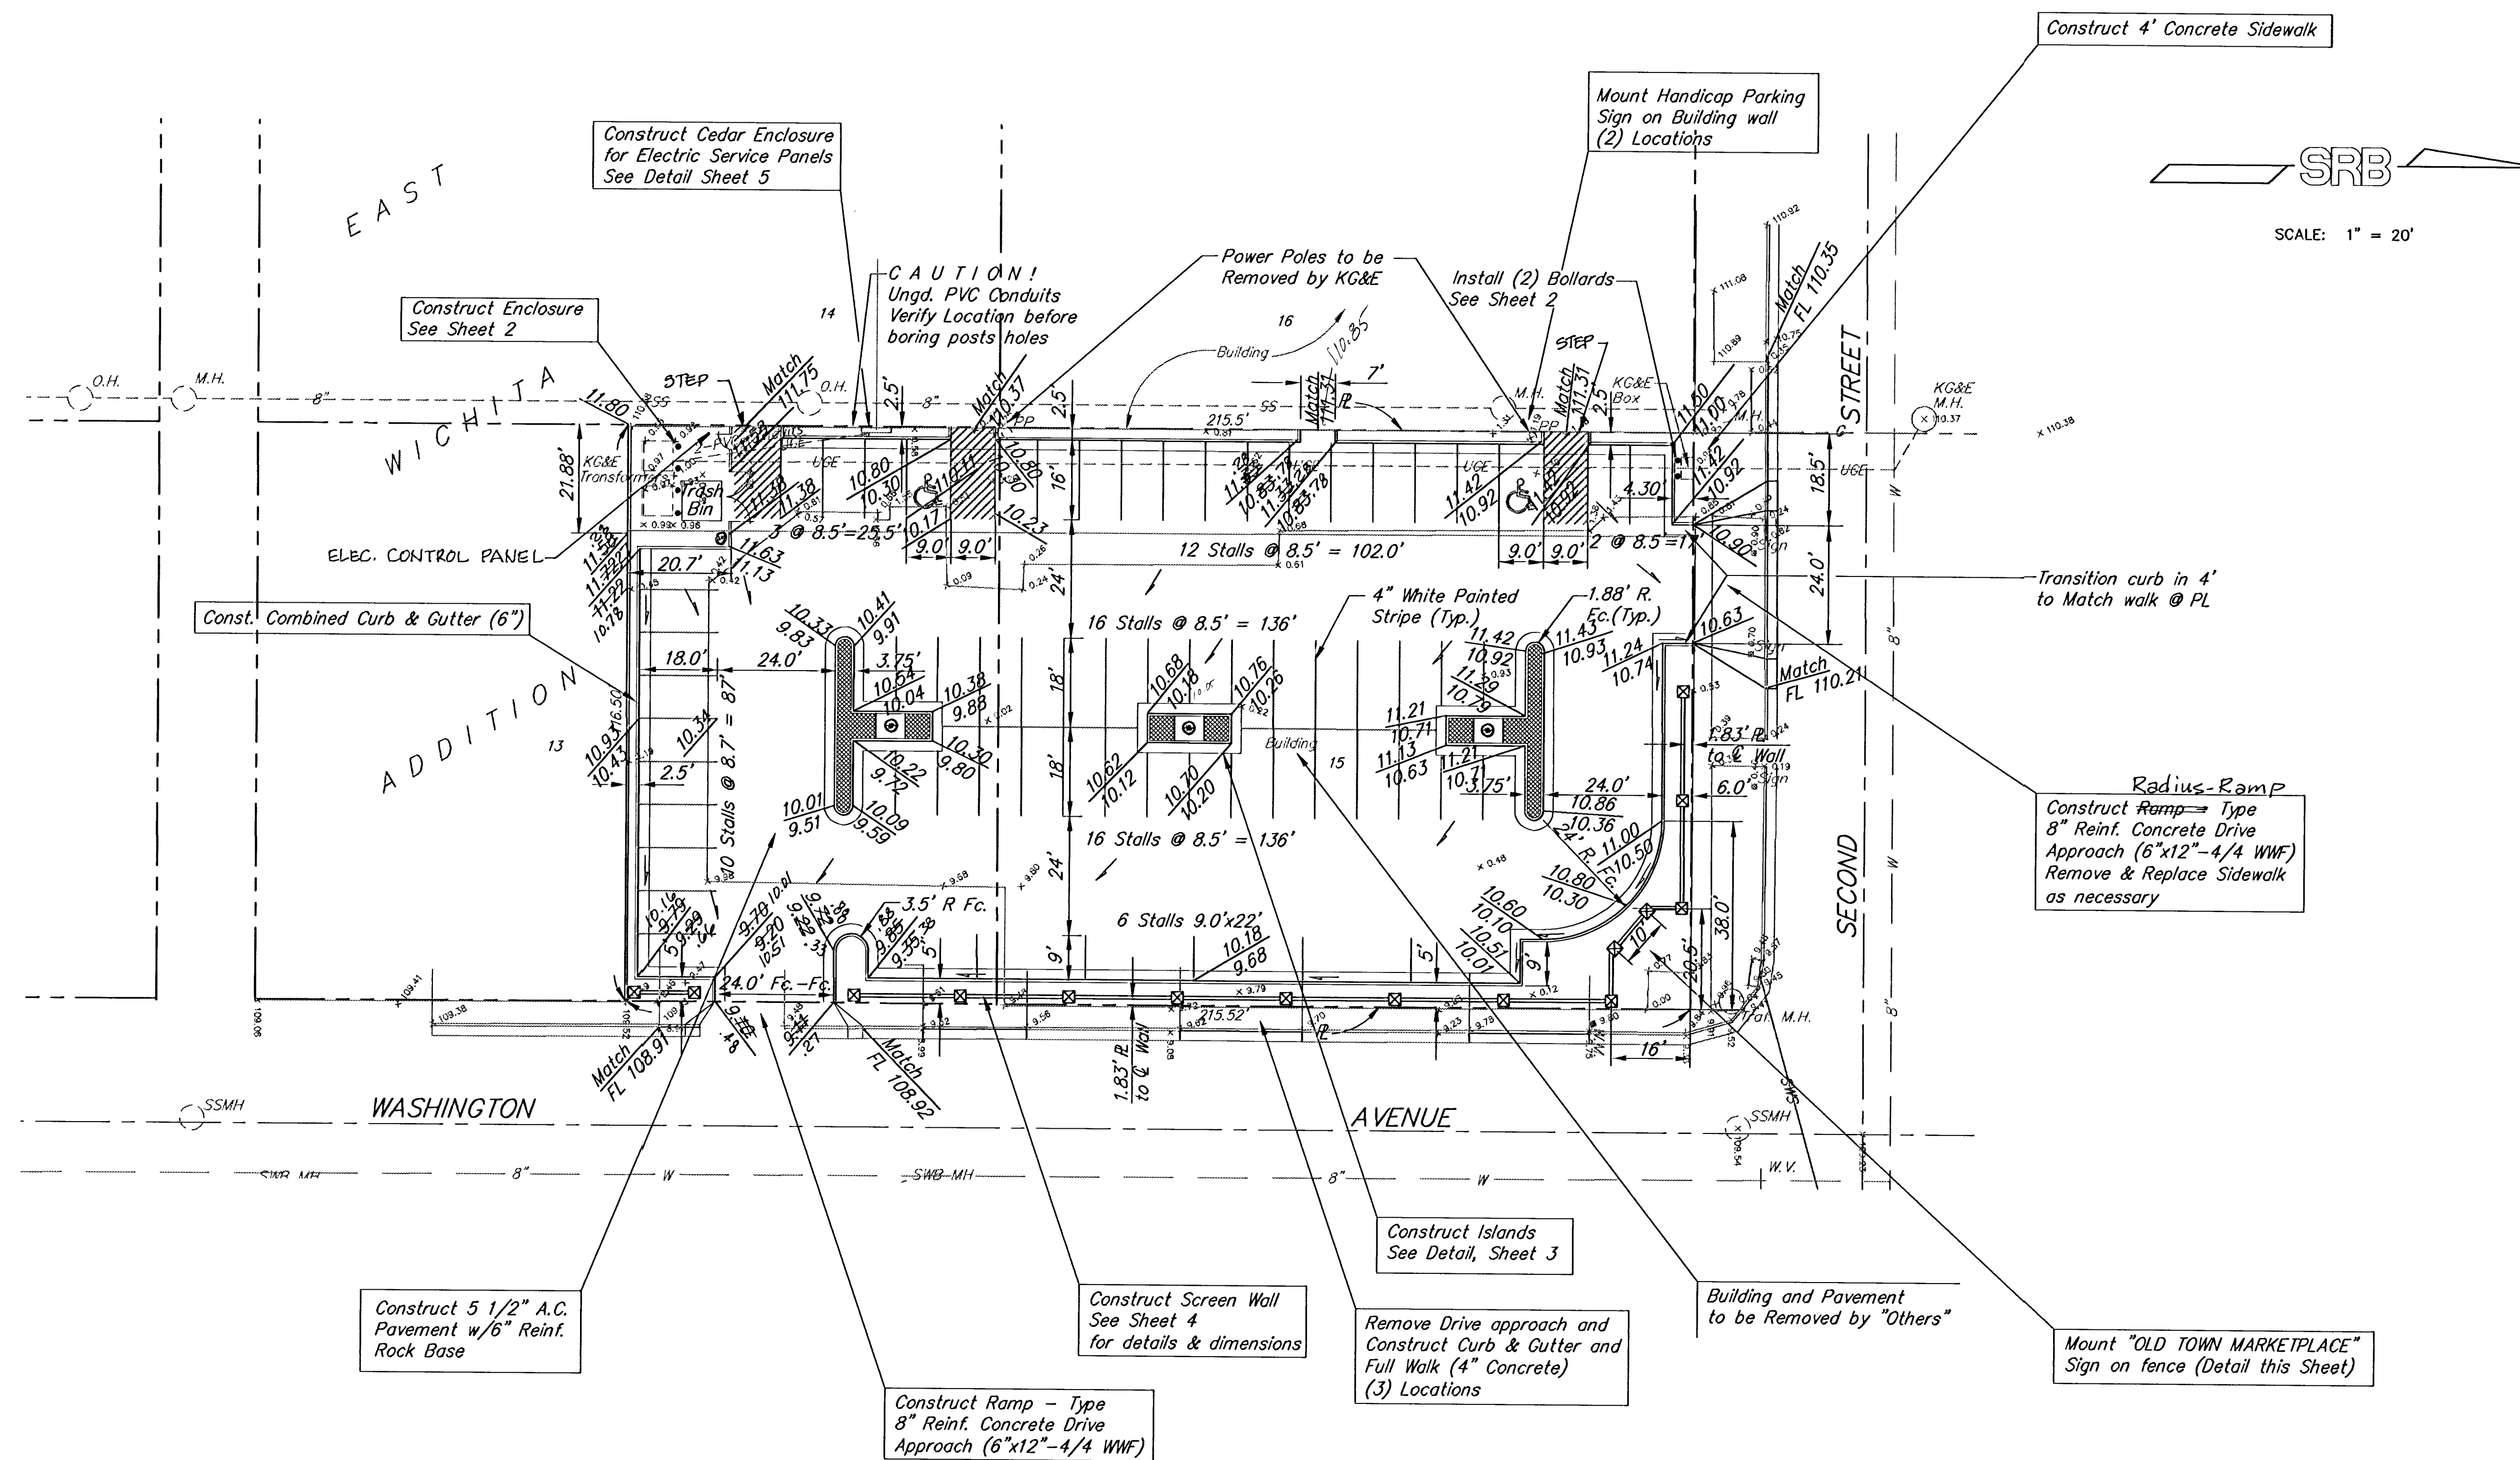

NOTE:
Dimensions are to face of curb except where noted otherwise.

LEGAL DESCRIPTION:
The North 25 feet of Lot 13 and the South 50 feet of the North 1/2 of Lot 13; and all of Lot 15, in East Wichita Addition, City of Wichita, Sedgwick County, Kansas, on Washington Avenue.

*SITE PLAN – PARKING LOT #1
OLD TOWN PARKING DISTRICT*

SRB 841 SOUTH HILLSIDE 316-652-7755
WICHITA, KANSAS 67211 FAX 652-7931

SAVOY, RUGGLES & BOHM, P. A.
ENGINEERING & SURVEYING

DRAWN <i>T. Brooks</i>	DESIGN <i>T. Ruggles</i>	REVIEW	DATE <i>2-23-94</i>	UTILITY	SRB JOB <i>101E</i>
---------------------------	-----------------------------	--------	------------------------	---------	------------------------

REVISED 7-11-94
RECORD COPY