




INDEX OF SHEETS

1. TITLE
2.-3. TYPICAL SECTIONS
4.-8. PLAN AND PROFILES
9.-11. INTERSECTION DETAILS
12.-13. CONCRETE PAVEMENT DETAILS
14. CURB & GUTTER DETAILS
15. ALLEY & ENTRANCE PAVEMENT
16. SIDEWALK
17. TYPE 10 CURB INLET
18. TYPE 12 CURB INLET
19. REINFORCED CONCRETE MANHOLE
20. PRECAST MANHOLES
21. MANHOLE FRAME AND COVER DETAILS
22. MANHOLE ADJUSTMENT DETAILS
23. REINFORCED STEEL FOR INLETS
24. REINFORCED STEEL FOR MANHOLES
25.-27. STORM SEWER PROFILES
28. SCHEDULE INLETS AND MANHOLES
29. KEY MAP-WATER LINE
30. GENERAL NOTES-WATER LINE
31. WATER ASSEMBLY DETAILS
32.-36. WATER LINE PLAN AND PROFILES
37. CONCRETE END SECTIONS
38. SUMMARY OF QUANTITIES
39.-43. TEMPORARY PROJECT WATER POLLUTION CONTROL
44. SEEDING
45.-47. BEAUTIFICATION DETAILS
48. LANDSCAPE TREE PLANTER DETAILS
49. LANDSCAPE SUMMARY AND NOTES
50.-51. TRAFFIC SIGNALIZATION PLAN
52.-54. TRAFFIC SIGNAL DETAILS
55.-56. TRAFFIC SIGNAL SUMMARY
57.-62. TRAFFIC SIGNAL SPECIFICATIONS
63.-65. PAVEMENT MARKINGS & STREET LIGHTING
66. STREET LIGHTING DETAILS & SUMMARY OF QUANTITIES
67. SUMMARY OF QUANTITIES-PAVEMENT MARKING
68. SUMMARY OF QUANTITIES-SURFACING
69.-83. TRAFFIC CONTROL PLAN
84.-91. CROSS SECTIONS

Water sheets As Built &
Sent to Water Dept.
1/29/02 RDL

STA. 22+654.345 BEGIN
K.D.O.T. Project No.
87 N-0061-01


STA. 23+223.556 END
K.D.O.T. Project No.
87 N-0061-01

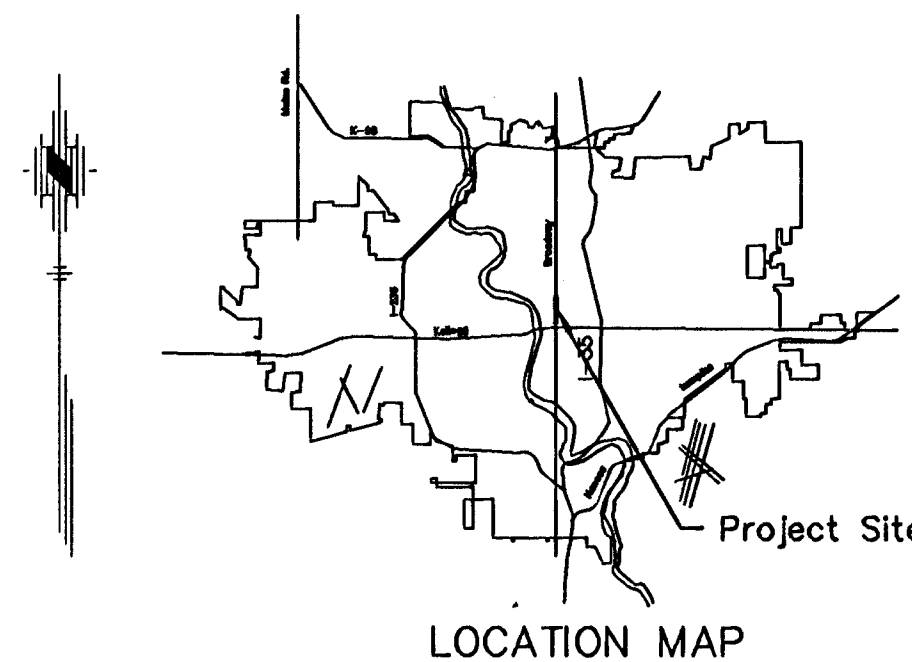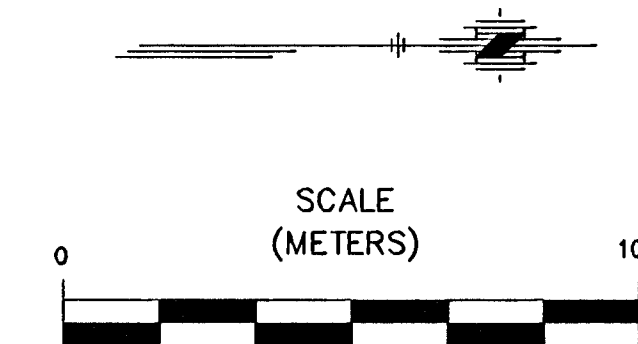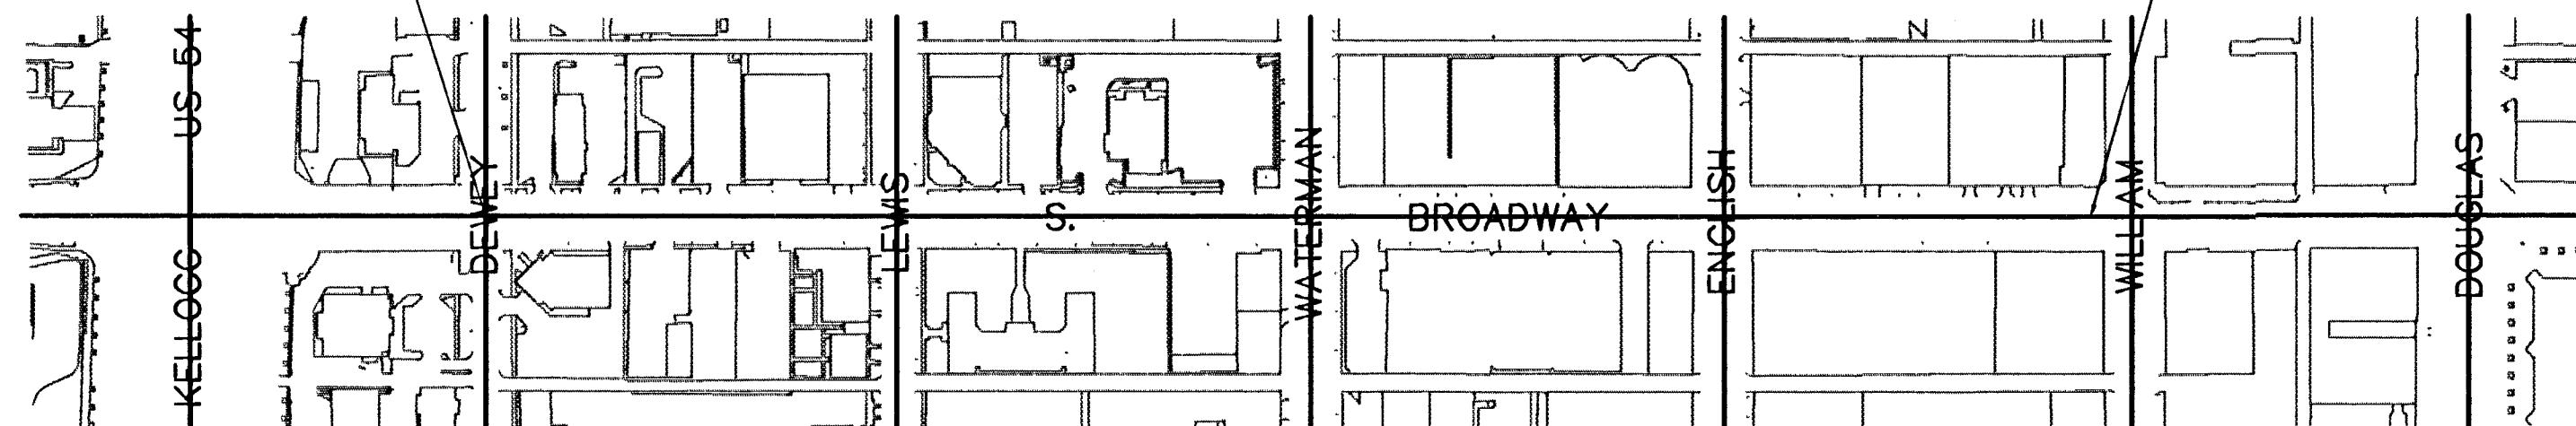

DESIGN DESIGNATION

AADT 11,500 (1995)
AADT 13,000 (2015)
DHV 10%
D 60%
T 5%
V 30 MPH (50 km/h)
Clear Zone 1 m

CONVENTIONAL SIGNS

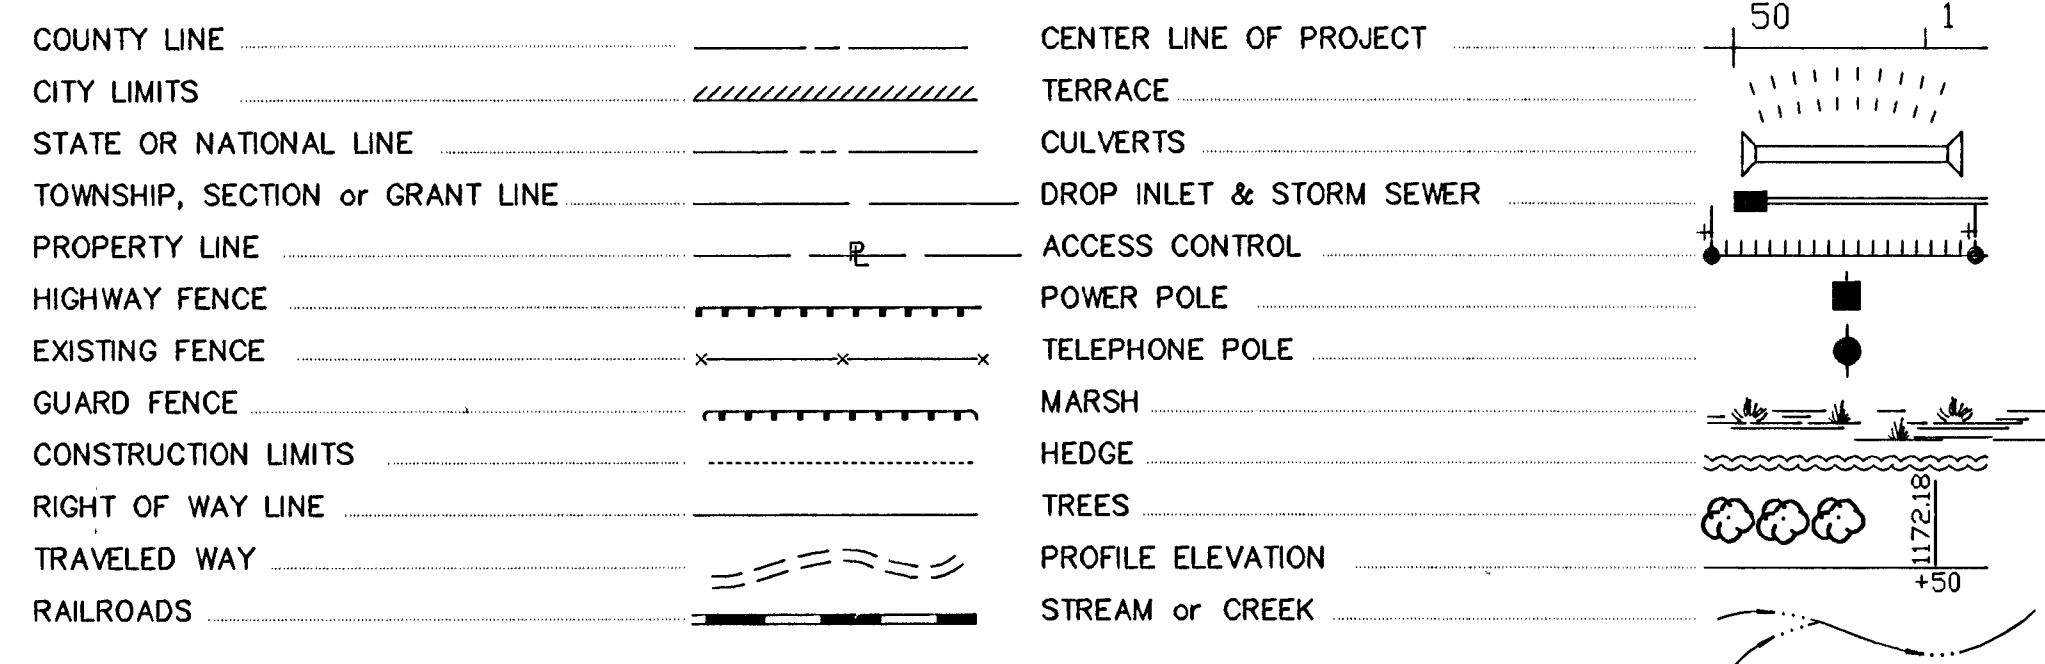

GROSS LENGTH OF PROJECT	569.211	m
EXCEPTIONS	000.000	m
ADDITIONS	000.000	m
NET LENGTH OF PROJECT	569.211	m
NET LENGTH OF BRIDGES	000.000	m
NET LENGTH OF ROAD	569.211	m

FHWA REGION NO.	STATE	PROJECT NO.	YEAR	SHEET NO.	TOTAL SHEETS
7	KANSAS	87 N-0061-01	1998	1	31
FED. AID NO.		STP-N006(101)			

PROJ. NO. 87 N-0061-01

GRADING
SURFACING
STORM SEWER
WATER LINE (NON-PARTICIPATING)
SEEDING
LANDSCAPING
SIGNALIZATION
STREET LIGHTING
PAVEMENT MARKING

KDOT METRIC
All dimensions shown, without a SI suffix, are in millimeters. All elevations shown are in meters.



PLANS PREPARED BY :

Booker ASSOCIATES INC.
OF KANSAS
Wichita Kansas

APPROVED :

Wendy E. Smith

DATE 4-8 1999

KANSAS DEPT. OF TRANSPORTATION
RECOMMENDED FOR APPROVAL

CHIEF, LOCAL PROJECTS

APPROVED : DATE :

STATE TRANSPORTATION ENGINEER