

# CITY OF WICHITA, KANSAS

## 15th STREET PUMP STATION

### ISSUE FOR CONSTRUCTION

### OCTOBER, 2005

**WATER & SEWER DEPARTMENT - DAVID R. WARREN, DIRECTOR**



**PROJECT NO. 468-83394**

**INDEX CODE 620335**

#### INDEX OF DRAWINGS

SHEET NO.	DESCRIPTION
<b>GENERAL</b>	
G1	COVER SHEET
G2	KEY MAP AND GENERAL NOTES
G3	LEGENDS AND SCHEDULES
G4	PROCESS FLOW DIAGRAM
<b>CIVIL</b>	
C1	SITE PLAN I
C2	SITE PLAN II
C3	SITE GRADING & PAVING PLAN
C4	MISCELLANEOUS CIVIL DETAILS I
C5	MISCELLANEOUS CIVIL DETAILS II
C6	MISCELLANEOUS CIVIL DETAILS III
C7	MISCELLANEOUS CIVIL DETAILS IV
C8	STANDARD TYPE II-M CURB INLET
C9	ROLL CURB INLET TYPE I DETAIL
C10	SHALLOW TYPE "P" & "C" MANHOLE
C11	CONCRETE PAVING DETAILS
<b>TRAFFIC CONTROL</b>	
TC1	TRAFFIC CONTROL PLAN
<b>PIPING</b>	
P1	SITE PIPING PLANS
P2	WET WELL PIPING PLANS & SECTION
P3	VALVE VAULT PIPING PLAN & SECTIONS
P4	FORCE MAIN PLAN & PROFILE
P5	STANDARD TYPE "P" MANHOLES
P6	STANDARD & LIGHT WEIGHT MANHOLE FRAME AND COVER
<b>ARCHITECTURAL</b>	
A1	ARCHITECTURAL FLOOR PLAN, ELEVATIONS, & SECTIONS
A2	ARCHITECTURAL ROOF PLAN, & DOOR DETAILS
<b>STRUCTURAL</b>	
S1	GENERATOR BLDG. FOUNDATION & ROOF FRAMING PLANS
S2	GENERATOR BLDG. SECTIONS & DETAILS
S3	VALVE VAULT & AIR RELEASE VAULT DETAILS
<b>MECHANICAL</b>	
M1	MECHANICAL PLAN
<b>ELECTRICAL</b>	
E1	ELECTRICAL LEGENDS
E2	ELECTRICAL SCHEDULES & ONE-LINE
E3	ELECTRICAL SITE PLAN
E4	ELECTRICAL PLANS
E5	PROCESS & INSTRUMENTATION DIAGRAM I
E6	PROCESS & INSTRUMENTATION DIAGRAM II
E7	INSTRUMENTATION DETAILS
E8	PANEL DETAILS
E9	ELECTRICAL DETAILS I
E10	ELECTRICAL DETAILS II
<b>DEMOLITION</b>	
D1	SITE DEMOLITION PLAN I
D2	SITE DEMOLITION PLAN II

Wildcat Construction Co., Inc. - Contractor  
 VanDeCreek - MKEC - Inspector  
 Released 2/5/07  
 As-Built  
 .pdf by JDL 6/21/07

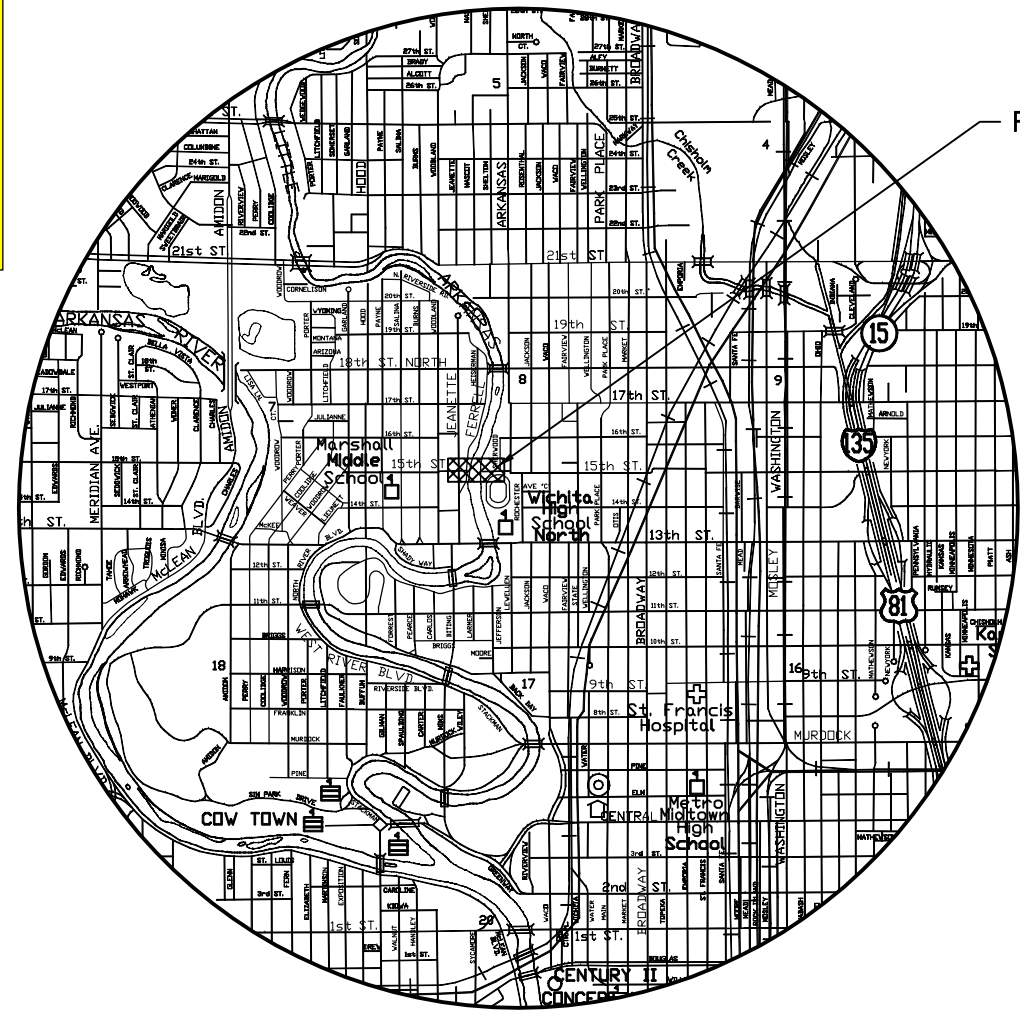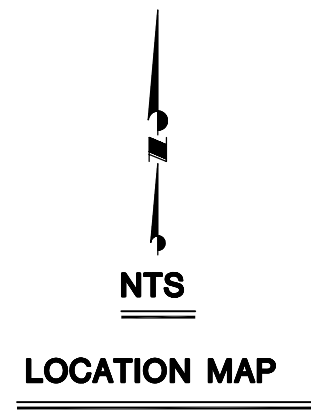

**PLANS PREPARED BY:**

**MKEC ENGINEERING CONSULTANTS, INC.**

**WICHITA, KANSAS**

**CONFORMING TO  
 CONSTRUCTION RECORDS  
 4/20/07**

THE CITY OF WICHITA  
 CITY ENGINEER'S OFFICE  
 CITY HALL - SERVICE FLOOR  
 605 NORTH WALK STREET  
 WICHITA, KANSAS 67202  
 (316) 244-1114 FAX

<table border="1" style="width: 100%; border-collapse: collapse;"> <tr> <th style="text-align: left;">NO.</th> <th style="text-align: left;">BY</th> <th style="text-align: left;">DATE</th> <th style="text-align: left;">DESCRIPTION</th> </tr> <tr> <td>0</td> <td>DLM</td> <td>10/17/05</td> <td>ISSUE FOR CONSTRUCTION</td> </tr> <tr> <td></td> <td>MJV</td> <td>4/26/07</td> <td>CONFORMING TO CONSTRUCTION RECORDS</td> </tr> </table>	NO.	BY	DATE	DESCRIPTION	0	DLM	10/17/05	ISSUE FOR CONSTRUCTION		MJV	4/26/07	CONFORMING TO CONSTRUCTION RECORDS				<b>CITY OF WICHITA, KANSAS</b> <b>15th STREET PUMP STATION</b> <b>AND FORCE MAIN</b>  <b>COVER SHEET</b>		<table border="1" style="width: 100%; border-collapse: collapse;"> <tr> <td>DESIGNED BY</td> <td>DLM</td> <td>CHECKED BY</td> <td>DLM</td> </tr> <tr> <td>DRAWN BY</td> <td>BDM</td> <td>DATE</td> <td>JUNE, 2005</td> </tr> <tr> <td>PROJECT</td> <td colspan="3" style="text-align: center;">CONTRACT</td> </tr> <tr> <td></td> <td colspan="3" style="text-align: center;">0301030310</td> </tr> <tr> <td>DRAWING</td> <td colspan="3" style="text-align: center;">REVISION</td> </tr> <tr> <td style="text-align: center;"><b>G1</b></td> <td style="text-align: center;">-</td> <td colspan="2" style="text-align: center;"><b>0</b></td> </tr> <tr> <td colspan="4" style="font-size: x-small;">FILE S:\ENVR\03310\3PWG\General\0331002.DWG 11/01/2005 09:41:06 AM CST</td> </tr> </table>	DESIGNED BY	DLM	CHECKED BY	DLM	DRAWN BY	BDM	DATE	JUNE, 2005	PROJECT	CONTRACT				0301030310			DRAWING	REVISION			<b>G1</b>	-	<b>0</b>		FILE S:\ENVR\03310\3PWG\General\0331002.DWG 11/01/2005 09:41:06 AM CST			
NO.	BY	DATE	DESCRIPTION																																											
0	DLM	10/17/05	ISSUE FOR CONSTRUCTION																																											
	MJV	4/26/07	CONFORMING TO CONSTRUCTION RECORDS																																											
DESIGNED BY	DLM	CHECKED BY	DLM																																											
DRAWN BY	BDM	DATE	JUNE, 2005																																											
PROJECT	CONTRACT																																													
	0301030310																																													
DRAWING	REVISION																																													
<b>G1</b>	-	<b>0</b>																																												
FILE S:\ENVR\03310\3PWG\General\0331002.DWG 11/01/2005 09:41:06 AM CST																																														