
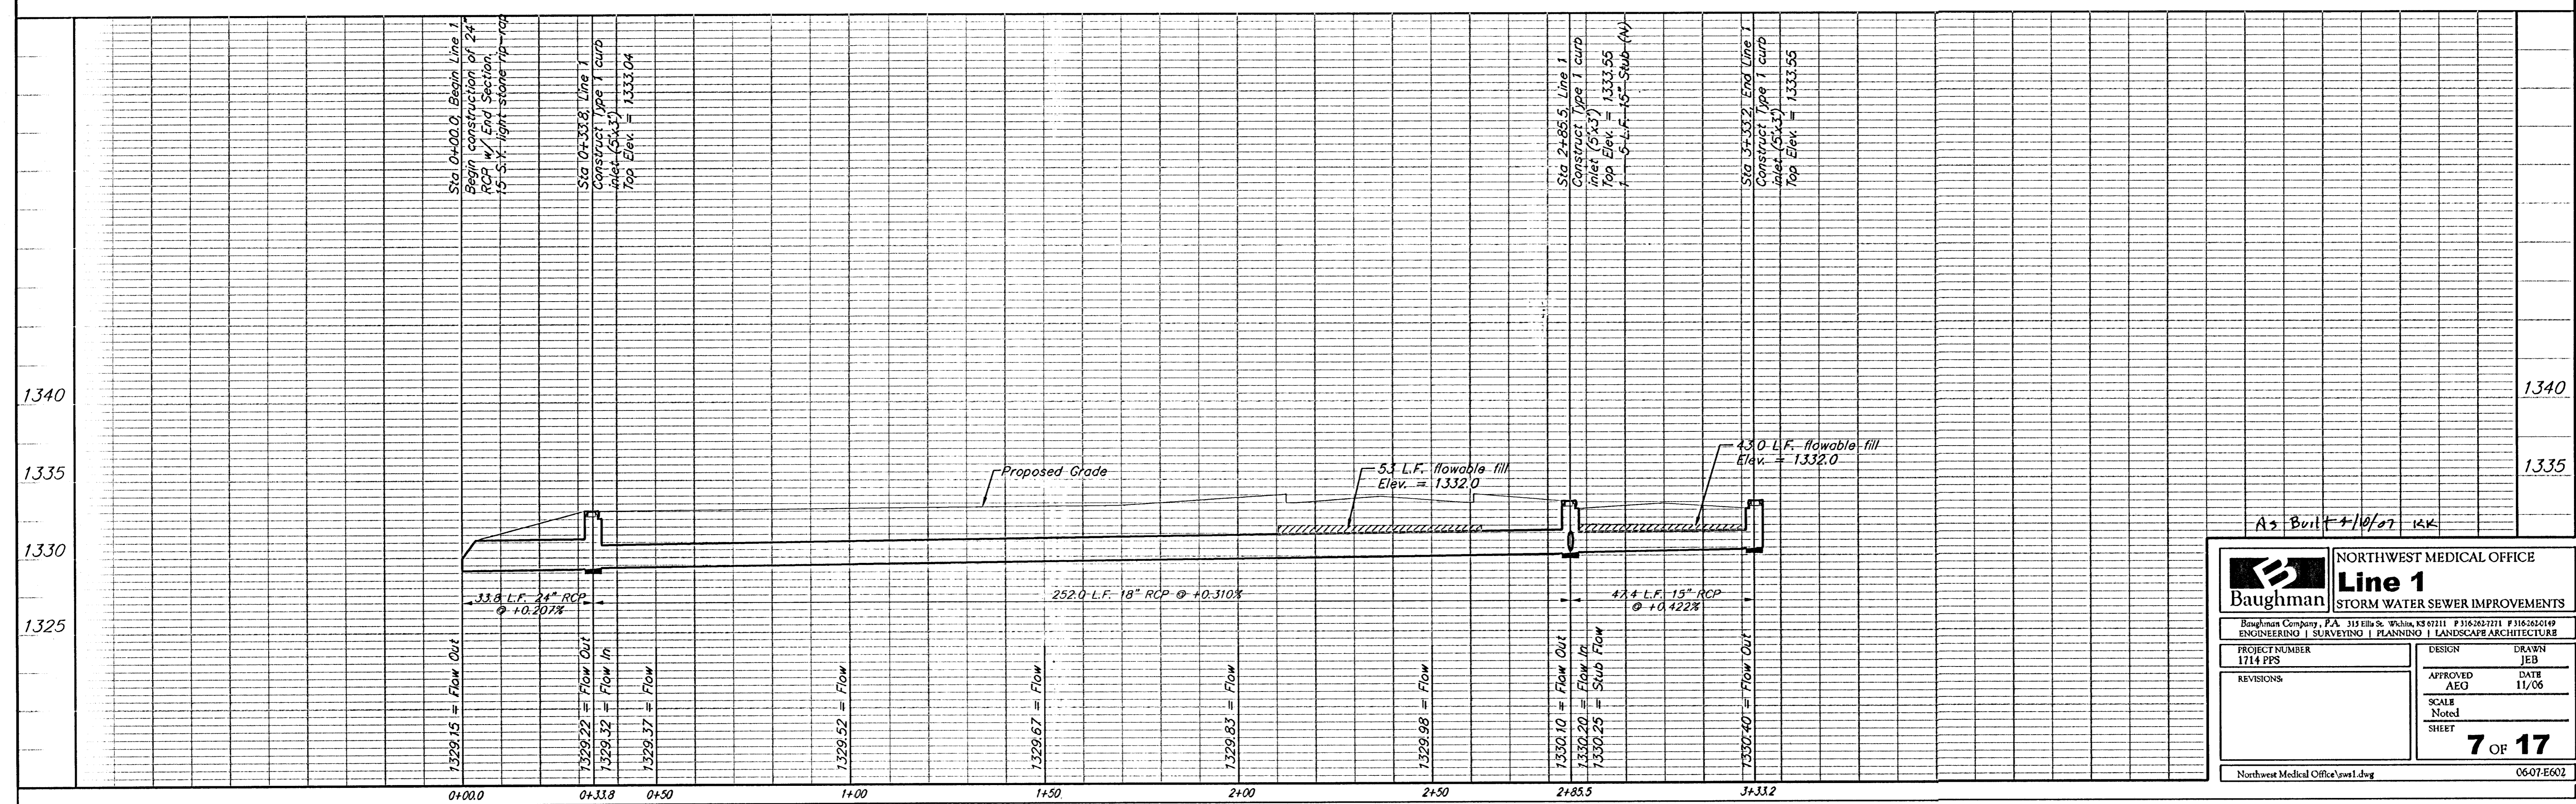


BENCHMARK:
 Railroad Spike in East Face of
 Power Pole, East of the NE Corner
 of Lot 3, Northridge Plaza Addition
 on East Side of Ridge Road
 Elev. = 1335.05 M.S.L.

NORTHDRIDGE
 PLAZA
 ADDITION
 LOT #2

Scale: 1" = 20' Horizontal
 1" = 5' Vertical
 ● = Iron

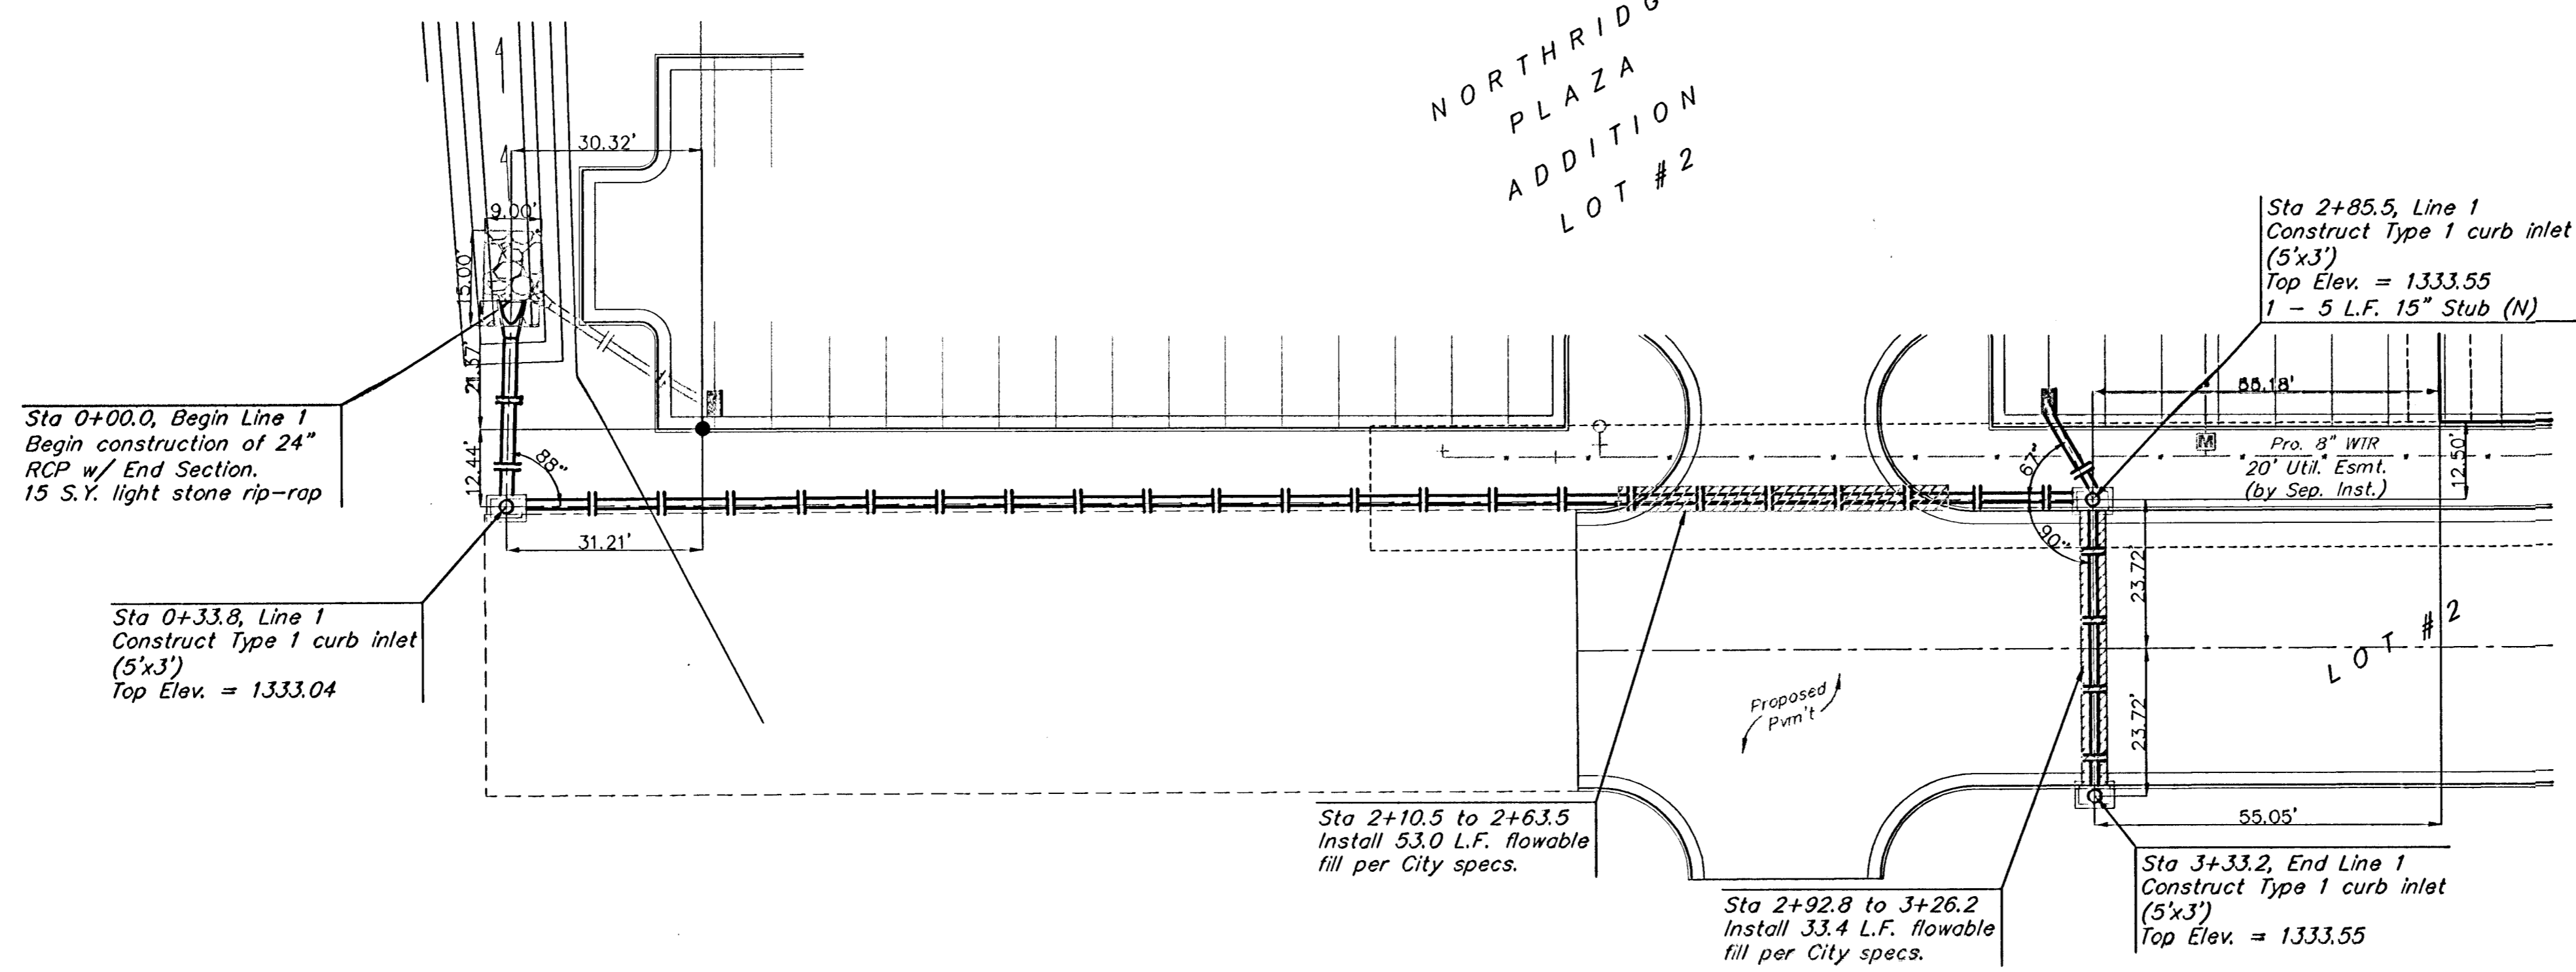

As Built 4/10/07 KKK

Baughman		NORTHWEST MEDICAL OFFICE	
		Line 1	
		STORM WATER SEWER IMPROVEMENTS	
Baughman Company, P.A. 315 Ellis St. Wichita, KS 67211 P 316-262-7711 F 316-262-0149			
ENGINEERING SURVEYING PLANNING LANDSCAPE ARCHITECTURE			
PROJECT NUMBER 1714 PPS	DESIGN	DATE	DRAWN
REVISIONS	AEG	11/06	JEB
SCALE Noted		SHEET	
		7 OF 17	
Northwest Medical Office\sw1.dwg		06-07-E602	