


BENCHMARK:
 Railroad Spike in East Face of
 Power Pole, East of the NE Corner
 of Lot 3, Northridge Plaza Addition
 on East Side of Ridge Road
 Elev. = 1335.05 M.S.L.



NORTHRIDGE
 PLAZA
 ADDITION
 LOT # 4

LOT # 2

NORTHRIDGE
 PLAZA
 ADDITION
 LOT # 3

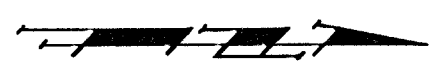

Scale: 1" = 20' Horizontal
 1" = 5' Vertical
 ● = Iron

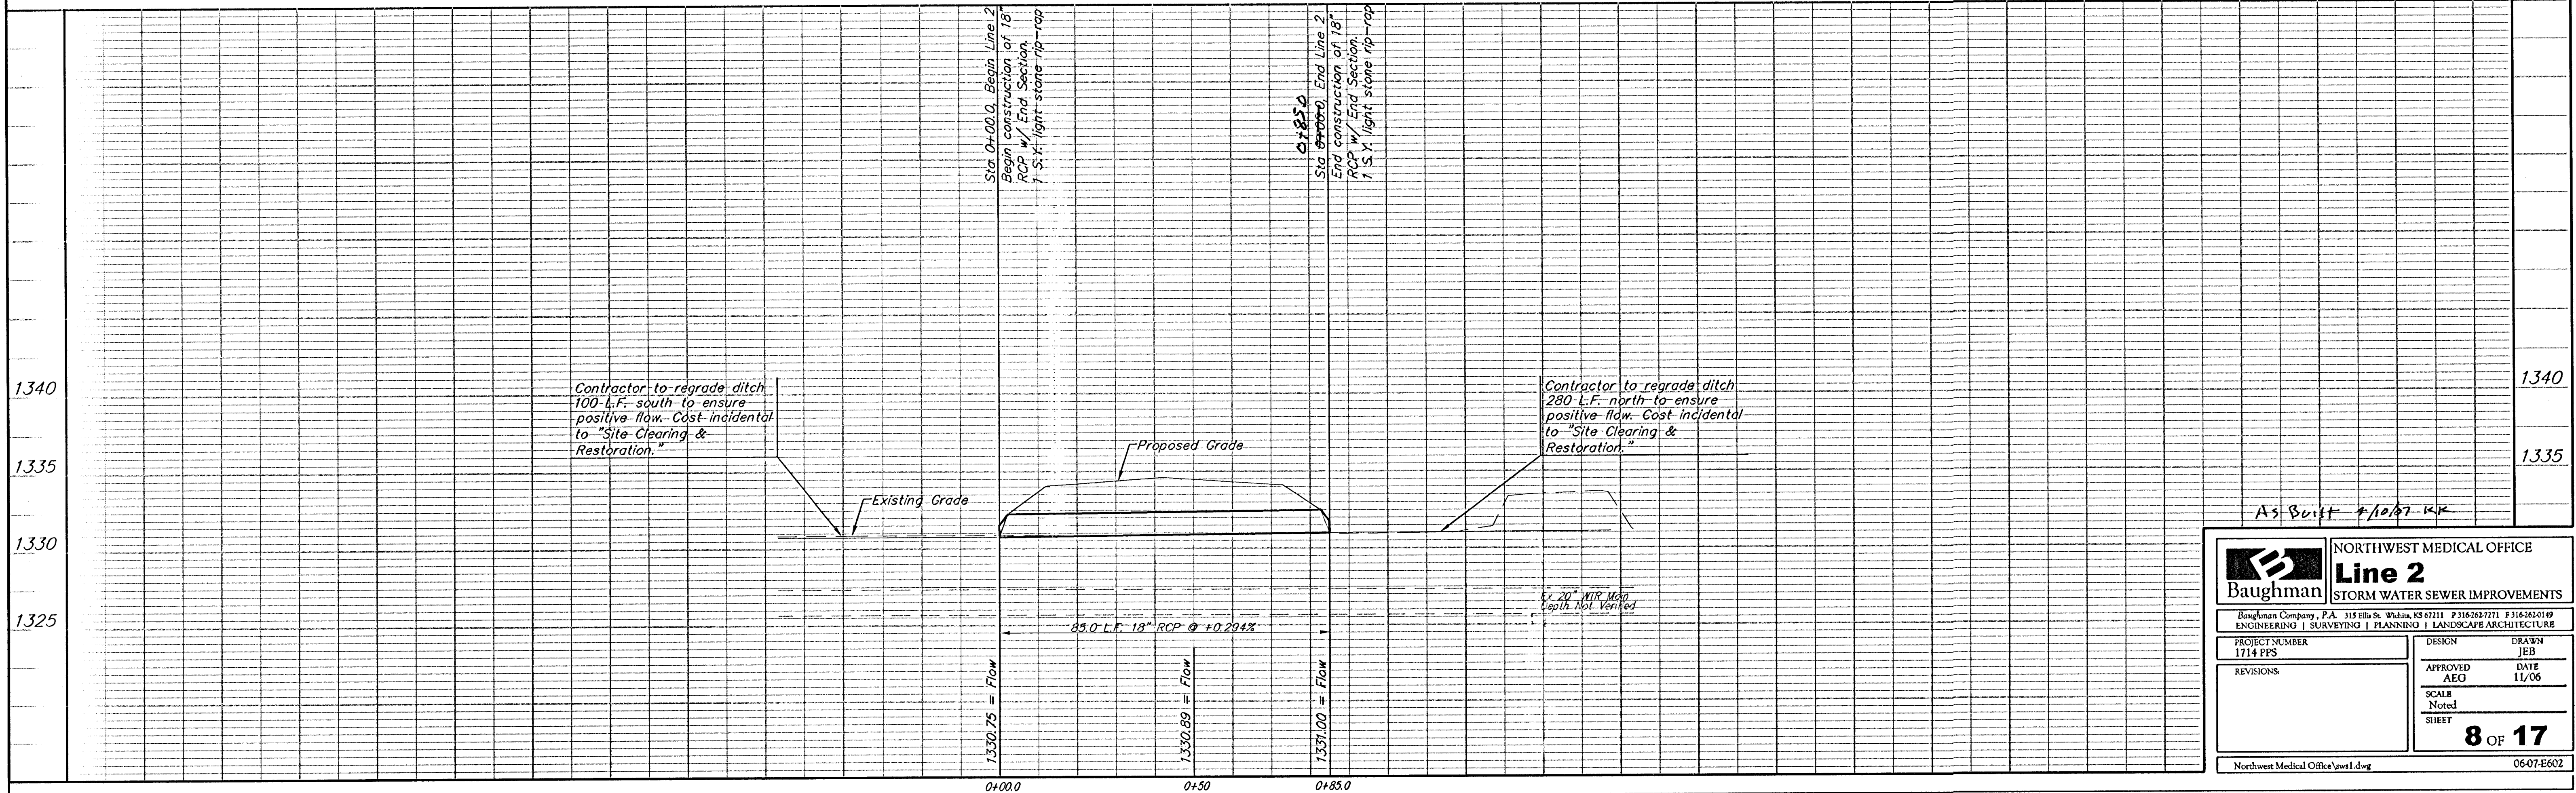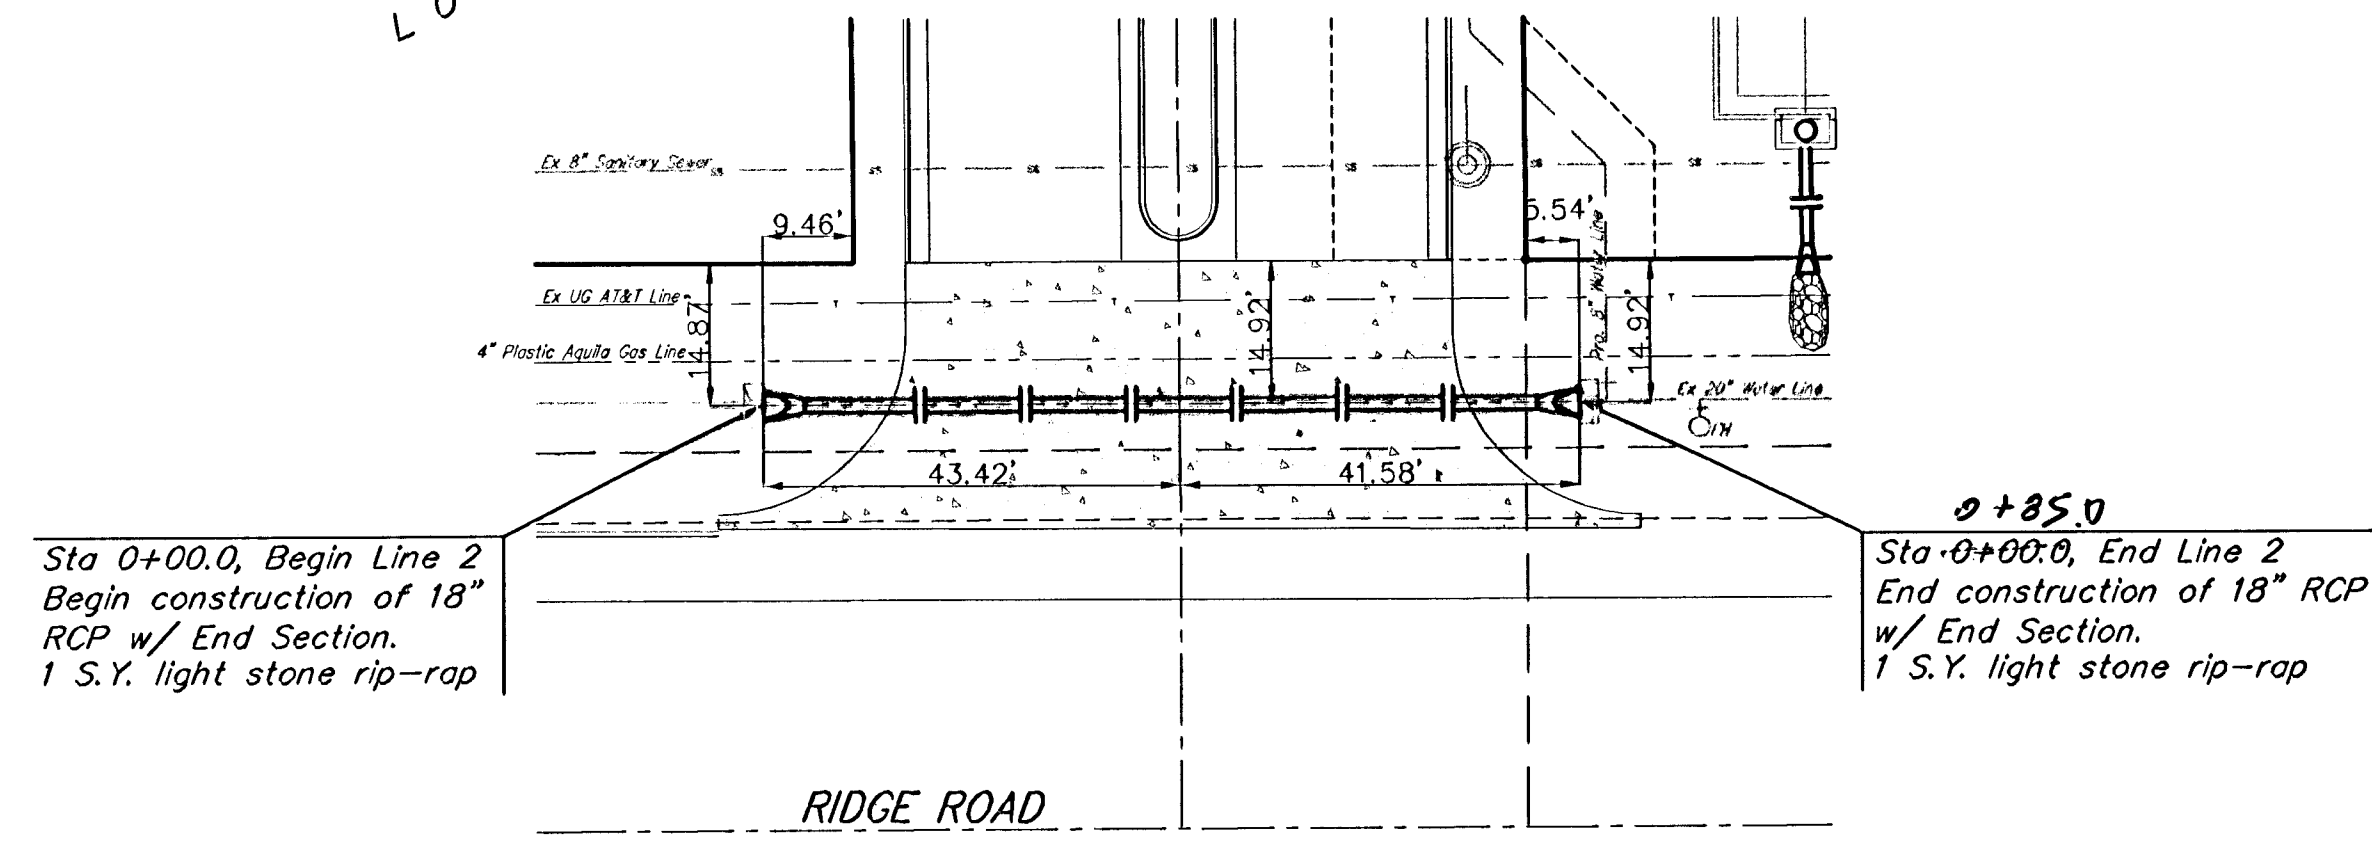

AS Built 4/10/07 KJK

		NORTHWEST MEDICAL OFFICE	
		Line 2	
STORM WATER SEWER IMPROVEMENTS		<small>Baughman Company, P.A. 315 Ellis St. Harrisburg, PA 17101-1111 P: 717-653-7171 F: 717-653-0149 ENGINEERING SURVEYING PLANNING LANDSCAPE ARCHITECTURE</small>	
PROJECT NUMBER 1714 PFS	DESIGN AEO	DRAWN JEB	DATE 11/06
REVISIONS	SCALE Noted	SHEET 8 OF 17	
Northwest Medical Office\sws1.dwg		06-07-E602	