


Paul E. ...
RECORD DRAWING
 25 JAN 07

SANITARY SEWER LINE NO. 1

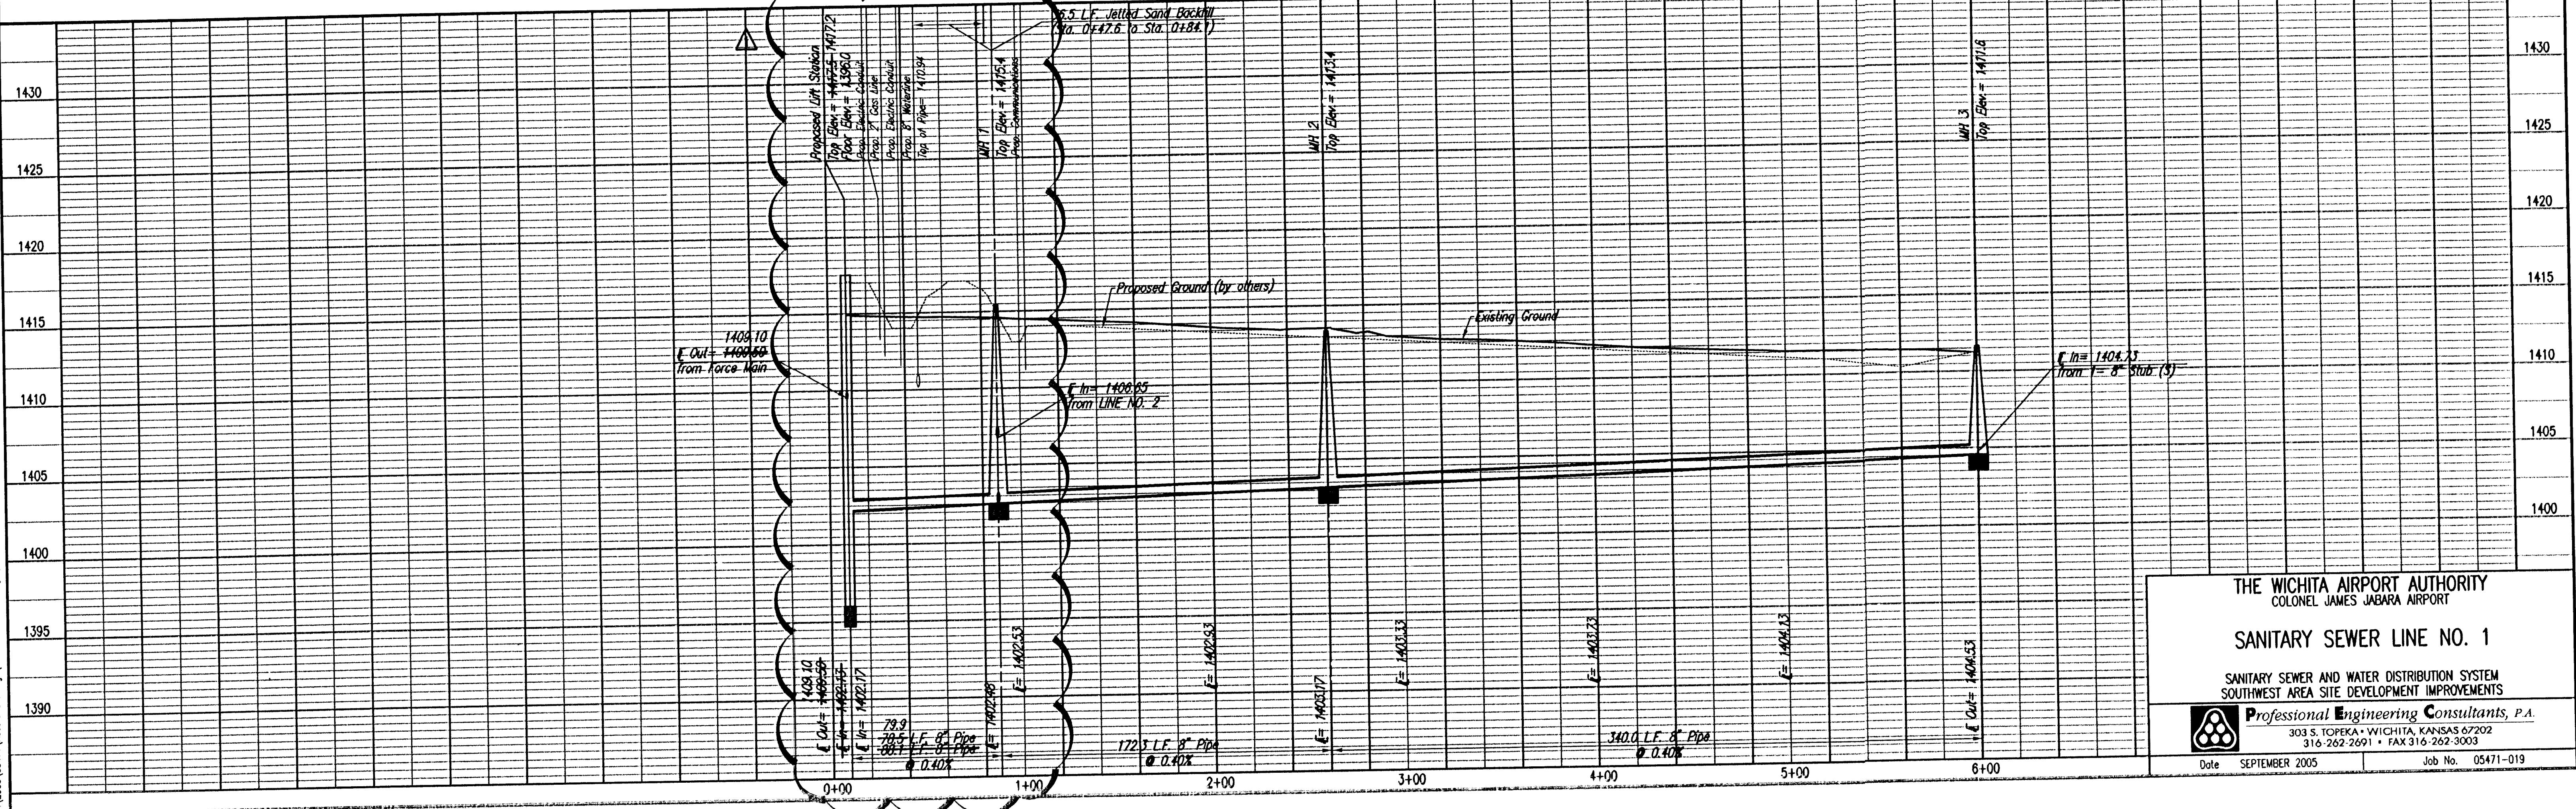

THE WICHITA AIRPORT AUTHORITY
 COLONEL JAMES JABARA AIRPORT

SANITARY SEWER LINE NO. 1

SANITARY SEWER AND WATER DISTRIBUTION SYSTEM
 SOUTHWEST AREA SITE DEVELOPMENT IMPROVEMENTS

Professional Engineering Consultants, P.A.
 303 S. TOPEKA • WICHITA, KANSAS 67202
 316-262-2691 • FAX 316-262-3003

Date SEPTEMBER 2005 Job No. 05471-019

04-16-2007 4:56:36 PM by JLS
 Plot Scale 1/4" = 10'-0" 10/27/06 AM by JLS
 © 2005 (05471) Record Drawings PPS-Record Drawings (05471-000-C-SSPP01-CHANGEORDER1)

DATE	BY	REVISION
10/12/06	JLS	RELOCATE LIFT STATION