




1 TYPICAL ACROSS-THE-LINE STARTER WIRING DIAGRAM
NO SCALE (NOTE: ALLOW ADDITIONAL 3" OF HEIGHT PER STARTER FOR RELAYS).

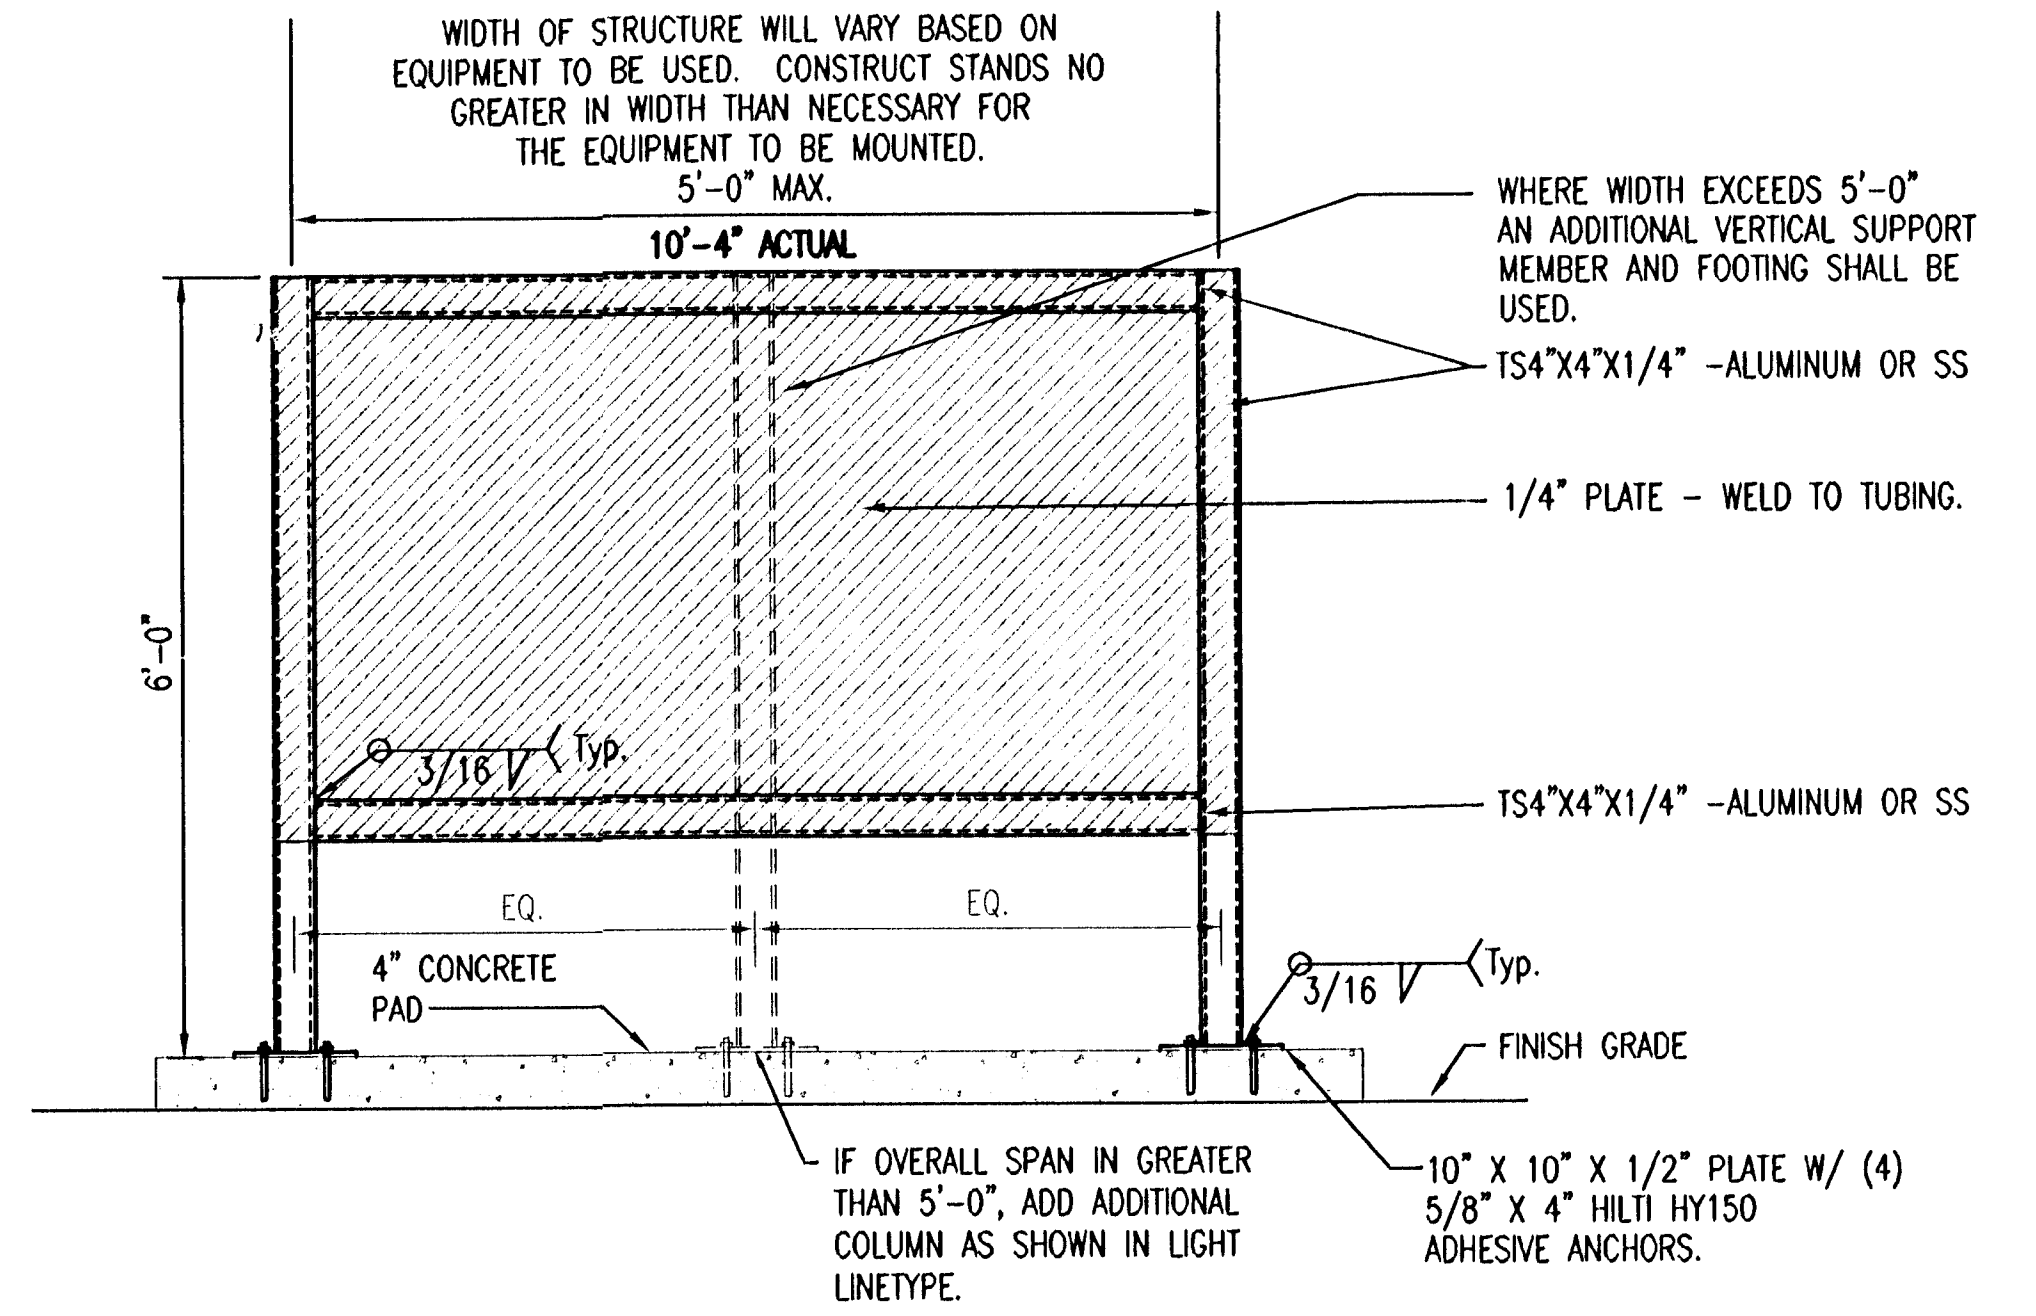

3 TYPICAL ELECTRICAL STRUCTURE DETAIL
NO SCALE

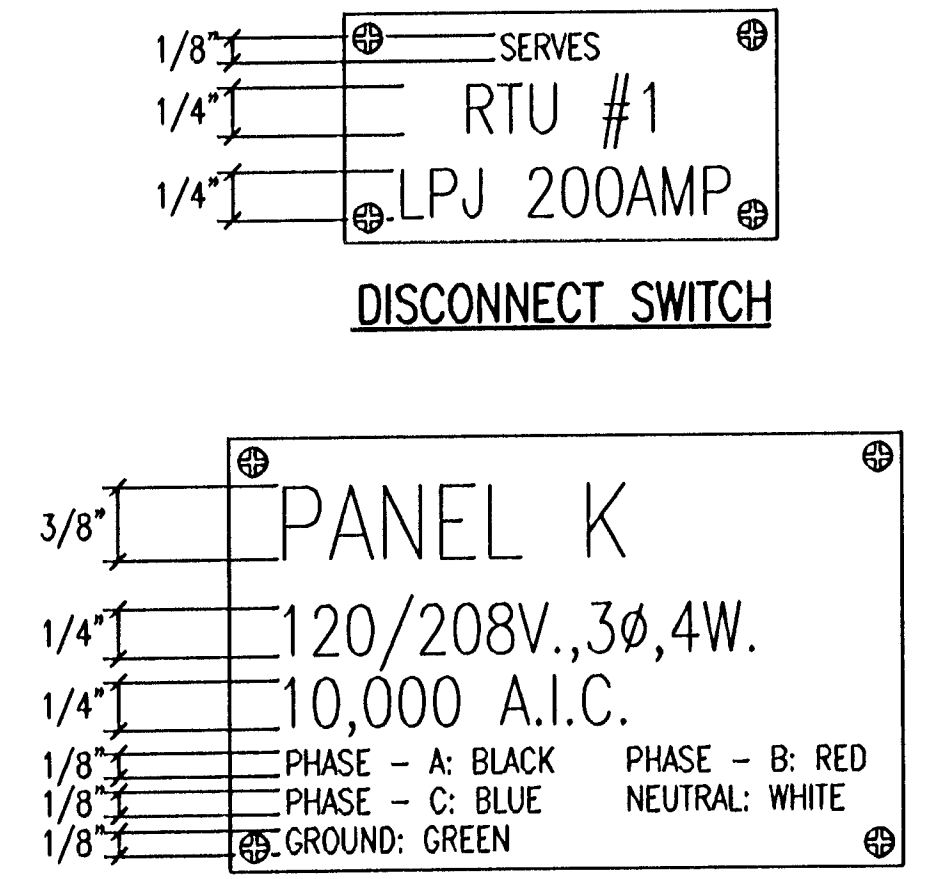

2 TYPICAL NAME PLATES
NO SCALE

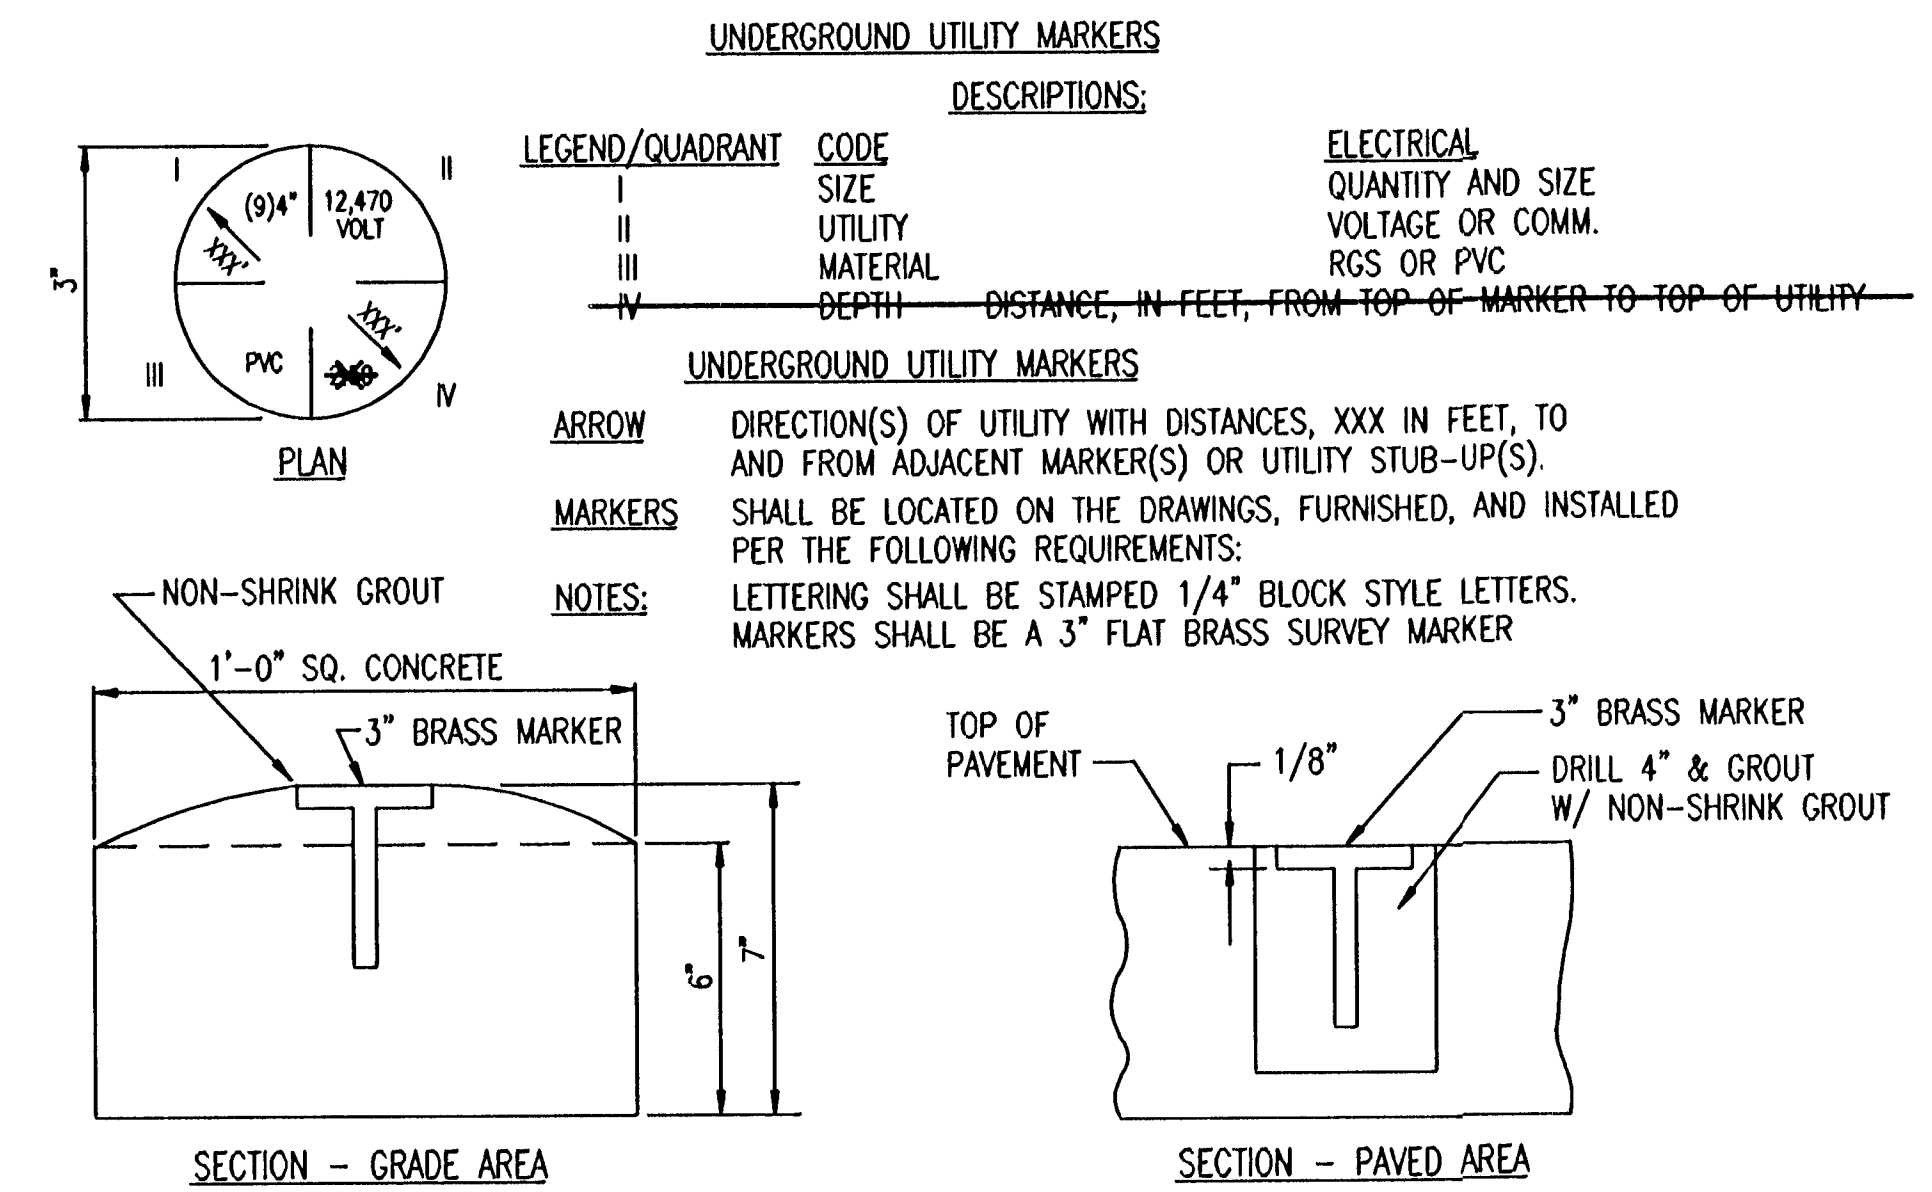

4 UTILITY MARKER DETAIL
NO SCALE

RECORD DRAWING

THE WICHITA AIRPORT AUTHORITY
COLONEL JAMES JABARA AIRPORT

ELECTRICAL
DETAILS

SANITARY SEWER AND WATER DISTRIBUTION SYSTEM
SOUTHWEST AREA SITE DEVELOPMENT IMPROVEMENTS

Professional Engineering Consultants, P.A.
303 S. TOPEKA • WICHITA, KANSAS 67202
316-262-2691 • FAX 316-262-3003

Date SEPTEMBER 2005 Job No. 05471-019

Date: 04-11-2007 8:12:46 PM by: JLS
 Scale: 1/8" = 1'-0" (1/8" = 1'-0")
 Path: C:\Users\jls\AppData\Local\Temp\Drawings\05471-02-Electrical\