
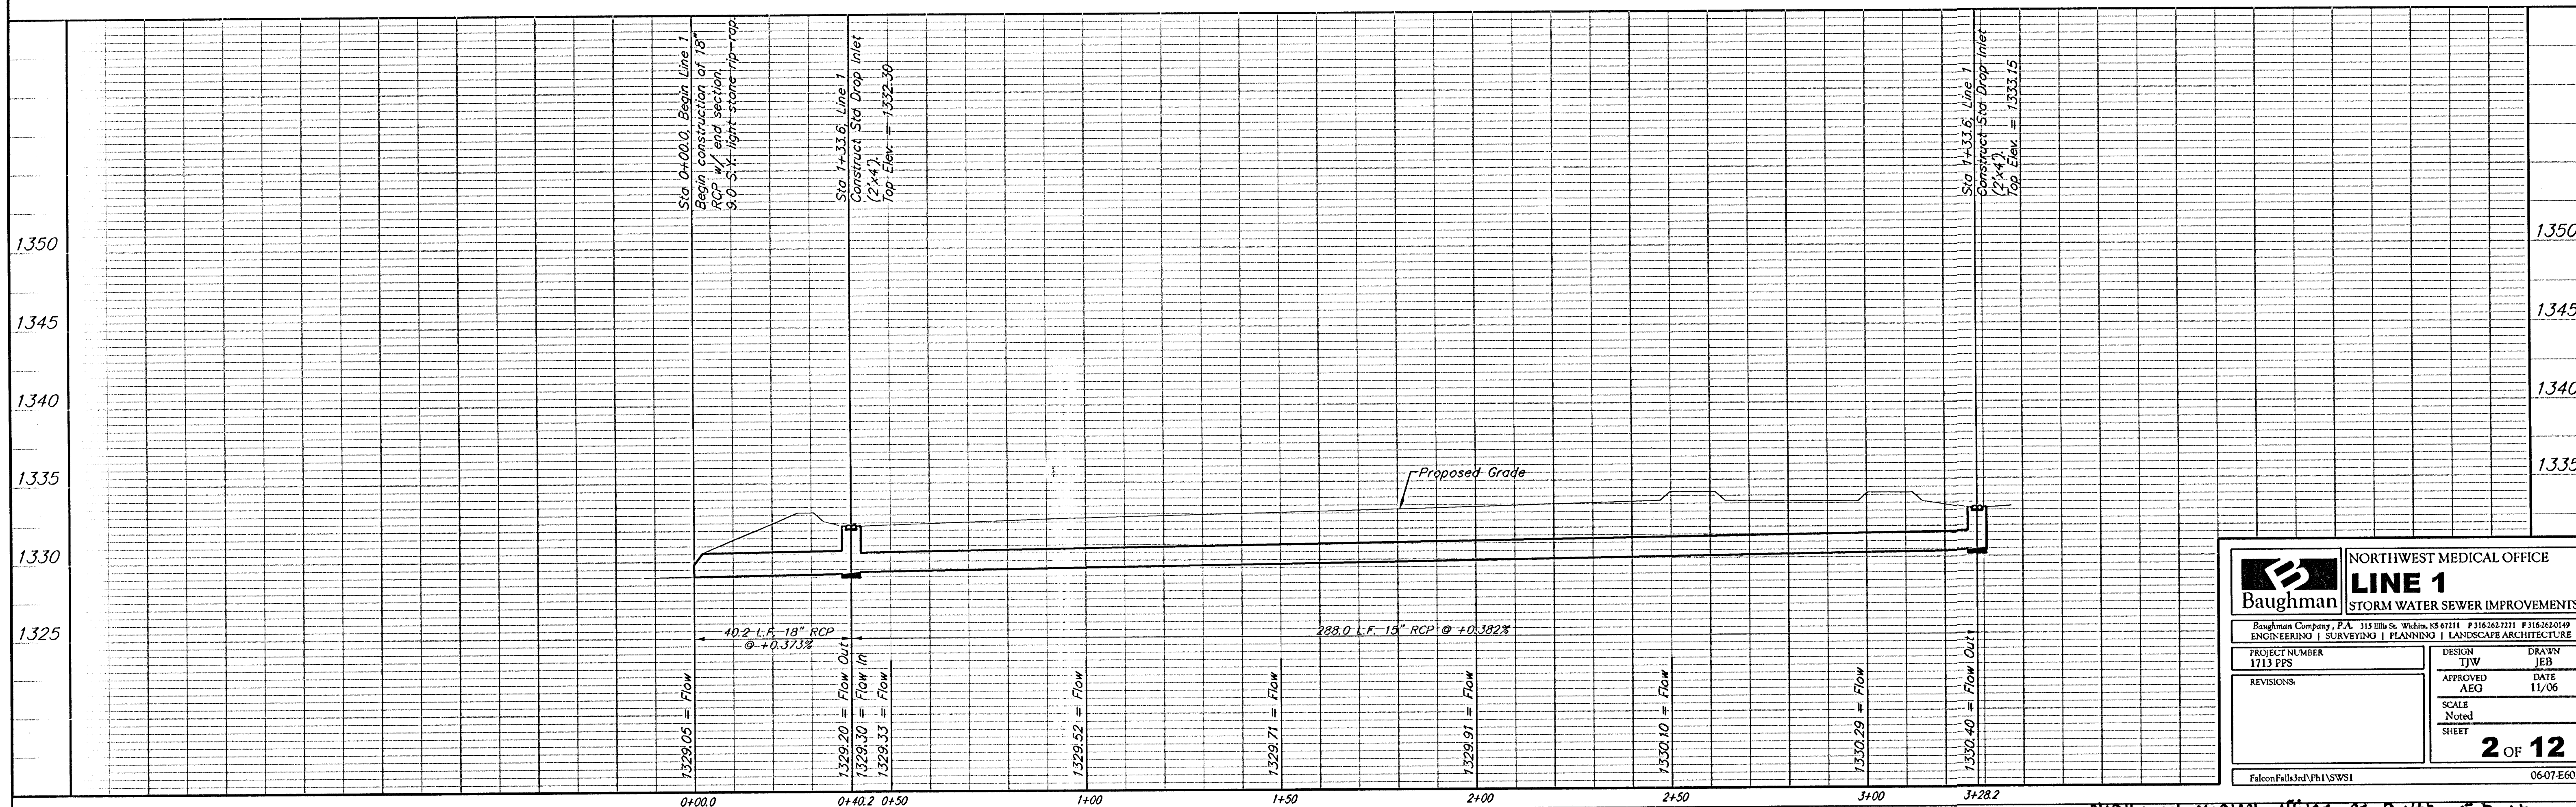


BENCHMARK:
Railroad Spike in East Face of
Power Pole, East of the NE Corner
of Lot 3, Northridge Plaza Addition
on East Side of Ridge Road
Elev. = 1335.05 M.S.L.

Scale: 1" = 20' Horizontal
1" = 5' Vertical
● = Iron

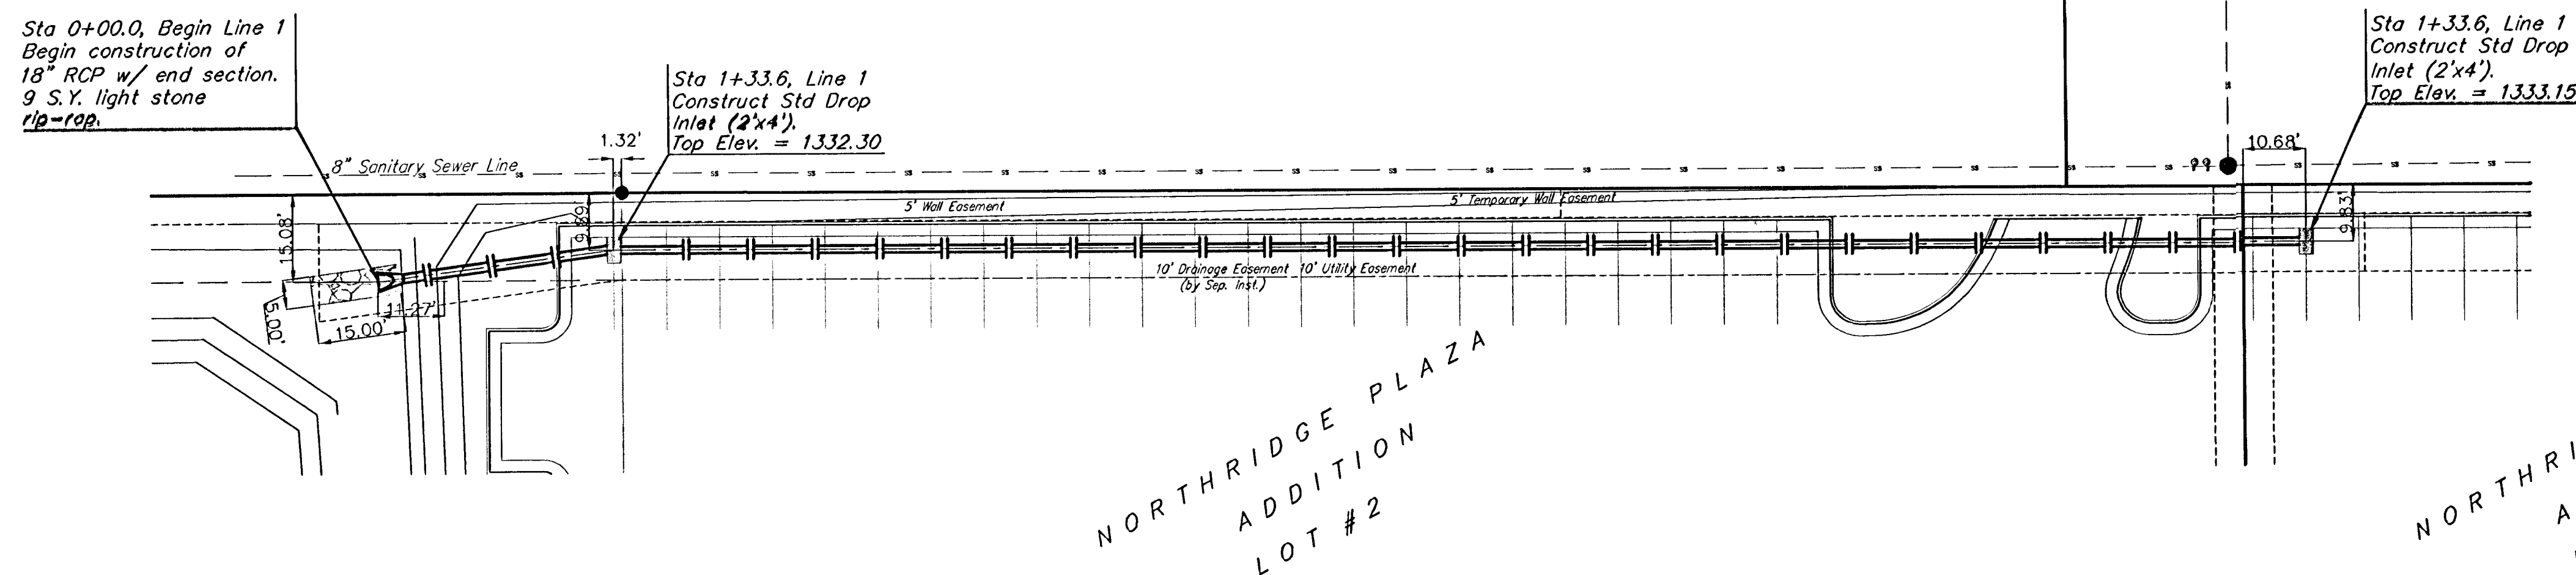

Baughman		NORTHWEST MEDICAL OFFICE	
		LINE 1	
		STORM WATER SEWER IMPROVEMENTS	
PROJECT NUMBER 1713 PPS		DESIGN TJW	DRAWN JEB
REVISIONS:		APPROVED AEG	DATE 11/06
		SCALE Noted	SHEET
		2 OF 12	
Falcon Falls 3rd Ph1 SWS1		06-07-E602	

NORTHWEST MEDICAL OFFICE AS-BUILT 3-7-07
T.H./CED