


# HAWTHORNE ADDITION ROSEMONT CIRCLE STORM WATER SEWER PLANS

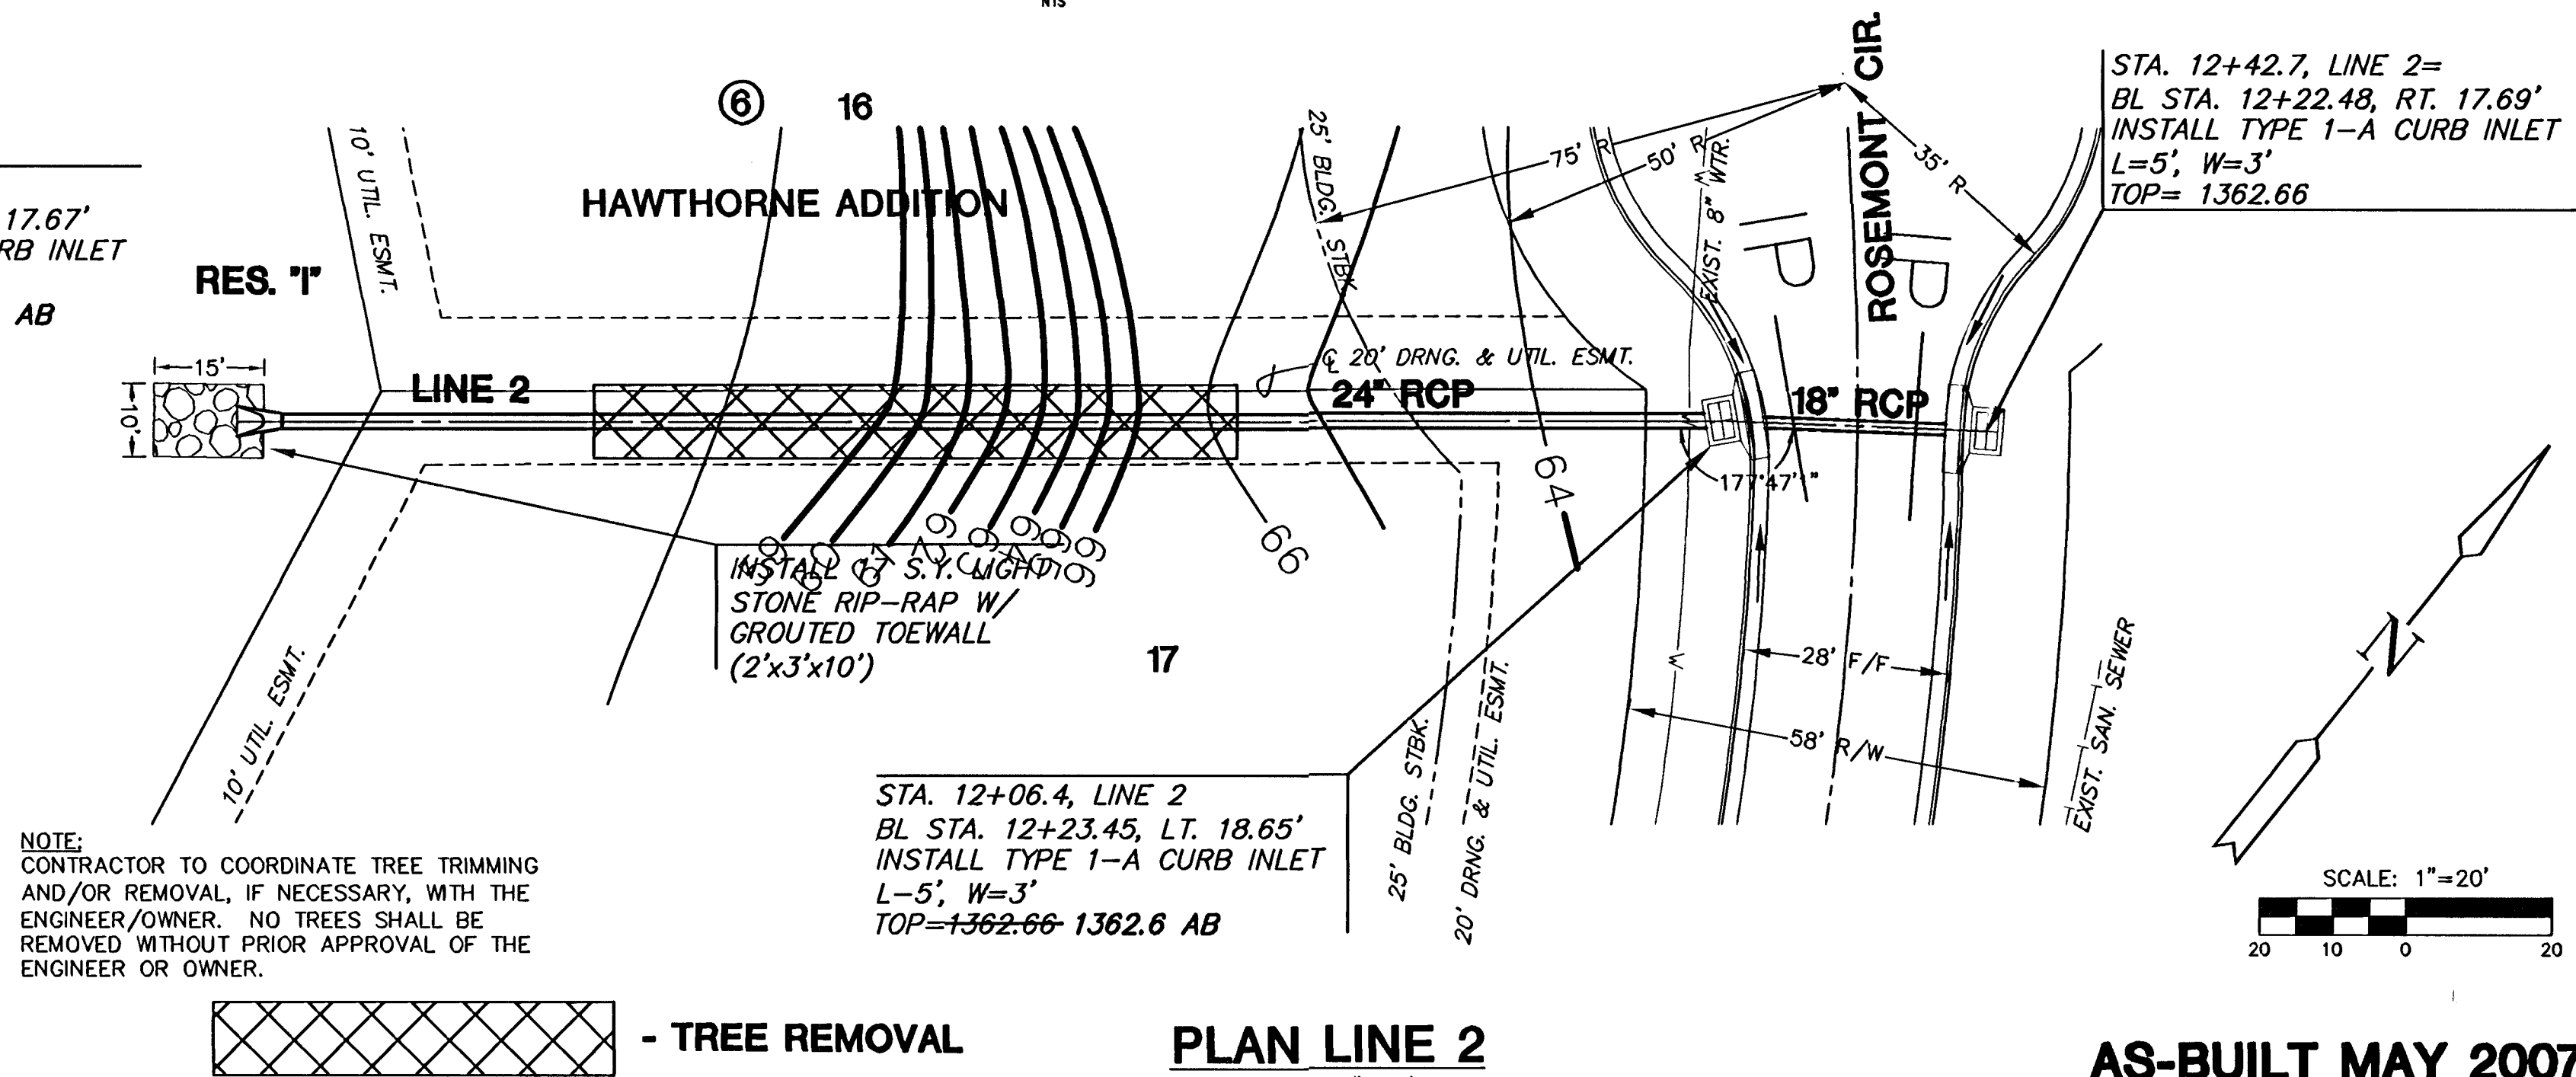

## PLAN LINE 2

## PROFILE LINE 2

