



WATER VALVE BOX ELEVATIONS			
STREET	STATION	OFFSET	PROPOSED ELEVATION
PALMETTO	60+54.06	23.0' LT.	152.6
PALMETTO	60+57.06	26.0' LT.	152.7

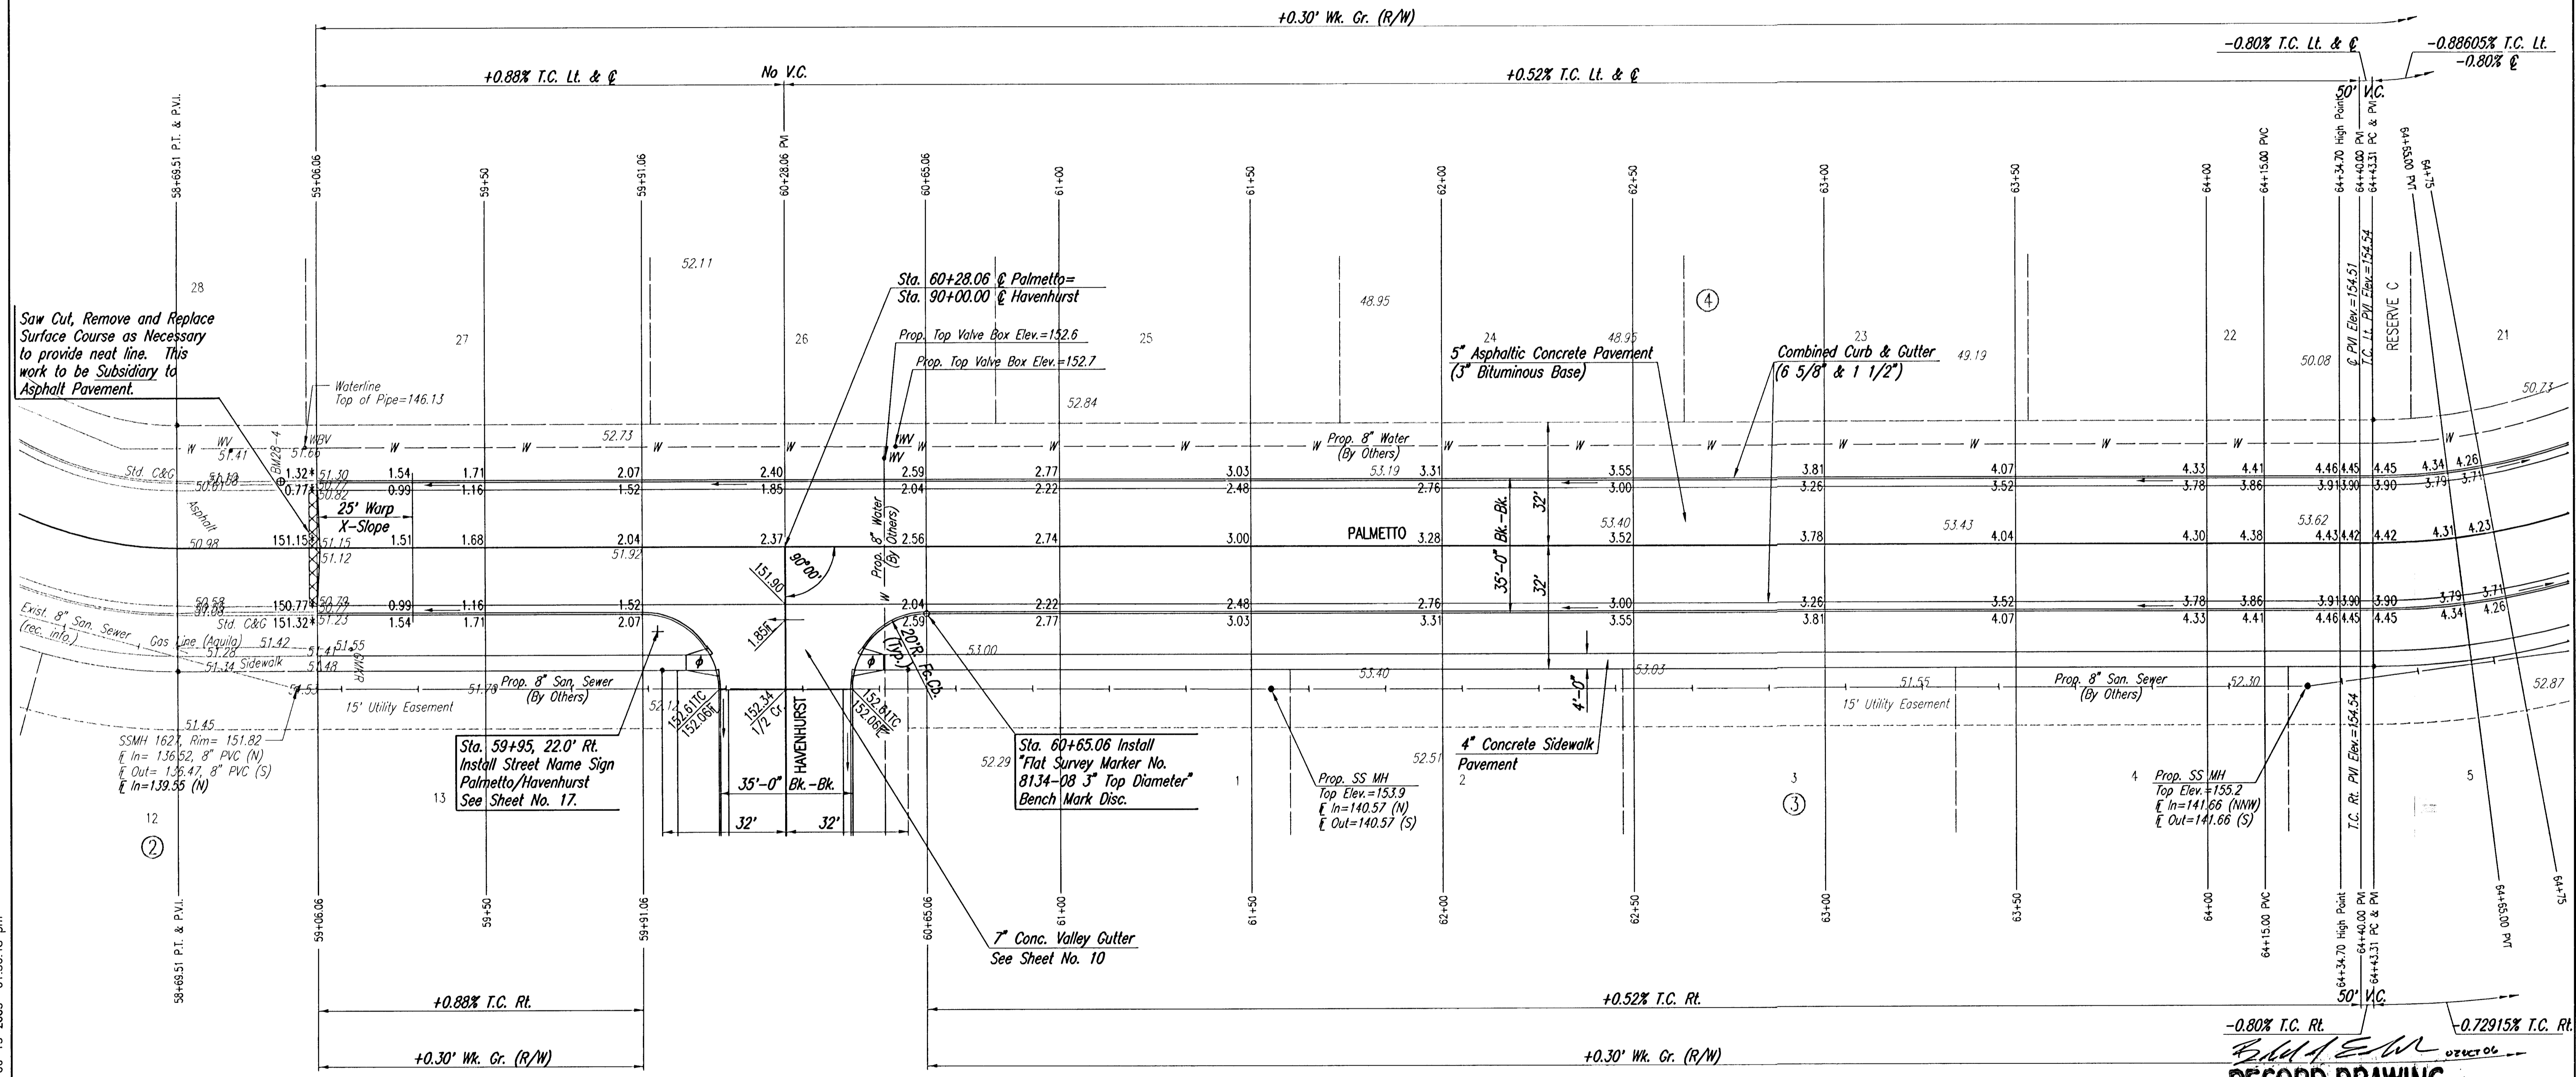

DSNR: BLB OPER: BJS SCALE: 1"=20.00  
 Q:\2005\05055\000\05059-000-C-STR59-64 06-13-2005 01:36:48 pm

RECORD DRAWING  
 6-15-05

\* Match Existing  
 \* Construct Std. Wheelchair Ramp

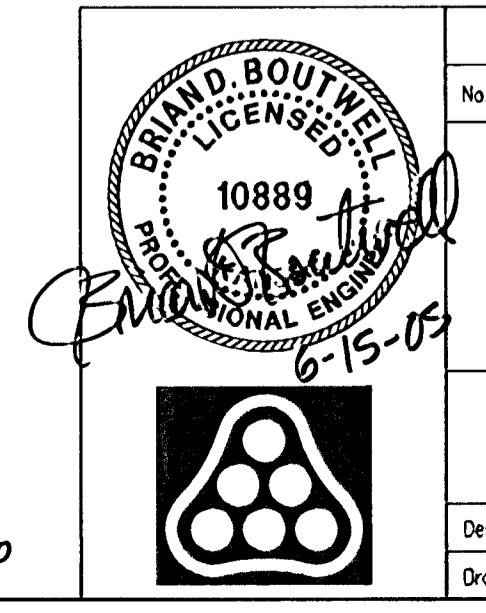

No.	Revision	By	Date

AVALON PARK-PHASE 4  
**PALMETTO**  
 STA. 59+06.06 TO STA. 64+43.31  
 JAMES L. ARMOUR, P.E.-CITY ENGINEER  
 CITY OF WICHITA PROJECT NO. 472-83838  
**Professional Engineering Consultants, P.A.**  
 303 S. TOPEKA • WICHITA, KANSAS 67202  
 316-262-2691 • FAX 316-262-3003

Designed by	BDB, BLB	Job No.	35-05059-000	Sheet	7 of 22
Drawn by	BJS	Date	February 2005		