

Sta. 60+28.06 @ Palmetto=
Sta. 90+00.00 @ Havenhurst

Saw Cut, Remove and Replace
Surface Course as Necessary
to provide neat line. This
work to be Subsidiary to
Asphalt Pavement.

Remove Existing Signs
(End of Road Marker)
Subsidiary to "Site Clearing".

Saw Cut and Remove
Excess Existing Pavement
As Necessary (Subsidiary).


Sidewalk Location May Be
Adjusted in the Field to
Fit Conditions.

* Match Existing

⑤ 5' Transition from Combined Curb and Gutter (6 5/8" & 1 1/2") to Combined Curb and Gutter (3 5/8" Roll & 1 1/2"). To be bid and paid for as "Combined Curb and Gutter (6 5/8" & 1 1/2)".

DSNR: BLB OPER: BJS SCALE: 1"=20.00
Q:\2005\05059\000\05059-000-C-STR90-92 06-13-2005 01:42:08 pm

[Signature]
RECORD DRAWING

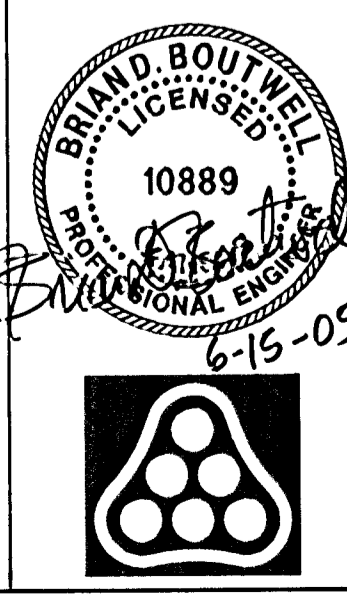

No.	Revision	By	Date
	AVALON PARK-PHASE 4		
HAVENHURST STA. 90+00 TO STA. 91+72.73 JAMES L. ARMOUR, P.E.-CITY ENGINEER CITY OF WICHITA PROJECT NO. 472-83838			
Professional Engineering Consultants, P.A. 303 S. TOPEKA • WICHITA, KANSAS 67202 316-262-2691 • FAX 316-262-3003			
Designed by	BDB, BLB	Job No.	35-05059-000
Drawn by	BJS	Date	February 2005
			SH. 9 of 22