
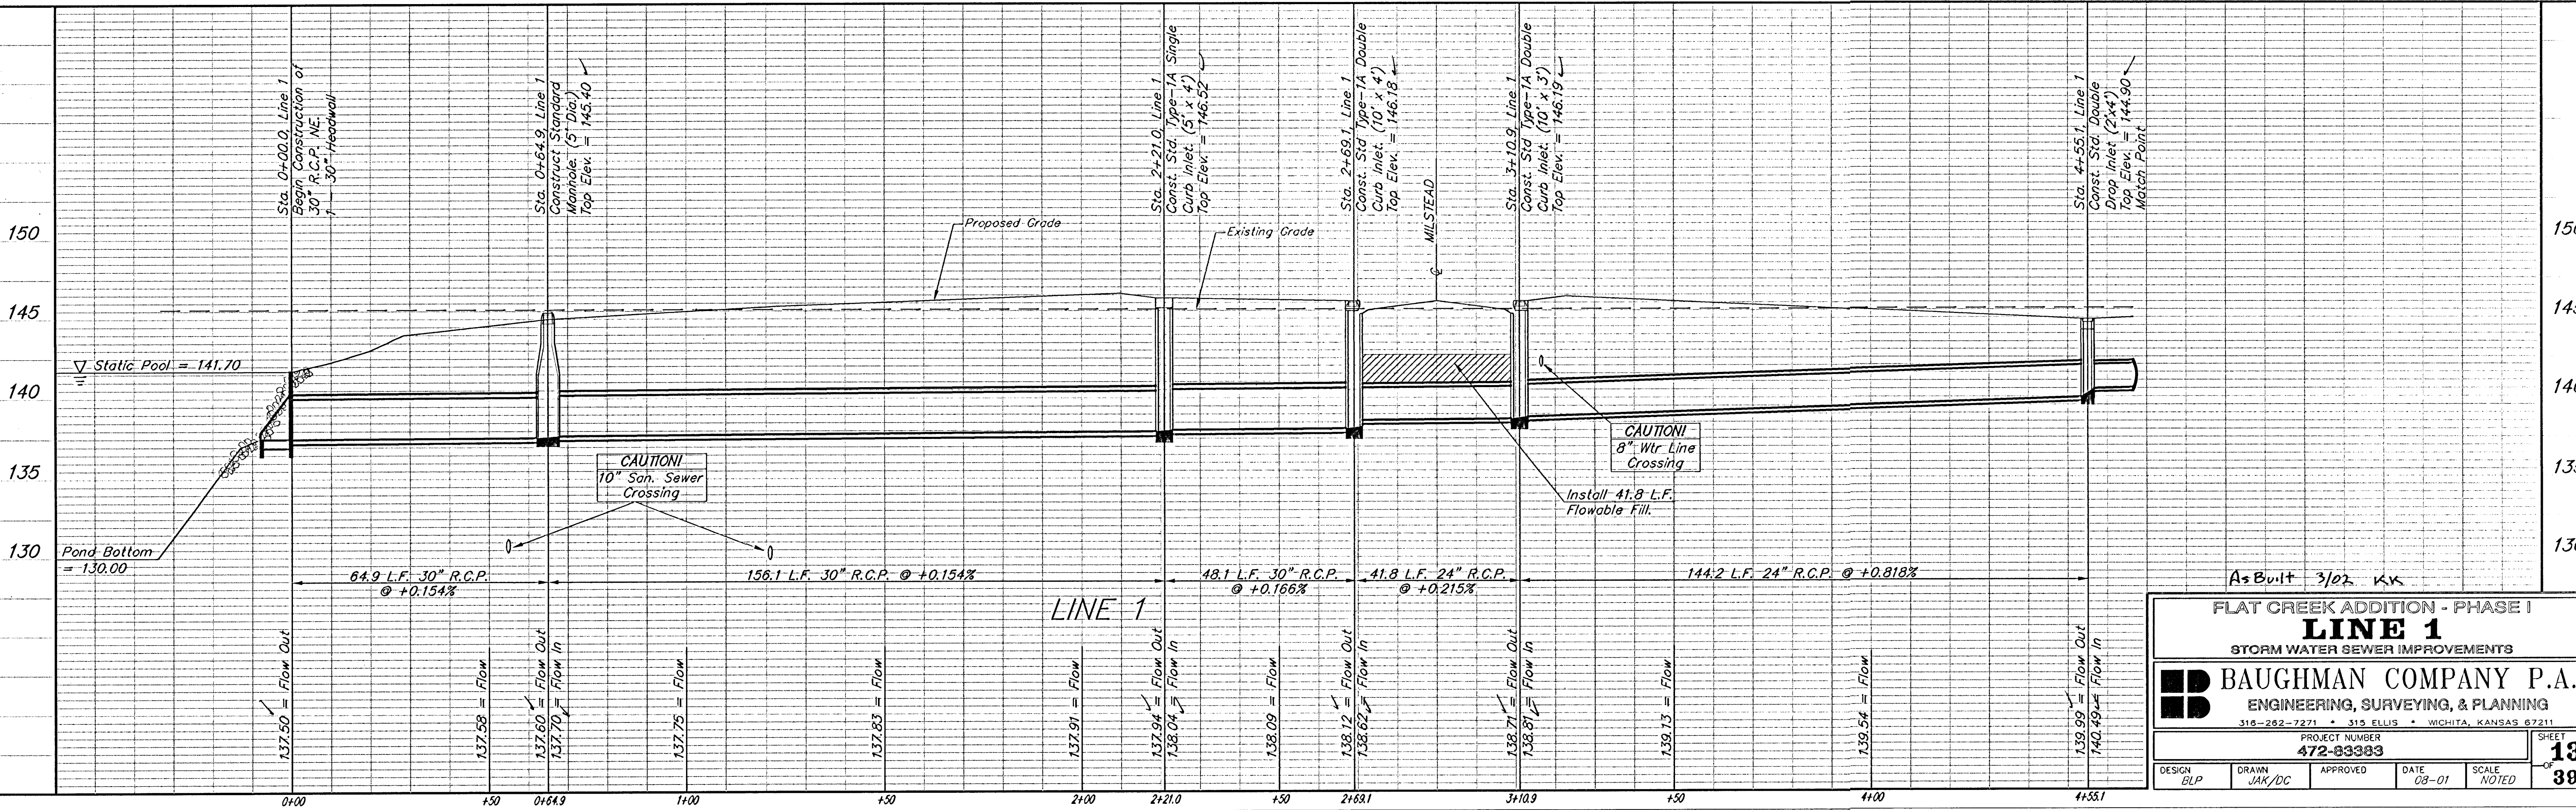


**BENCHMARKS:**  
 BM #1: "□" Cut in top of curb, east return of SE corner of Lotus & Parkridge.  
 Elev. = 145.99 (City Datum)  
 BM #2: "X" Cut on walk at NW corner of Lot 1, Block F, Flat Creek Addition.  
 Elev. = 146.22 (City Datum)  
 BM #3: "□" Cut in top of curb at the NW corner of Lot 1, Block B, Hunter's Ridge Addition.  
 Elev. = 146.63 (City Datum)

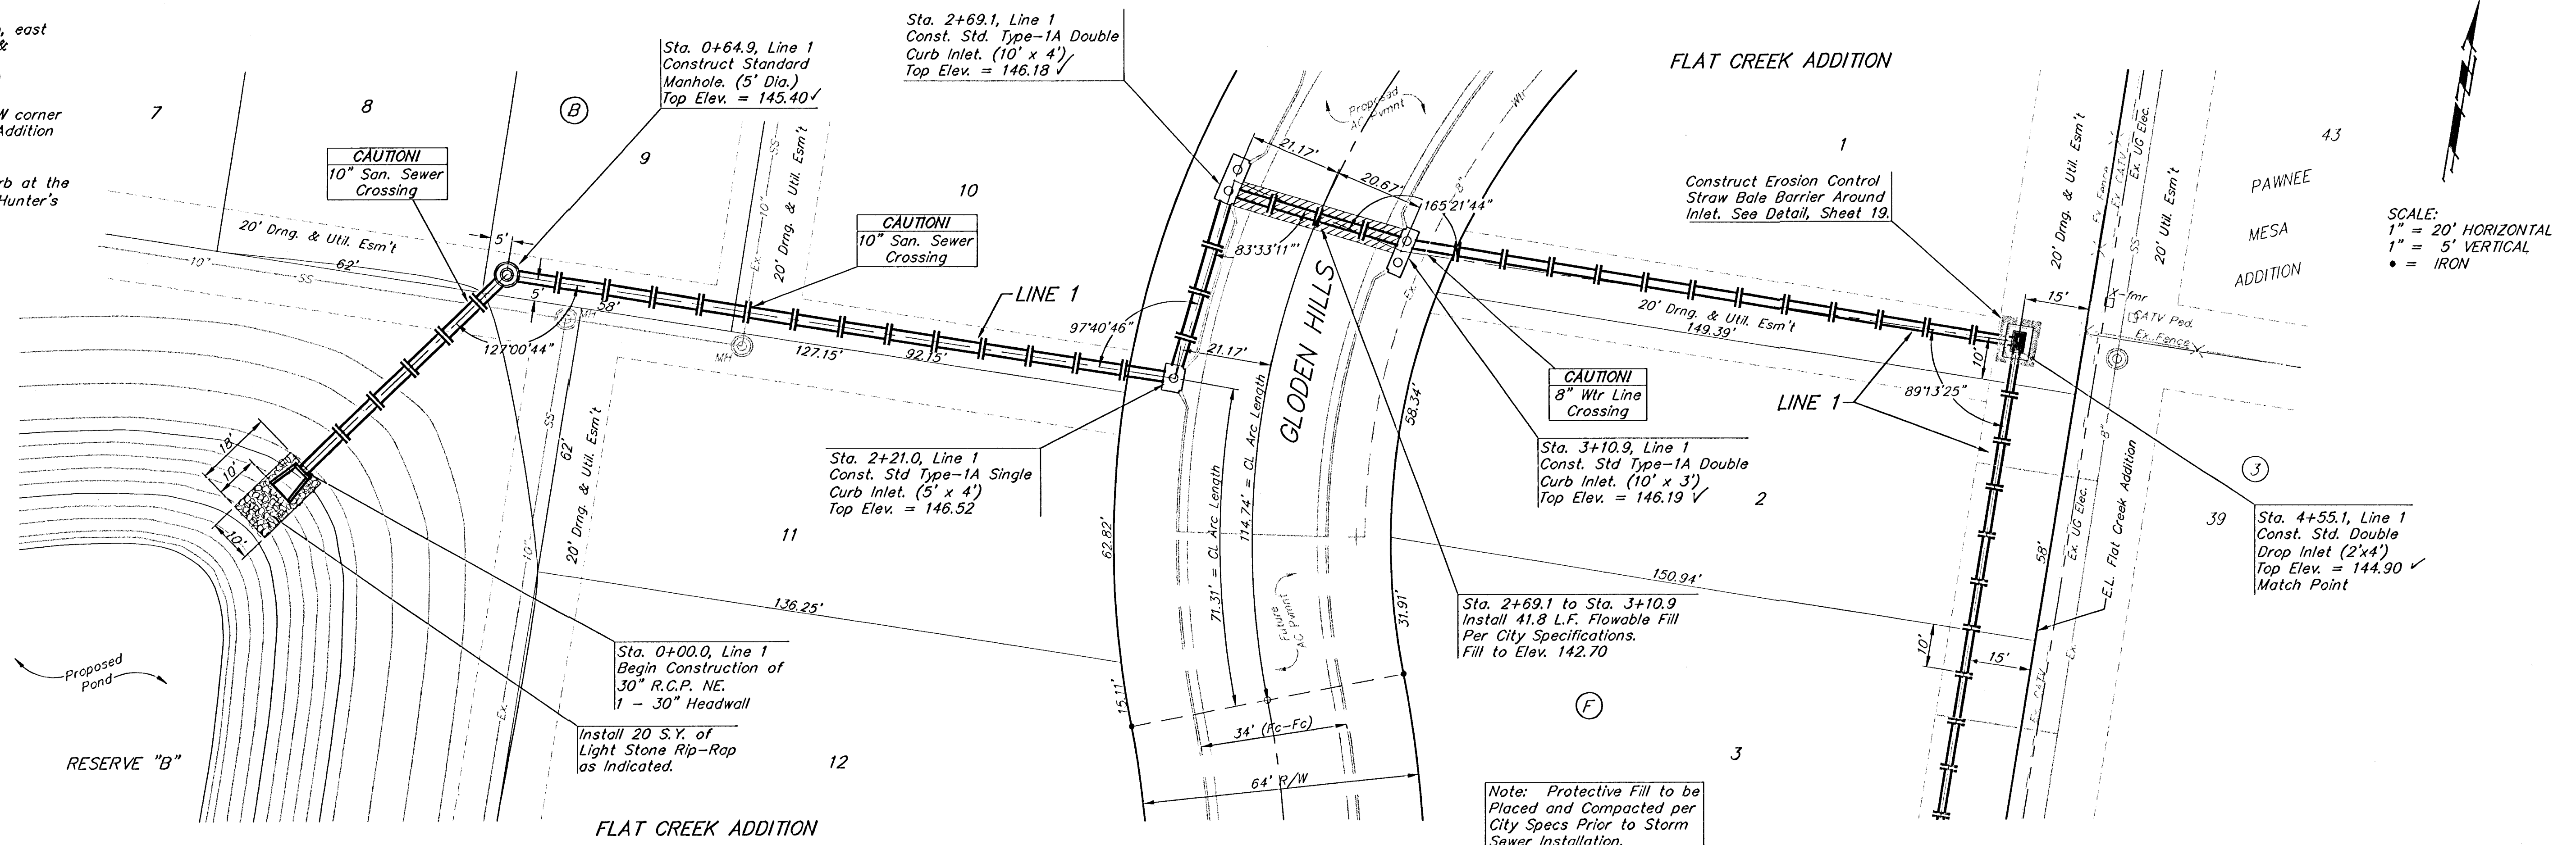

**FLAT CREEK ADDITION - PHASE I**  
**LINE 1**  
 STORM WATER SEWER IMPROVEMENTS

**BAUGHMAN COMPANY P.A.**  
 ENGINEERING, SURVEYING, & PLANNING  
 315-282-7271 • 315 ELLIS • WICHITA, KANSAS 67211

PROJECT NUMBER: 472-83383

DESIGN: BLP | DRAWN: JAK/DC | APPROVED: [ ] | DATE: 08-01 | SCALE: NOTED

As Built 3/02 KKK

SHEET 13 OF 39