


BENCHMARKS:

BM #1: "□" Cut in top of curb, east return of SE corner of Lotus & Parkridge.
Elev. = 145.99 (City Datum)



BM #2: "X" Cut on walk at NW corner of Lot 1, Block F, Flat Creek Addition
Elev. = 146.22 (City Datum)

BM #3: "□" Cut in top of curb at the NW corner of Lot 1, Block B, Hunter's Ridge Addition.
Elev. = 146.63 (City Datum)

Sta. 3+36.98, Line 5
Begin Construction of Ditch As Shown. (See Detail, This Sheet).
Cost of ditch to be incidental to "Site Clearing & Restoration".

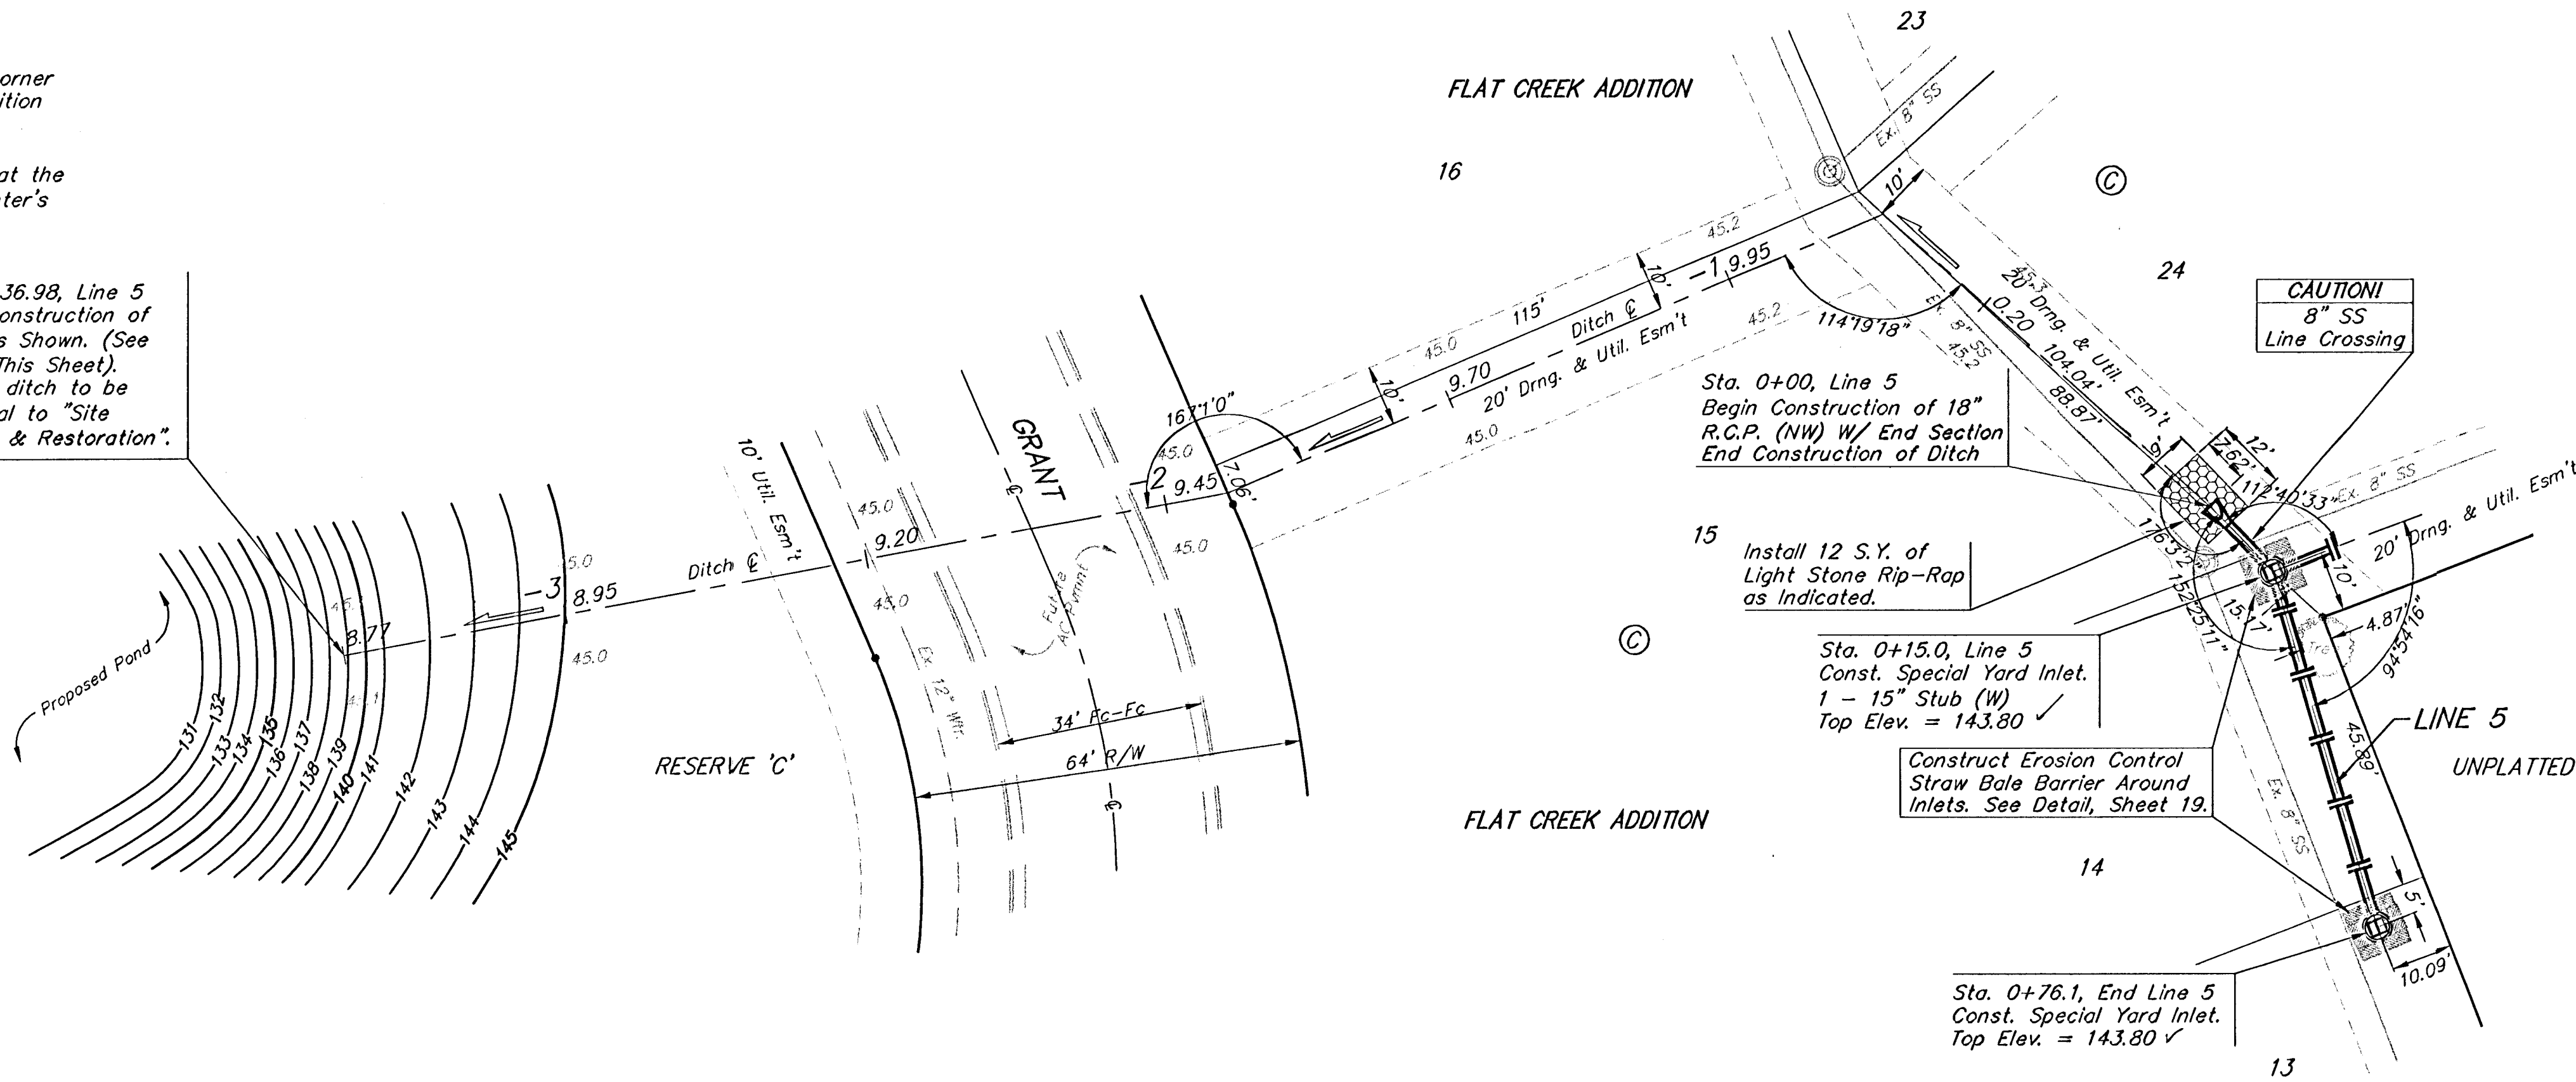

SCALE:
1" = 20' HORIZONTAL
1" = 5' VERTICAL
• = IRON

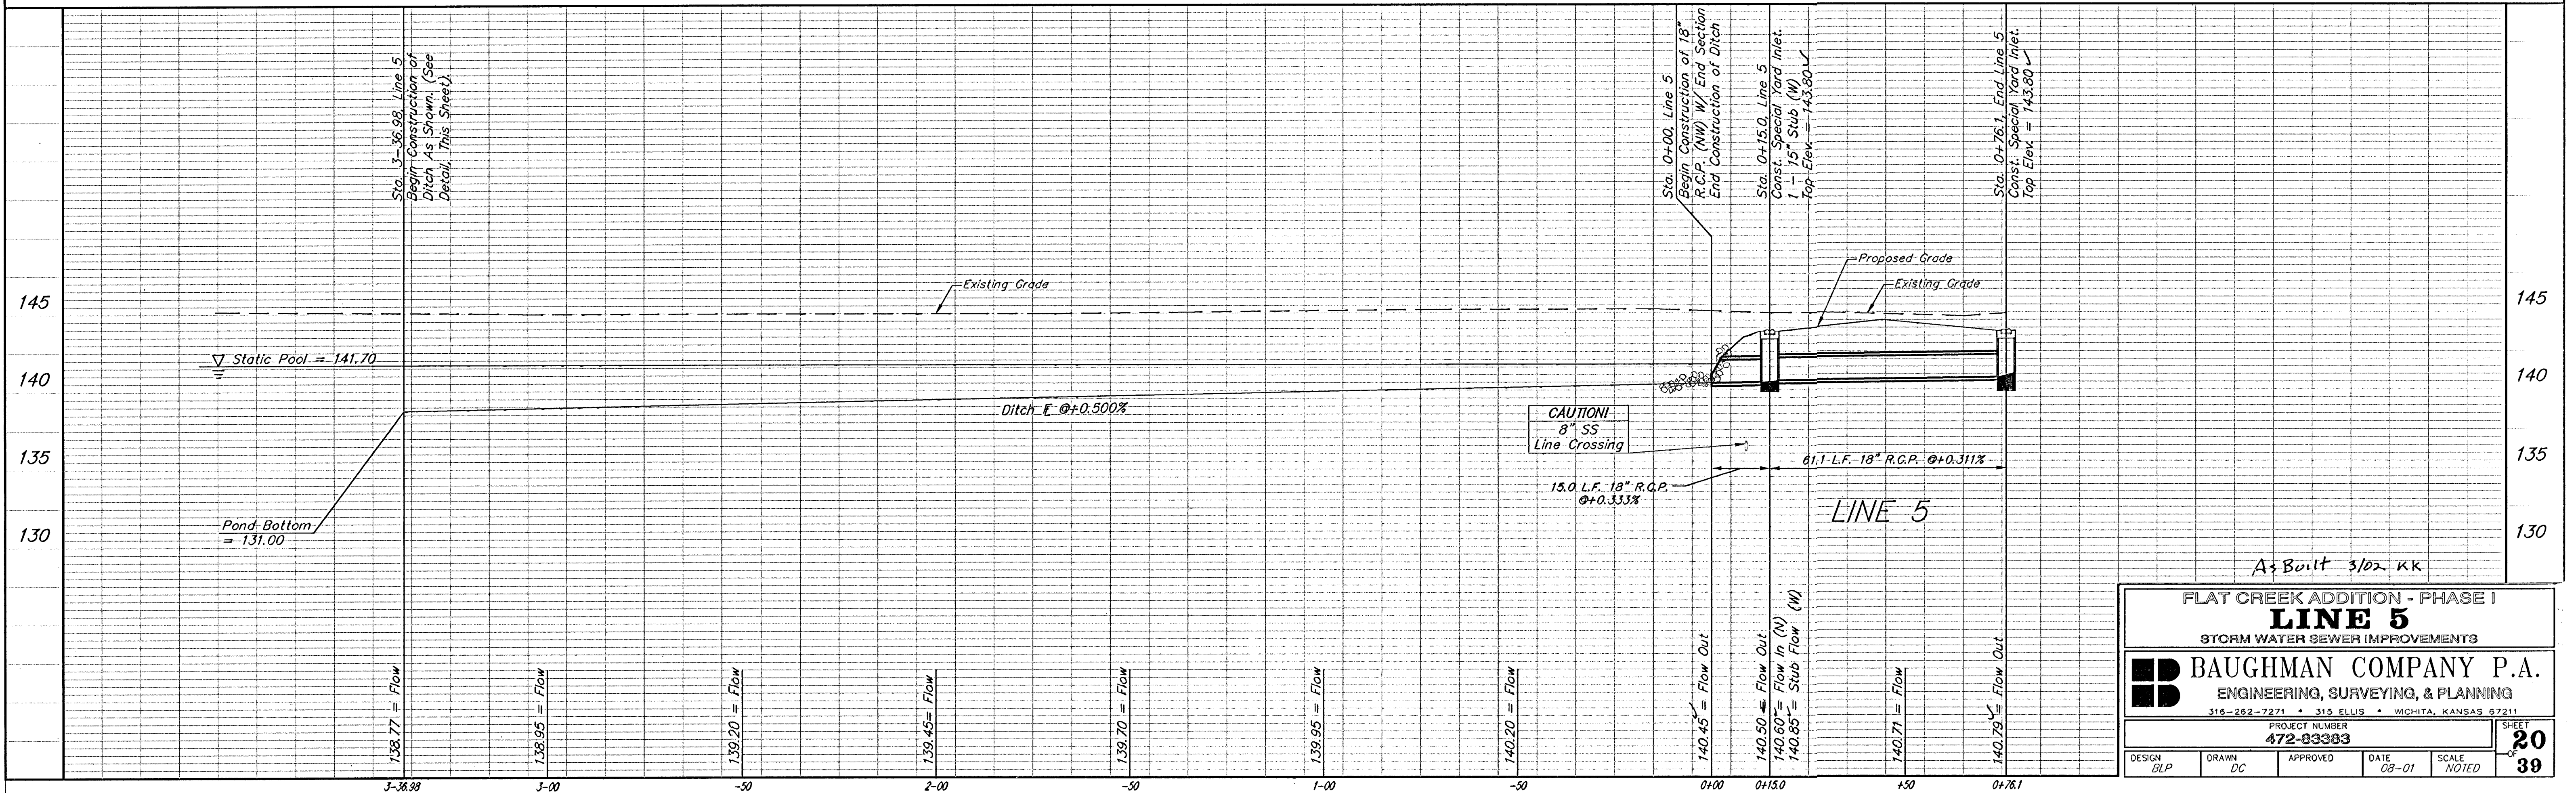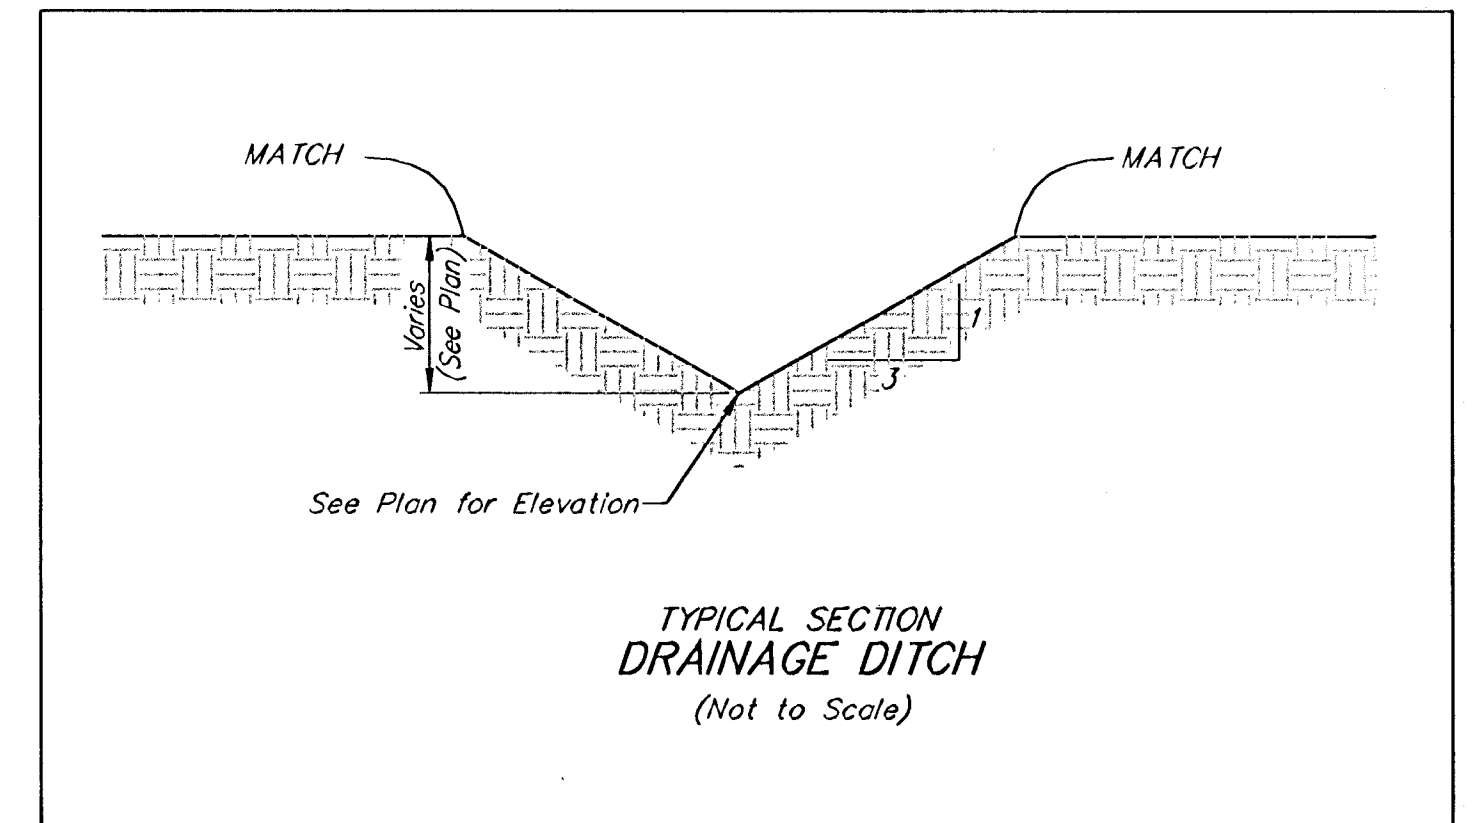

A+Built 3/02 KK

FLAT CREEK ADDITION - PHASE I
LINE 5
STORM WATER SEWER IMPROVEMENTS

BAUGHMAN COMPANY P.A.
ENGINEERING, SURVEYING, & PLANNING
315-262-7271 • 315 ELLIS • WICHITA, KANSAS 67211

PROJECT NUMBER
472-83383

DESIGN BLP	DRAWN DC	APPROVED	DATE 08-01	SCALE NOTED	SHEET 20 OF 39
---------------	-------------	----------	---------------	----------------	-------------------------