

MAIN 20 SOUTHWEST INTERCEPTOR SEWER

CITY OF WICHITA, KANSAS

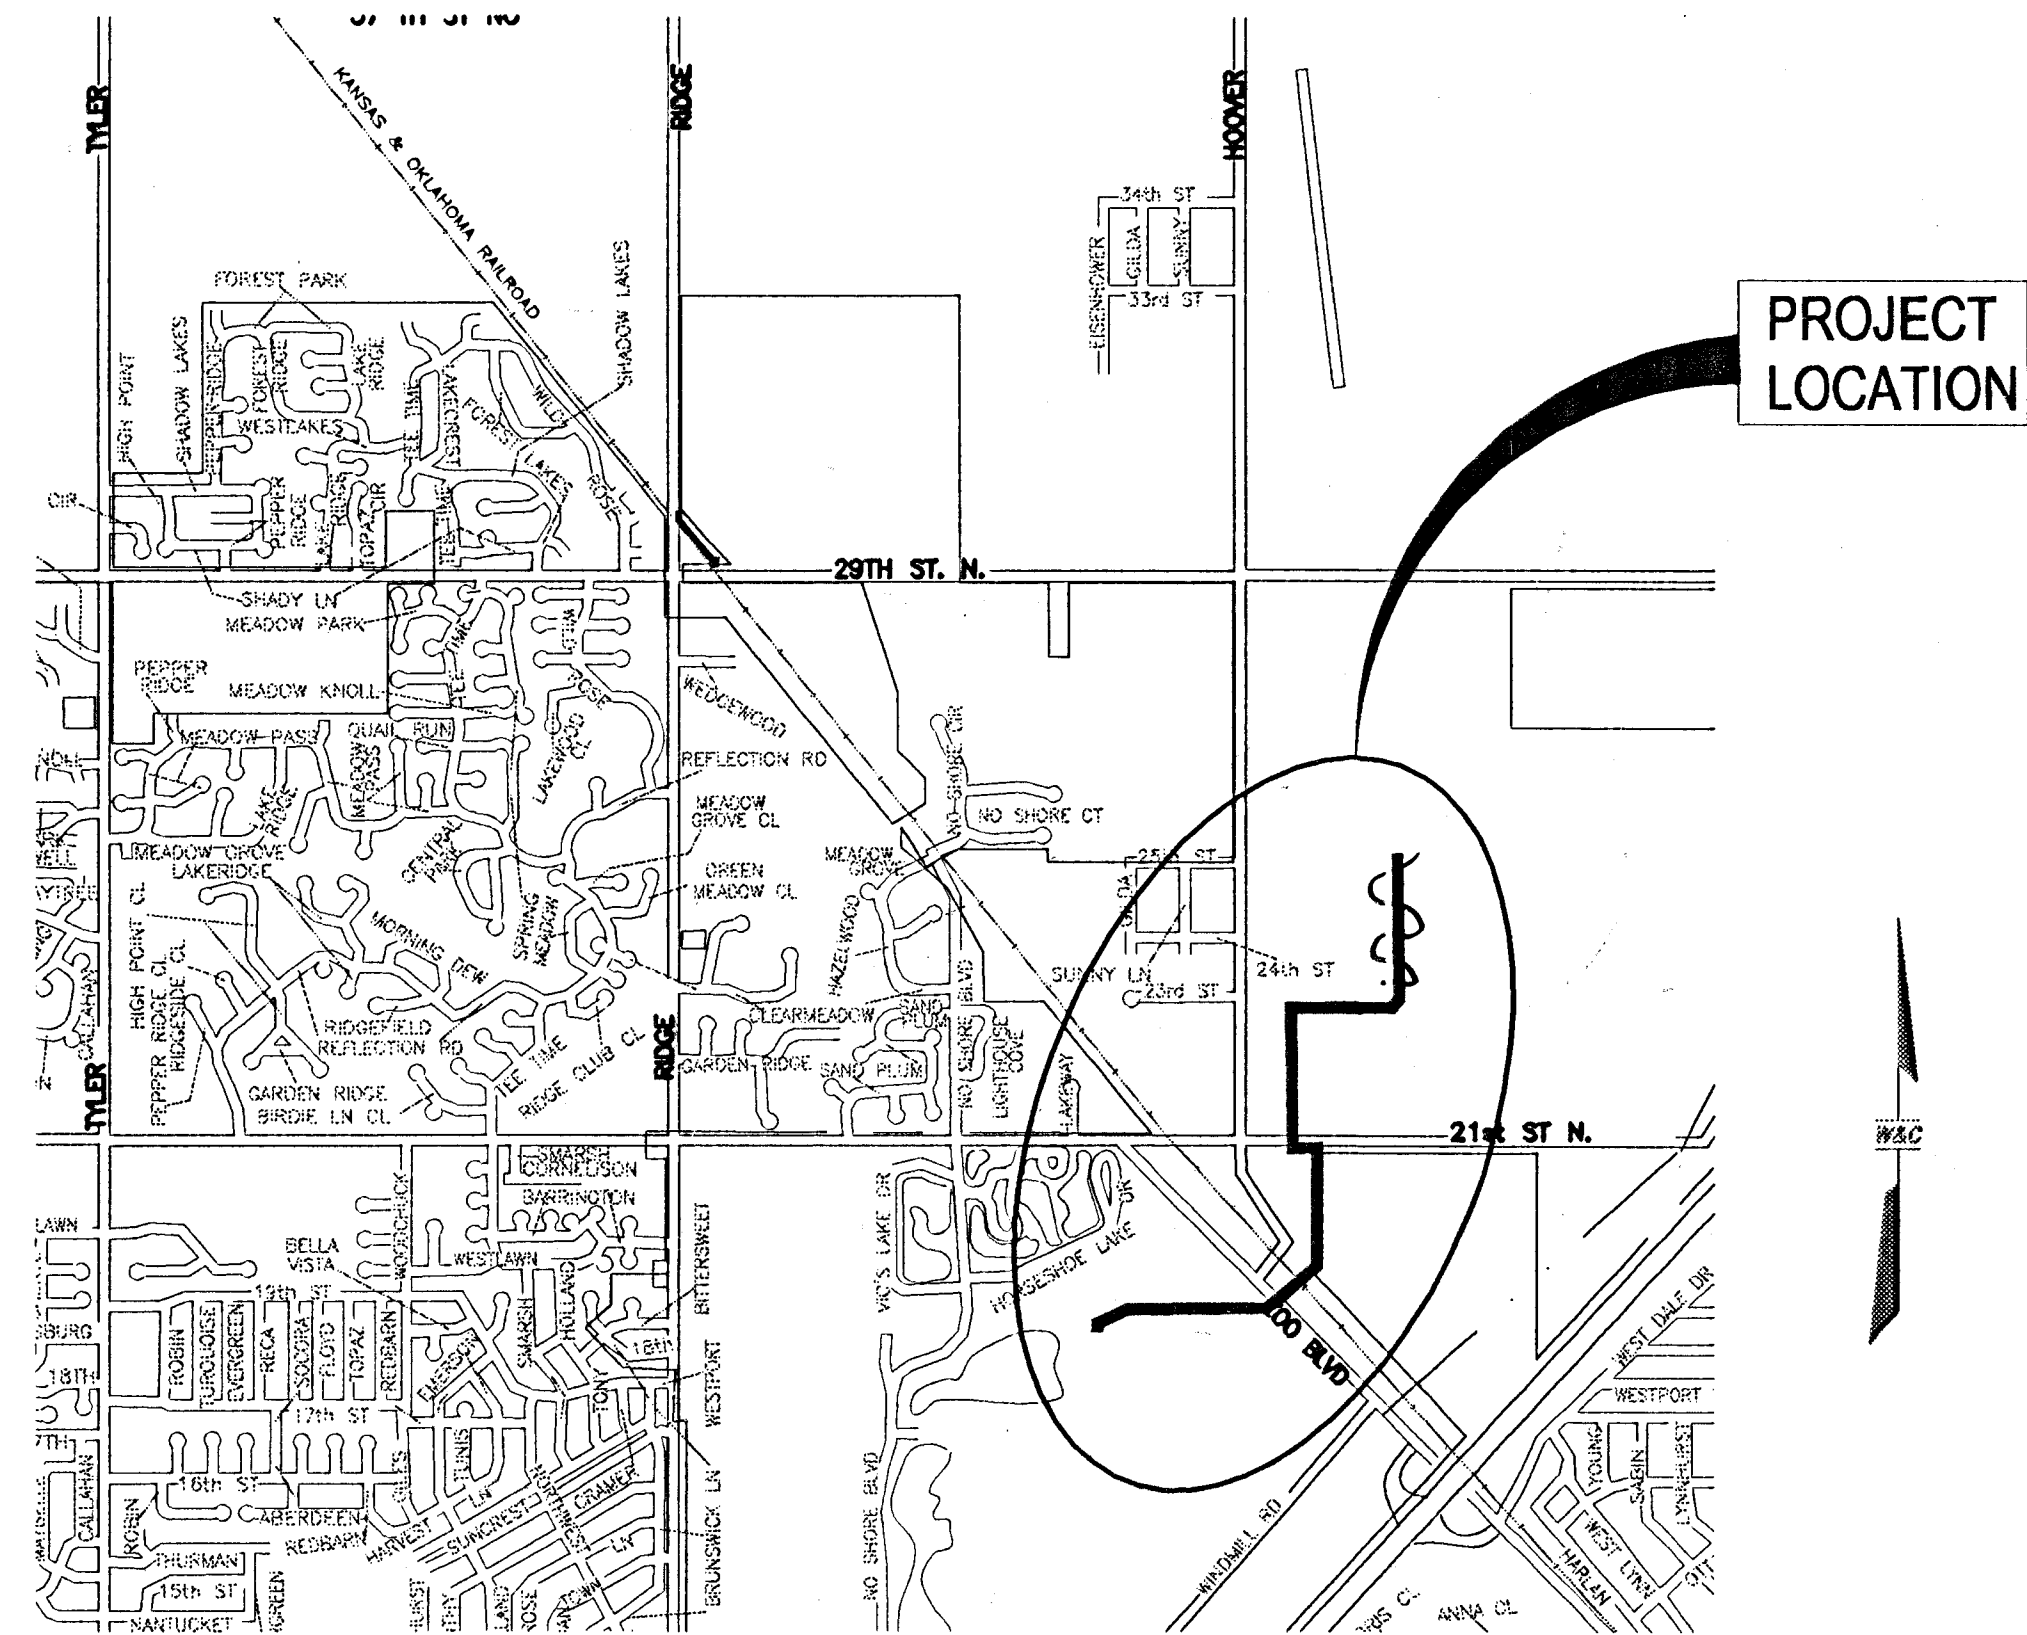
JIM L. ARMOUR, P.E. - CITY ENGINEER

SHEET INDEX

- 1 TITLE, LOCATION MAP, SHEET INDEX & LEGEND
- 2 KEY MAP & GENERAL NOTES
- 3-9 PLAN & PROFILE
- 10-11 MANHOLE DETAILS
- 12-14 EROSION CONTROL BMP DETAILS



Mies Construction, Inc. - Contractor
Shaarer, City - Inspector
Released 9/30/05
As-Built
Stubs
.pdf by JDL 3/14/06

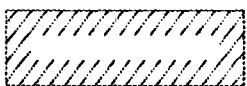
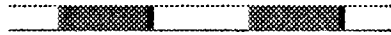
 
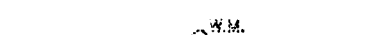


LOCATION MAP

NOT TO SCALE

OCA NO. 744056
CITY OF WICHITA
PROJECT NO. 468-83796
APRIL 2004

LEGEND

SYMBOL	DESCRIPTION
	BUILDING / STRUCTURE
	RAILROAD TRACKS
	EDGE OF PAVEMENT
	CURB AND GUTTER
	GRAVEL SURFACING
	WATER LINE
	WATER METER
	WATER VALVE
	FIRE HYDRANT
	GAS LINE
	GAS REGULATOR
	GAS VALVE
	STORM WATER SEWER LINE
	STORM WATER INLET
	MANHOLE



WILSON & COMPANY
Engineers & Architects

Revised 4/12/05 P.Y.