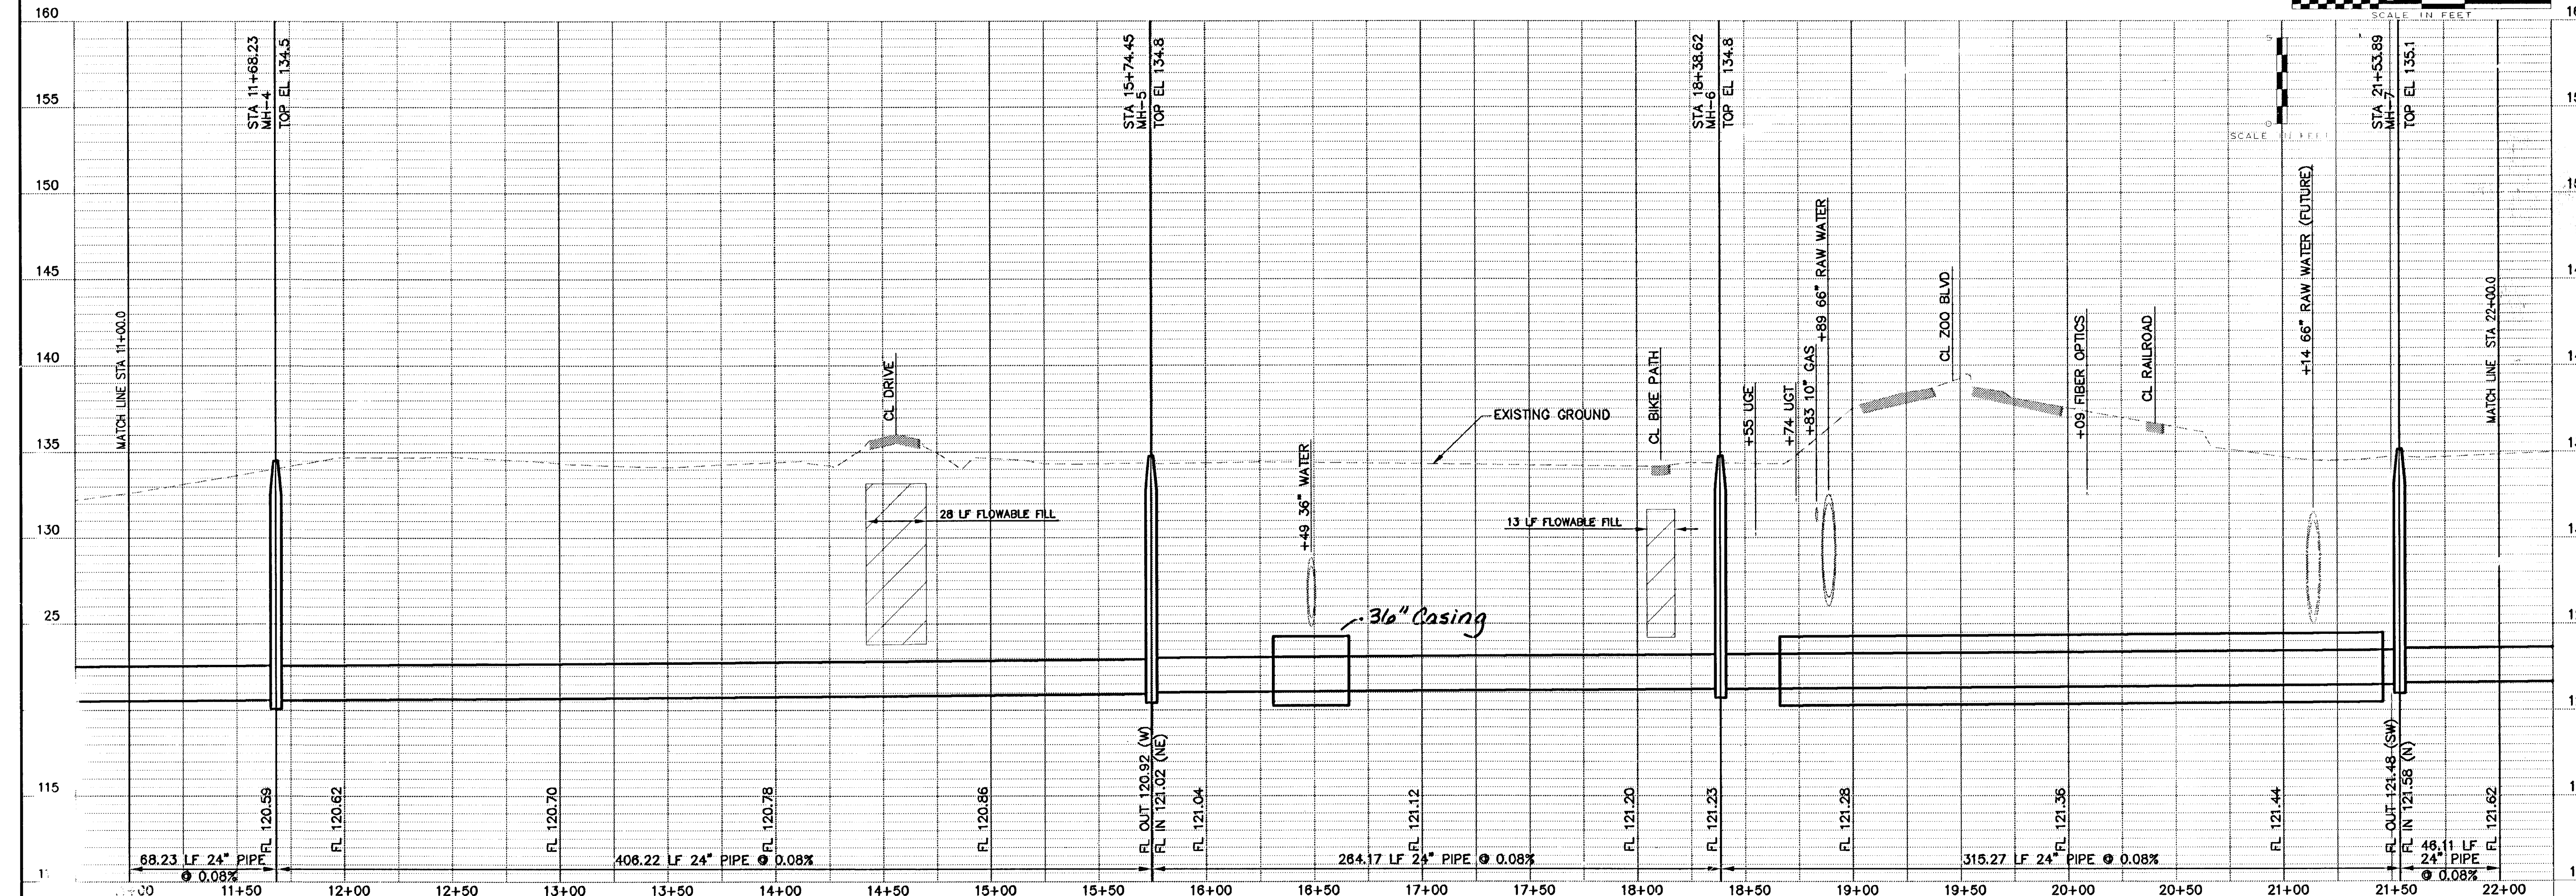


[illegible]

**WILSON
& COMPANY**

CITY OF WICHITA, KANSAS
MAIN 20 SOUTHWEST INTERCEPTOR SEWER
466-63466
PLAN & PROFILE
STA. 11+00.0 TO STA. 22+00.0

DESIGN	CHECKED
DWH	JLM
DRAWN	
MEK/KMD	
DATE	
APRIL 2004	
FILE NO.	
X1460002	
SHEET NO.	

WILSON
& COMPANY
WICHITA, KANSAS