

SSMH  
 TOP = 1369.26  
 FL N = 1359.67  
 FL W = 1359.52  
 FL E = 1359.52


STA. 11+83.6 LINE 2  
 BL STA. 19+59.2, 42.0' LT.  
 REMOVE EXISTING MANHOLE.  
 CONSTRUCT STANDARD TYPE 'P' MH  
 TOP ELEV = ~~1369.26~~ 1369.26

CAUTION !!! EXISTING GAS MAIN.  
 COORDINATE CONSTRUCTION WITH  
 KANSAS GAS SERVICE.

REMOVE/REPLACE 8" PIPE TO PROPERTY LINE.  
 CONNECT TO EXISTING USING CASCADE  
 MODEL CSST OR APPROVED COUPLING.

STA. 15+11.7 LINE 2  
 BL STA. 16+31.1, 41.4' LT.  
 REMOVE EXISTING MANHOLE.  
 CONSTRUCT STANDARD TYPE 'P' MH  
 TOP ELEV = ~~1371.15~~ 1371.15

SSMH  
 TOP = 1369.26  
 FL N = 1361.66  
 FL W = 1359.52  
 FL E = 1359.52

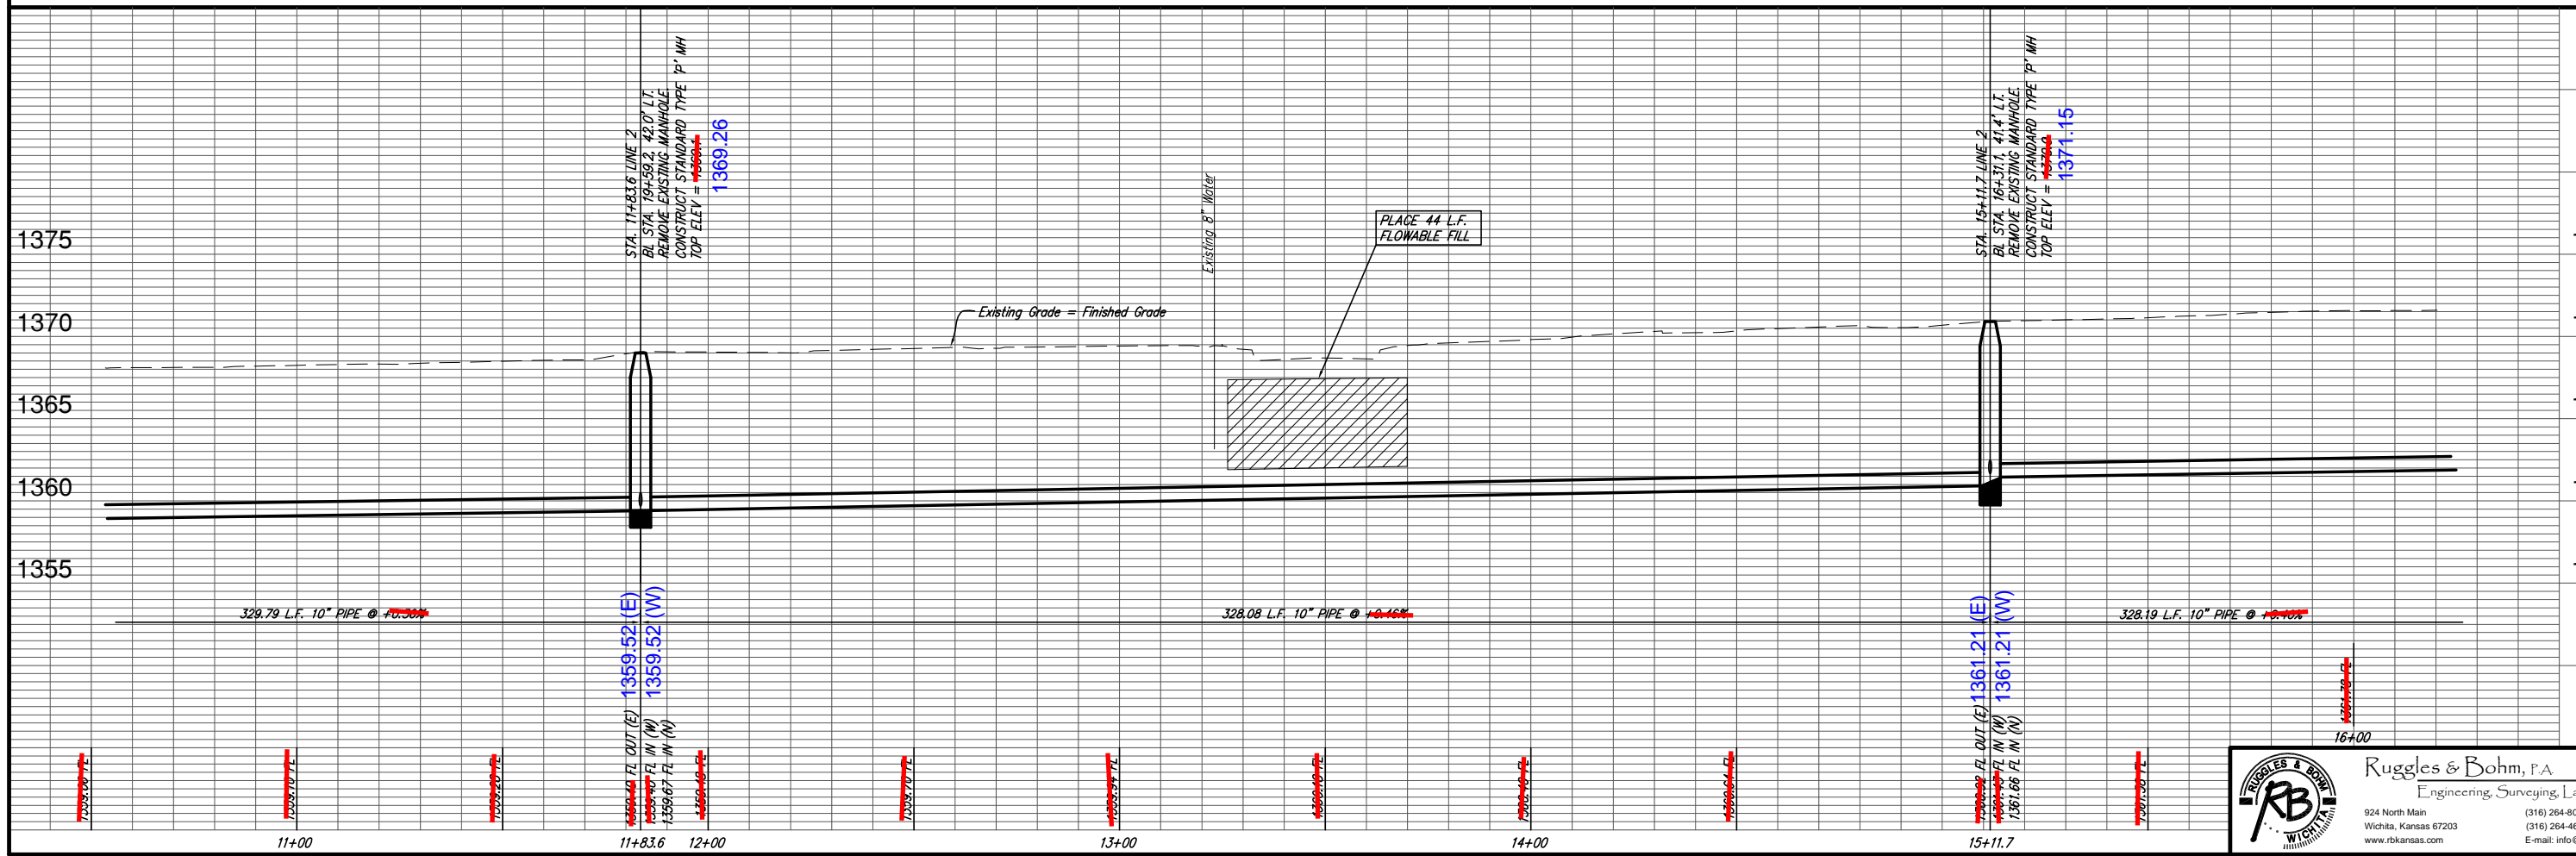

STA. 11+83.6 LINE 2  
 BL STA. 19+59.2, 42.0' LT.  
 REMOVE EXISTING MANHOLE.  
 CONSTRUCT STANDARD TYPE 'P' MH  
 TOP ELEV = ~~1369.26~~ 1369.26

STA. 15+11.7 LINE 2  
 BL STA. 16+31.1, 41.4' LT.  
 REMOVE EXISTING MANHOLE.  
 CONSTRUCT STANDARD TYPE 'P' MH  
 TOP ELEV = ~~1371.15~~ 1371.15

PROJECT NUMBER 468-83729	DESIGN KWL	DRAWN RA	REVIEW RA
DRAWNFILE sanitary sewer (ss sht 4)	DATE Aug. 22, 2005	UTILITY	REVIEW
SANITARY SEWER IMPROVEMENTS LINE 2		WICHITA, KANSAS	
RB JOB 2136X	SHEET 5	OF 15	

**Ruggles & Bohm, P.A.**  
 Engineering, Surveying, Land Planning  
 924 North Main (316) 264-8008  
 Wichita, Kansas 67203 (316) 264-4621 fax  
 www.rbkansas.com E-mail: info@rbkansas.com