




SCALE 1" = 20'

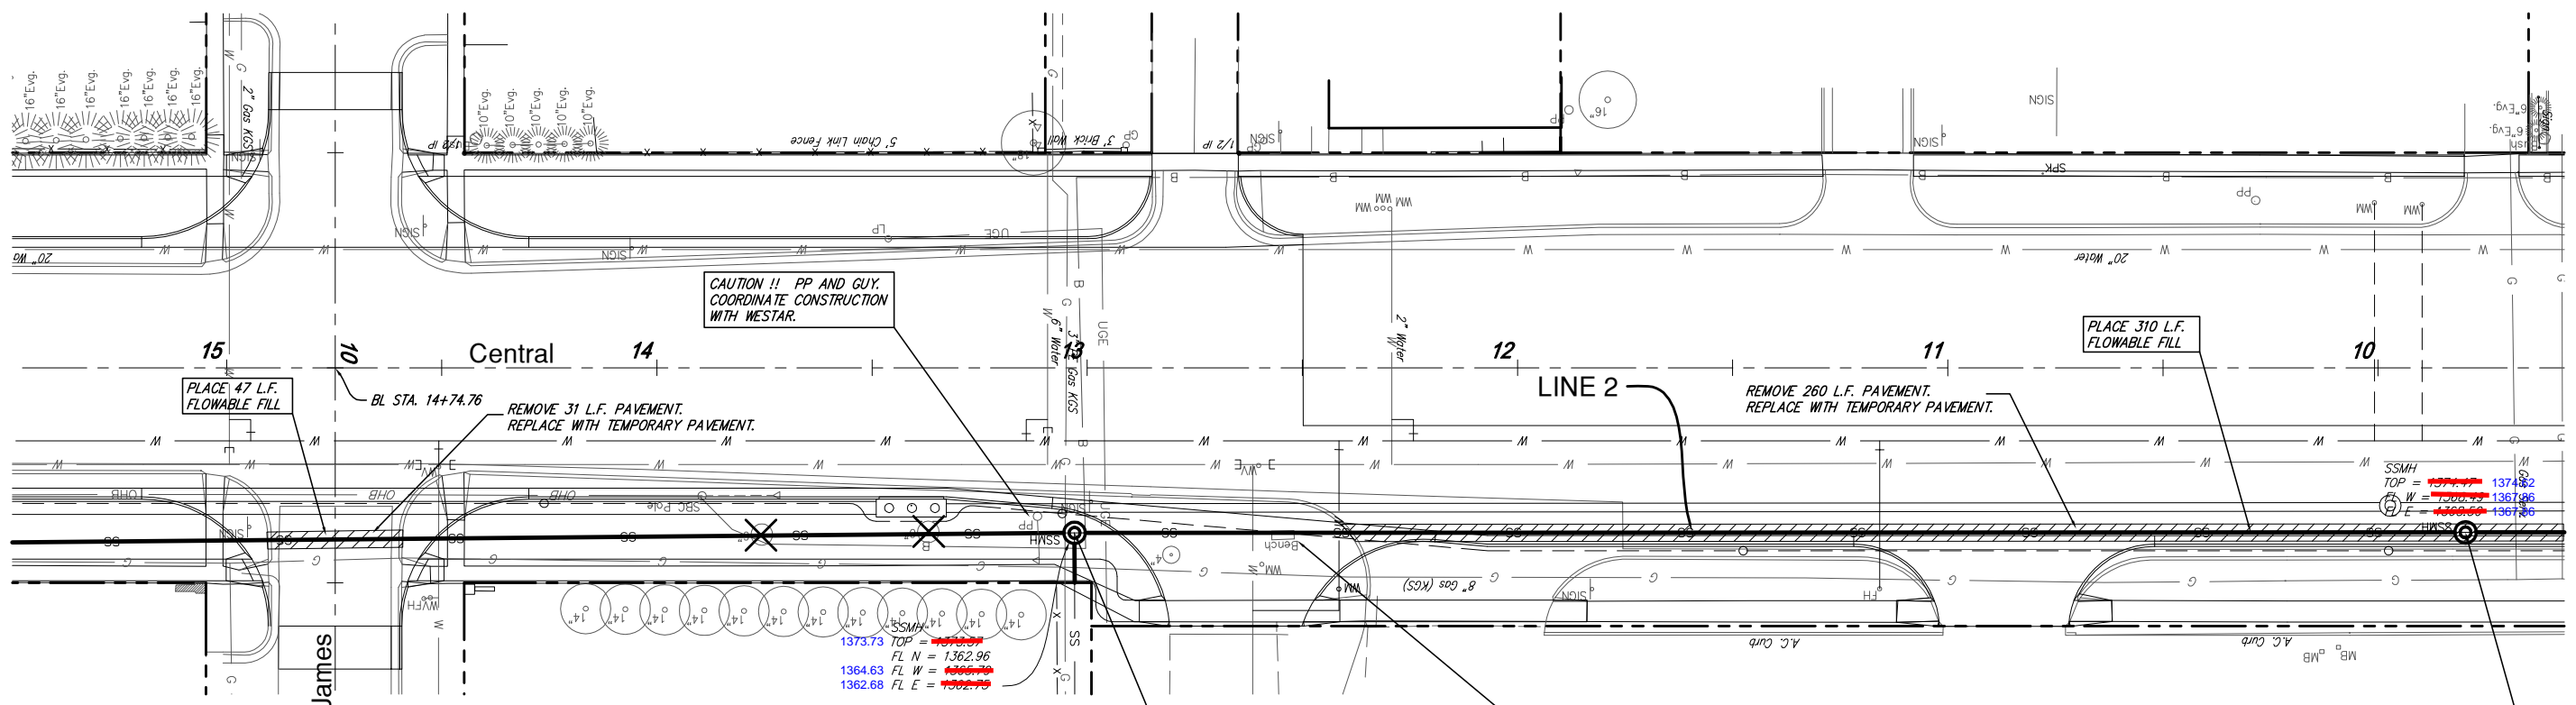


CAUTION !! PP AND GUY.
COORDINATE CONSTRUCTION
WITH WESTAR.

REMOVE/REPLACE 8" PIPE TO PROPERTY LINE.
CONNECT TO EXISTING USING CASCADE
MODEL CSST OR APPROVED COUPLING.

STA. 18+39.8 LINE 2
BL STA. 13+02.9, 38.4' LT.
REMOVE EXISTING MANHOLE.
CONSTRUCT STANDARD TYPE 'P' MH
TOP ELEV = ~~1373.9~~ 1373.73

BENCH TO BE REMOVED BY W.M.T.A.
PRIOR TO CONSTRUCTION. W.M.T.A. TO
RESET BENCH AFTER CONSTRUCTION.

STA. 21+63.2 LINE 2
BL STA. 9+80.1, 38.4' LT.
REMOVE EXISTING MANHOLE.
CONSTRUCT STANDARD TYPE 'P' MH
TOP ELEV = ~~1374.6~~ 1374.62

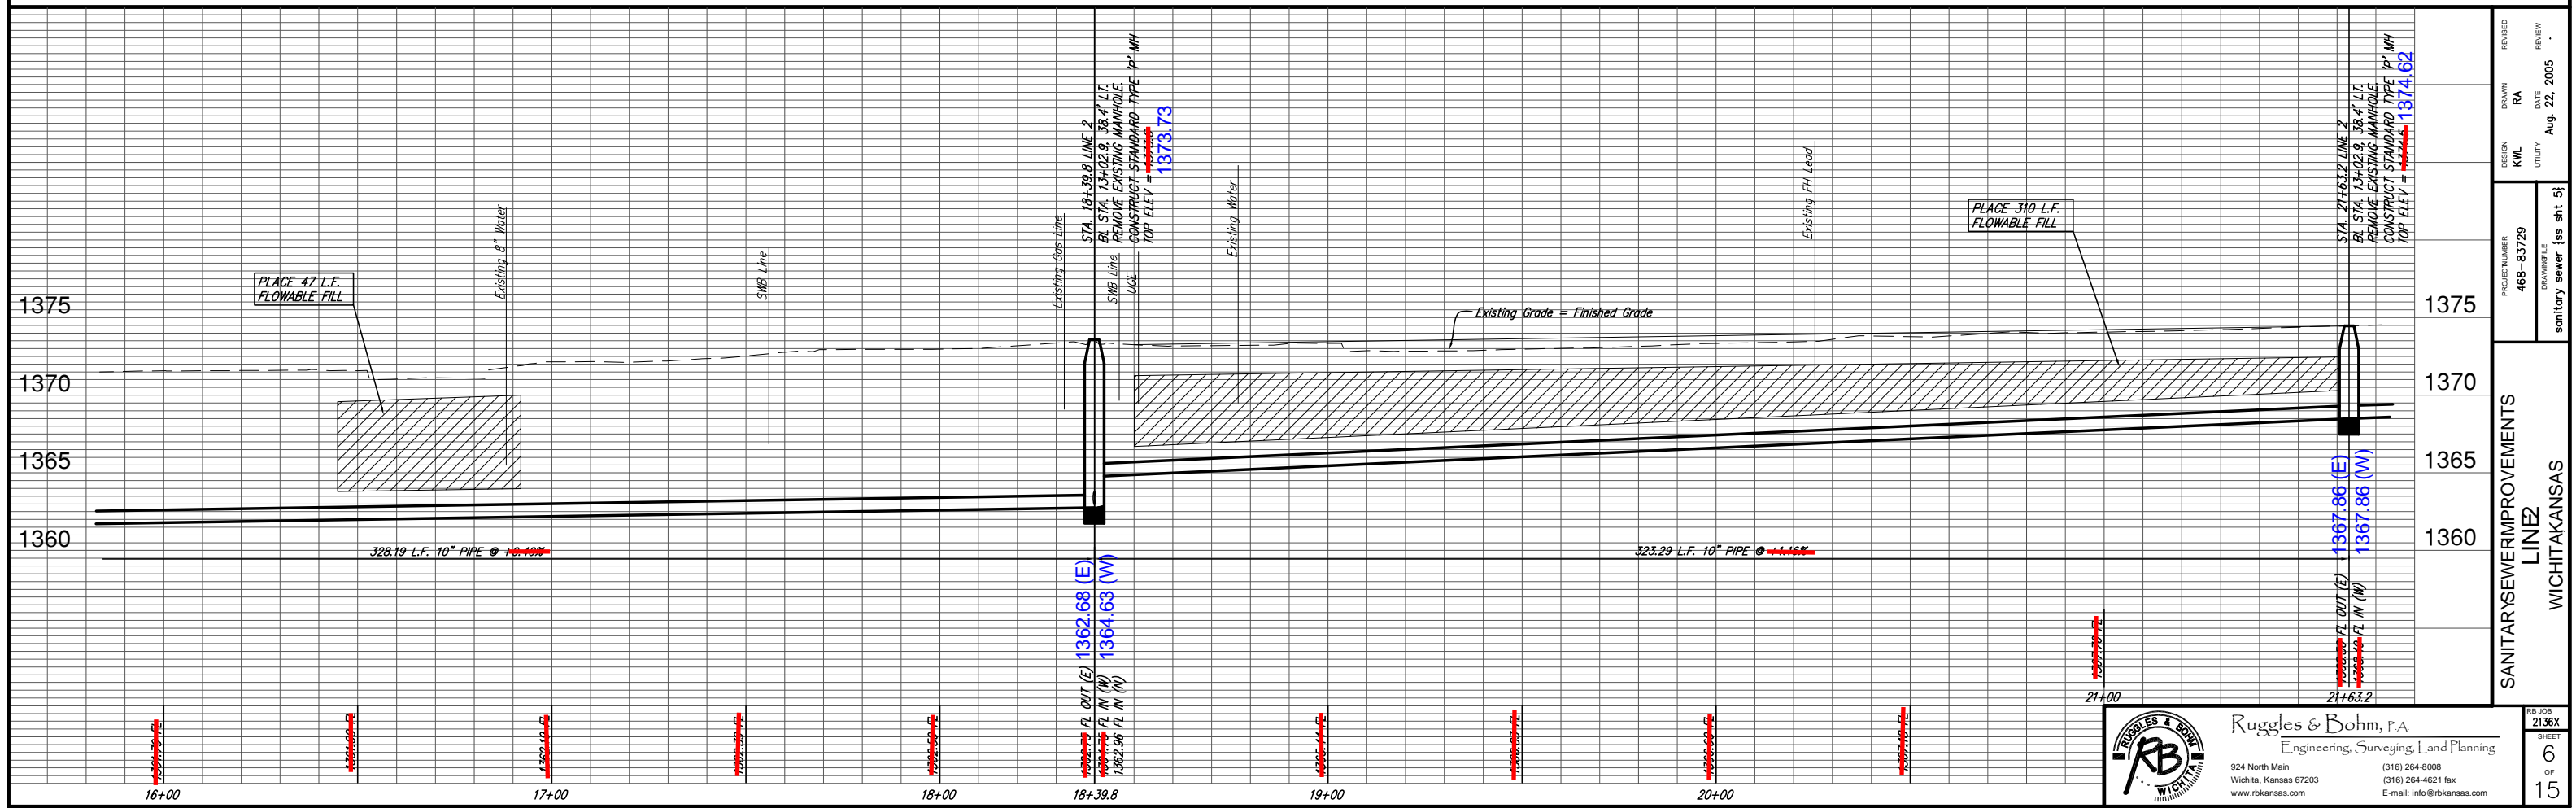

PLACE 47 L.F.
FLOWABLE FILL

PLACE 310 L.F.
FLOWABLE FILL

PROJECT NUMBER 468-83729	DESIGN KWL	DRAWN RA	REVIEW
DRAWN FILE sanitary sewer (ss sht 5)	DATE Aug. 22, 2005	UTILITY	
SANITARY SEWER IMPROVEMENTS LINE 2		WICHITA, KANSAS	

RUGLES & BOHM, P.A.
Engineering, Surveying, Land Planning

924 North Main
Wichita, Kansas 67203
www.rbkansas.com

(316) 264-0008
(316) 264-4621 fax
E-mail: info@rbkansas.com