





SCALE 1" = 20'

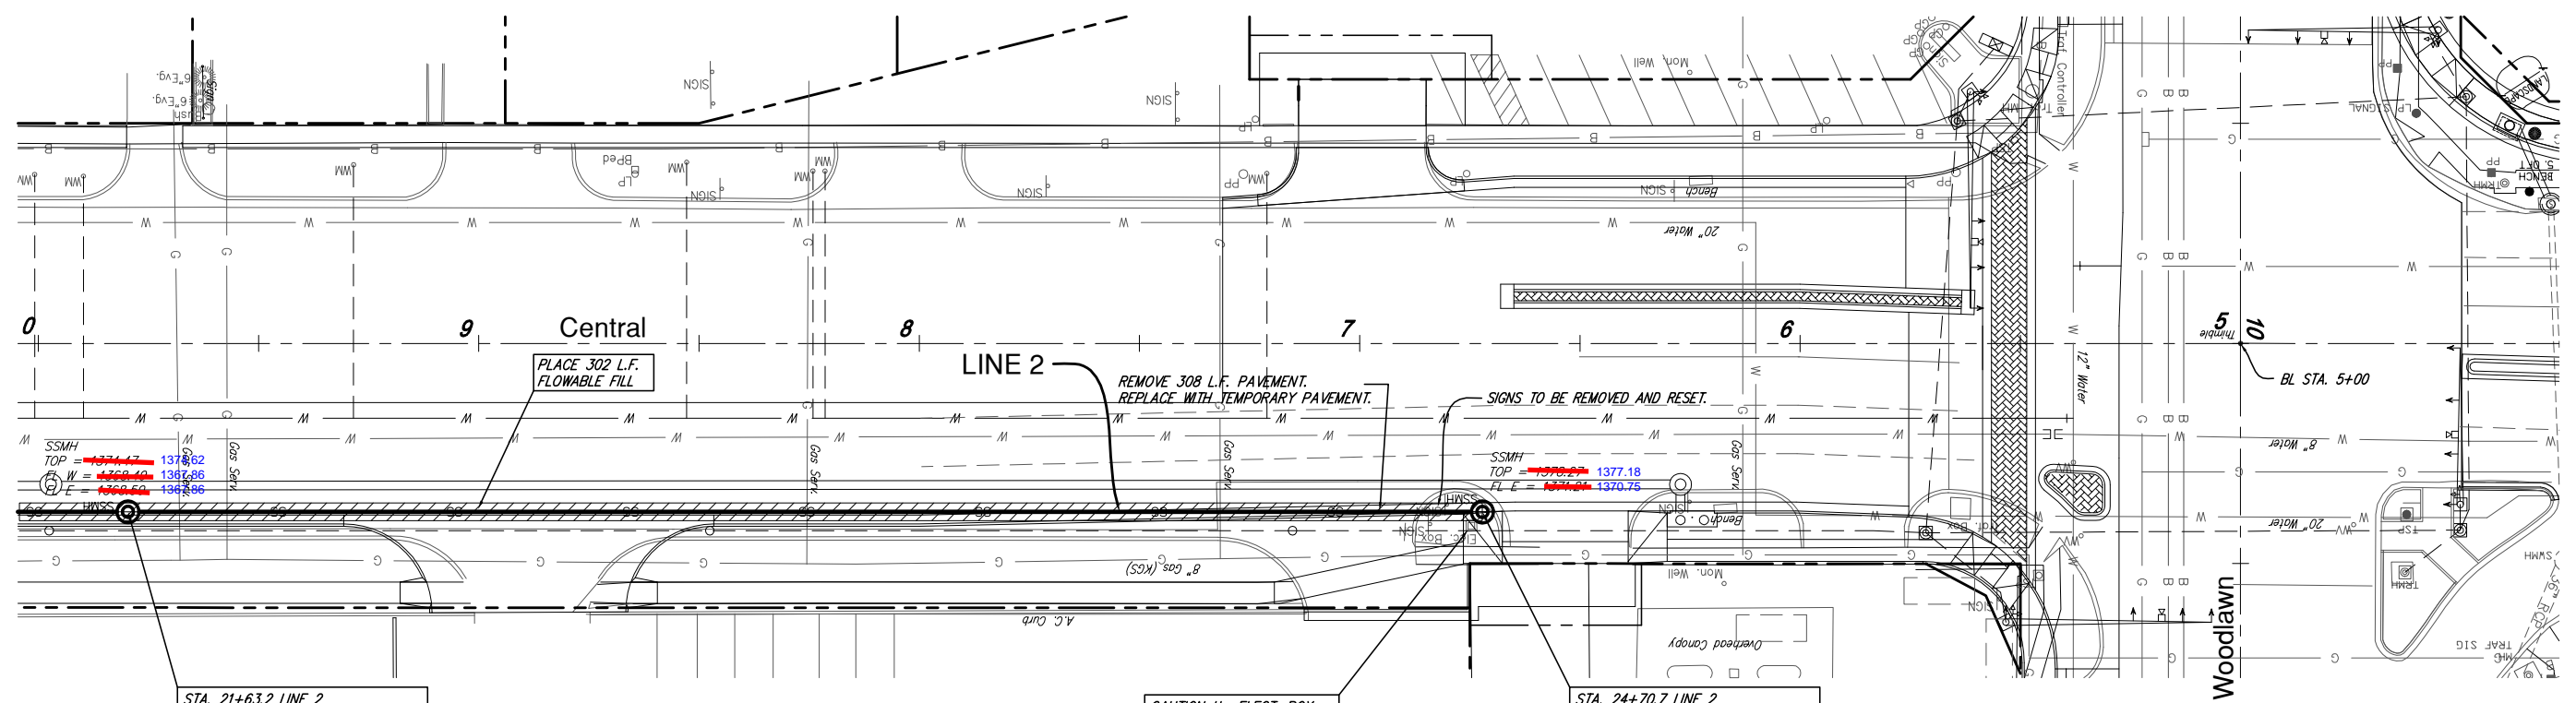

STA. 21+63.2 LINE 2
BL STA. 9+80.1, 38.4' LT.
REMOVE EXISTING MANHOLE.
CONSTRUCT STANDARD TYPE 'P' MH
TOP ELEV = ~~1374.86~~ 1374.62

CAUTION !! ELECT. BOX.
COORDINATE CONSTRUCTION
WITH WESTAR.

STA. 24+70.7 LINE 2
BL STA. 9+80.1, 38.4' LT.
REMOVE EXISTING MANHOLE.
CONSTRUCT STANDARD TYPE 'P' MH
TOP ELEV = ~~1377.18~~ 1377.18

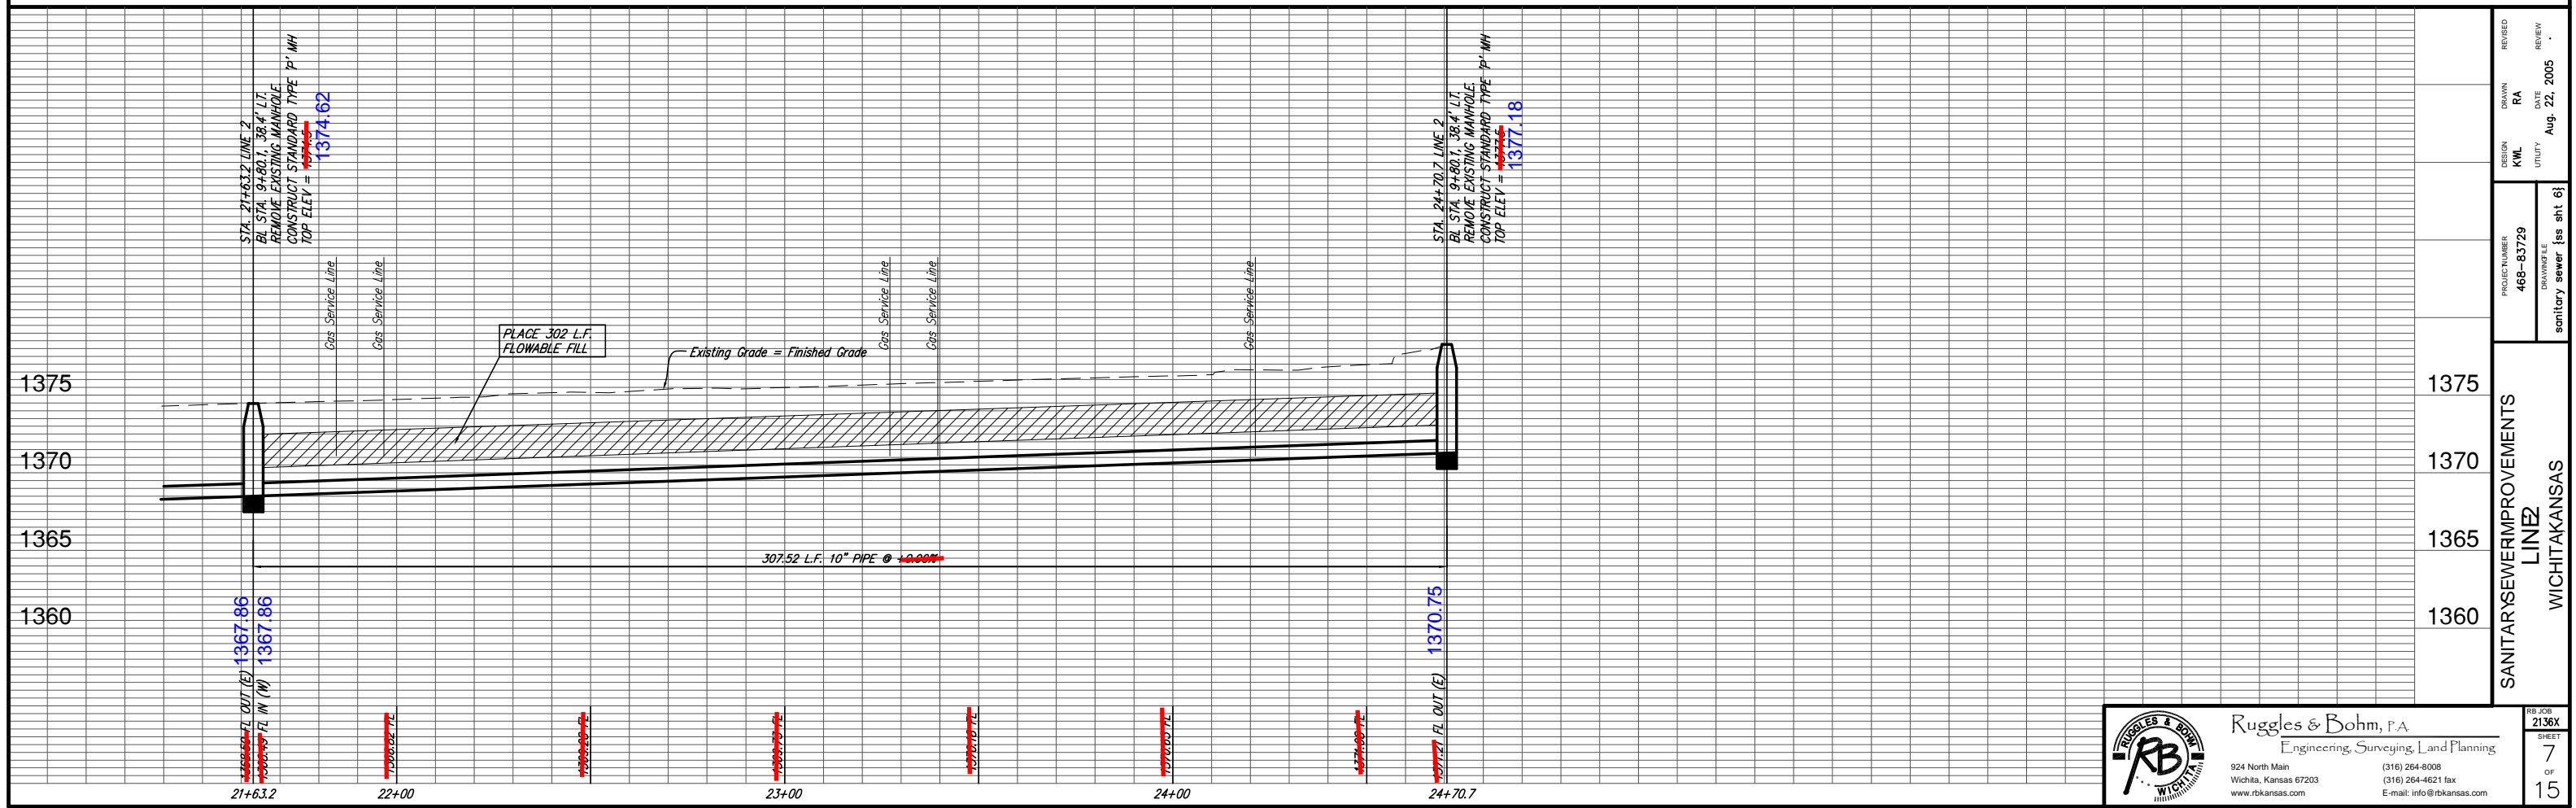

PROJECT NUMBER 468-83729	DESIGN KWL	DRAWN RA	REVIEW RA
DRAWN FILE sanitary sewer (ss sht 6)	DATE Aug. 22, 2005	UTILITY	
SANITARY SEWER IMPROVEMENTS LINE 2		WICHITA, KANSAS	
1360	1365	1370	1375
21+63.2	22+00	23+00	24+00