


THE CITY OF WICHITA, KANSAS

CITY OF WICHITA PROJECT NO. 468-84124

JAMES L. ARMOUR, P.E. - CITY ENGINEER

Nowak Construction Co., Inc.- Contractor
Strothman, City- Inspector
Released 7/3/06
As-Built
Risers & Studs
.pdf by JDL 11/13/06

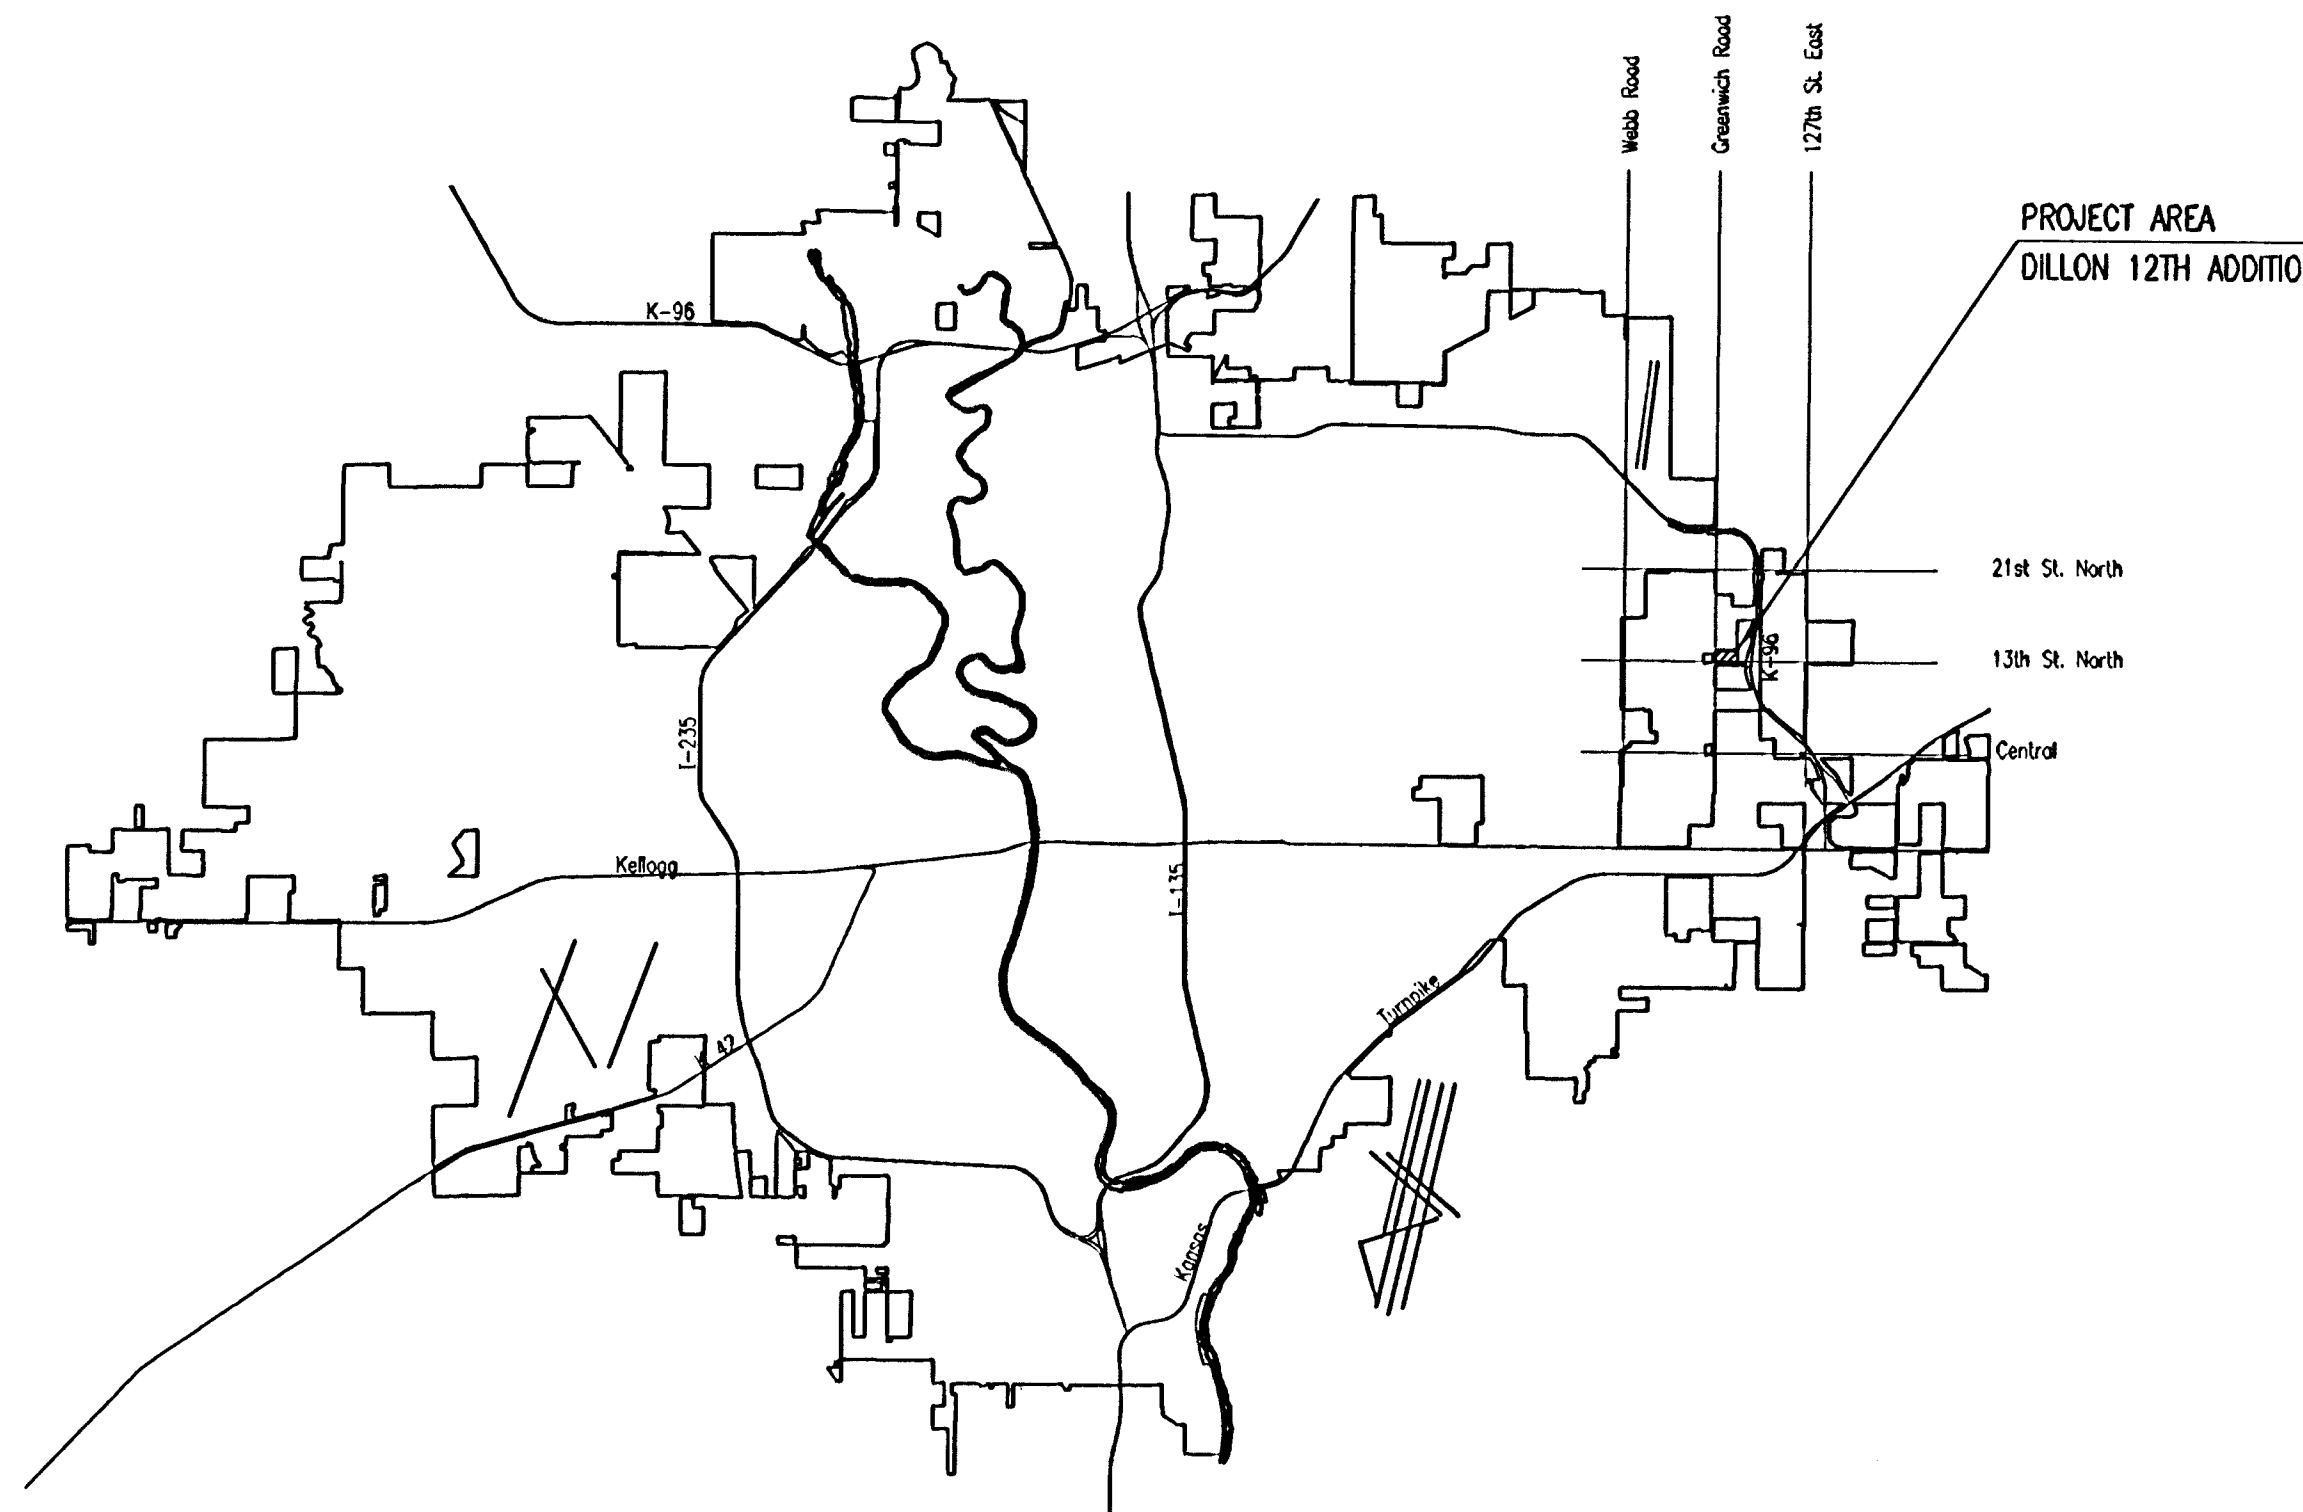

INDEX OF SHEETS

SHEET NO. 1	TITLE SHEET
SHEET NO. 2	KEY MAP AND GENERAL NOTES
SHEET NO. 3	PLAT
SHEET NO. 4	PROJECT COORDINATES
SHEET NO. 5-7	PLAN/PROFILE
SHEET NO. 8	TYPE "P" MANHOLE DETAILS
SHEET NO. 9	FRAME & COVER DETAILS
SHEET NO. 10	RISER DETAILS
SHEET NO. 11-14	SOIL EROSION BMP DETAILS

CONSTRUCTION/SEQUENCE SCHEDULE

CONTRACTOR SHALL COORDINATE THE INSTALLATION OF SANITARY SEWER ACROSS GREENWICH ROAD WITH THE CONTRACTOR FOR THE GREENWICH ROAD IMPROVEMENTS (C.O.W. PROJECT NUMBER NO. 472-84274). SANITARY SEWER INSTALLATION SHALL BE PERFORMED WHEN GREENWICH ROAD IS CLOSED FOR ROAD CONSTRUCTION.
THE SANITARY SEWER PROJECT SHALL BE COMPLETED BY FEBRUARY 24, 2006.

DECEMBER 2005

PLANS PREPARED BY
PROFESSIONAL ENGINEERING CONSULTANTS, P.A.
ENGINEERS
WICHITA, KANSAS

