
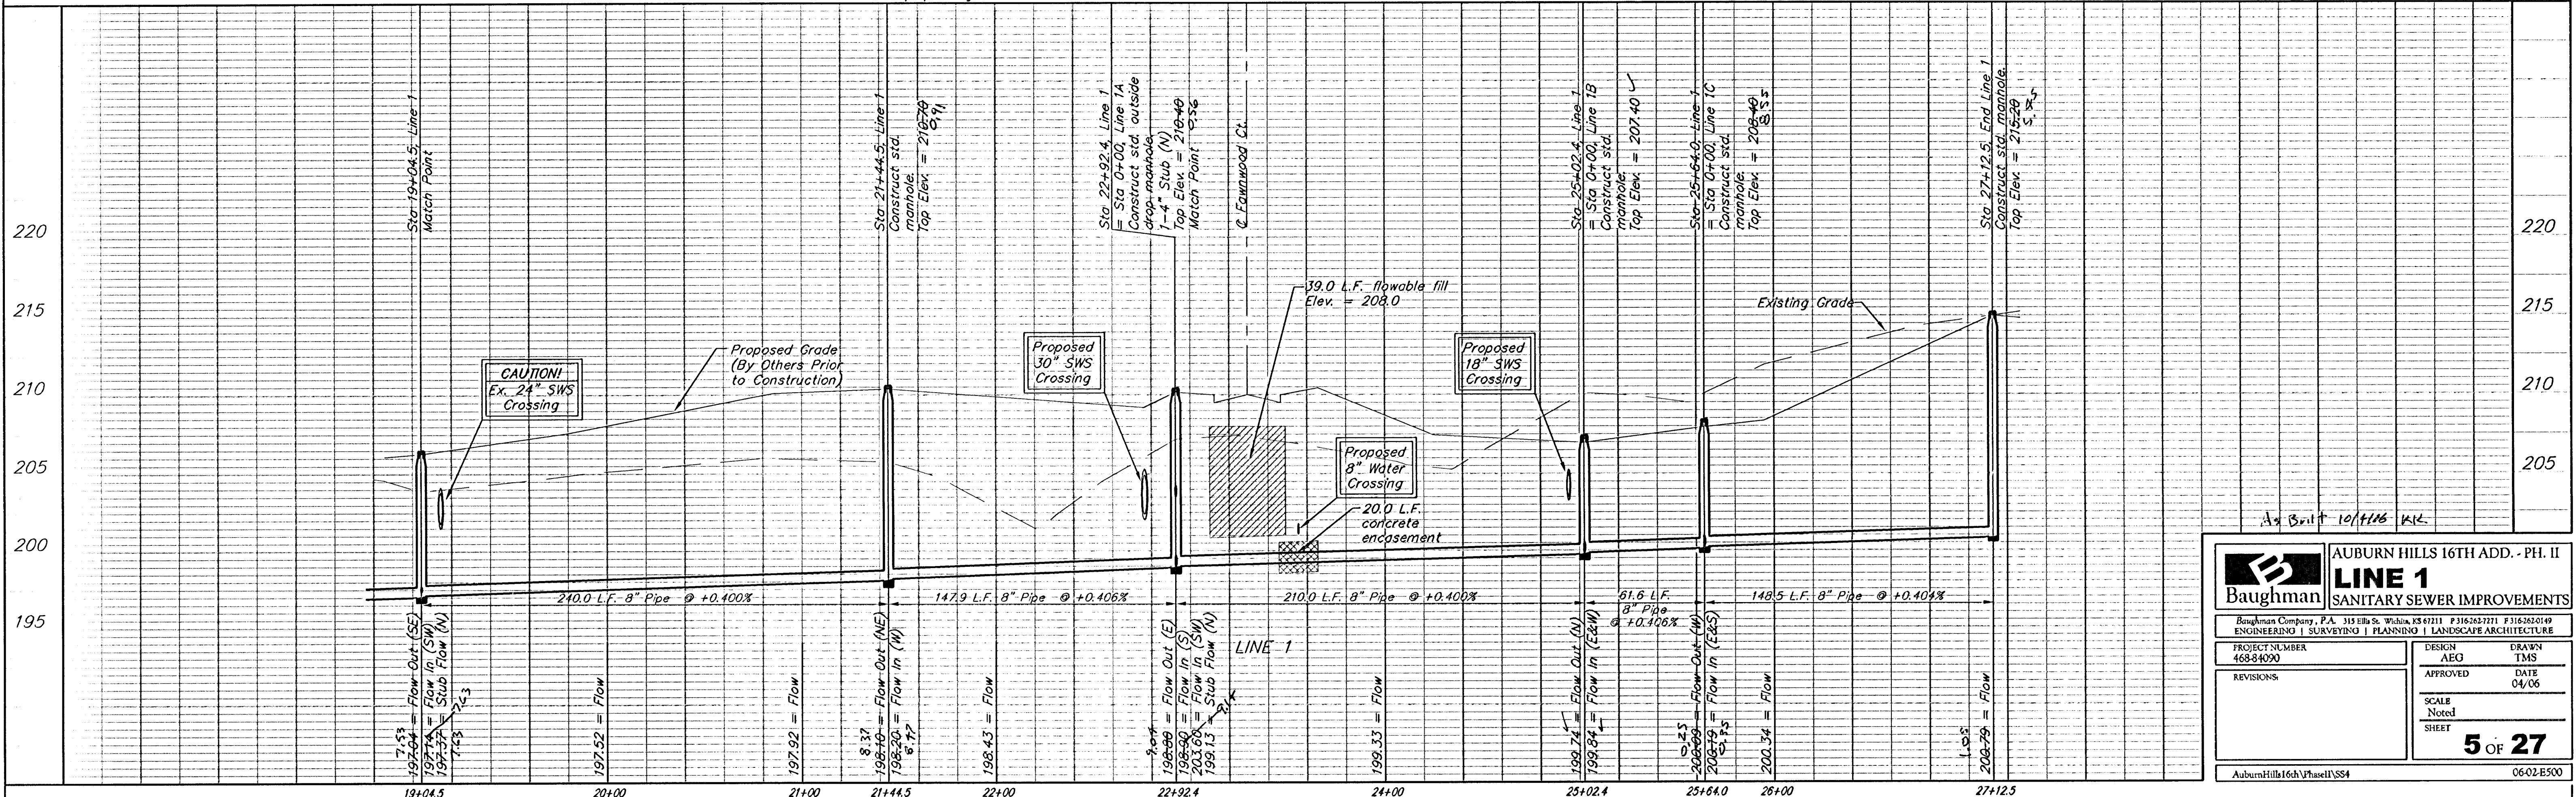


BENCHMARKS:

BM #1: "C" Cut on Top of Curb at West Line of Lot 7, Block A, Auburn Hills 5th Addition. Elev. = 207.73 (City Datum)

BM #2: Disc in Back of Curb, North of Front Corner Common to Lots 23 and 24, Block D, Auburn Hills 12th Addition. Elev. = 191.84 (City Datum)

BM #3: "C" Cut in Middle of Curb Inlet Top Adjacent to the South Corner of Lot 15, Block B. Elev. = 193.65 (City Datum)

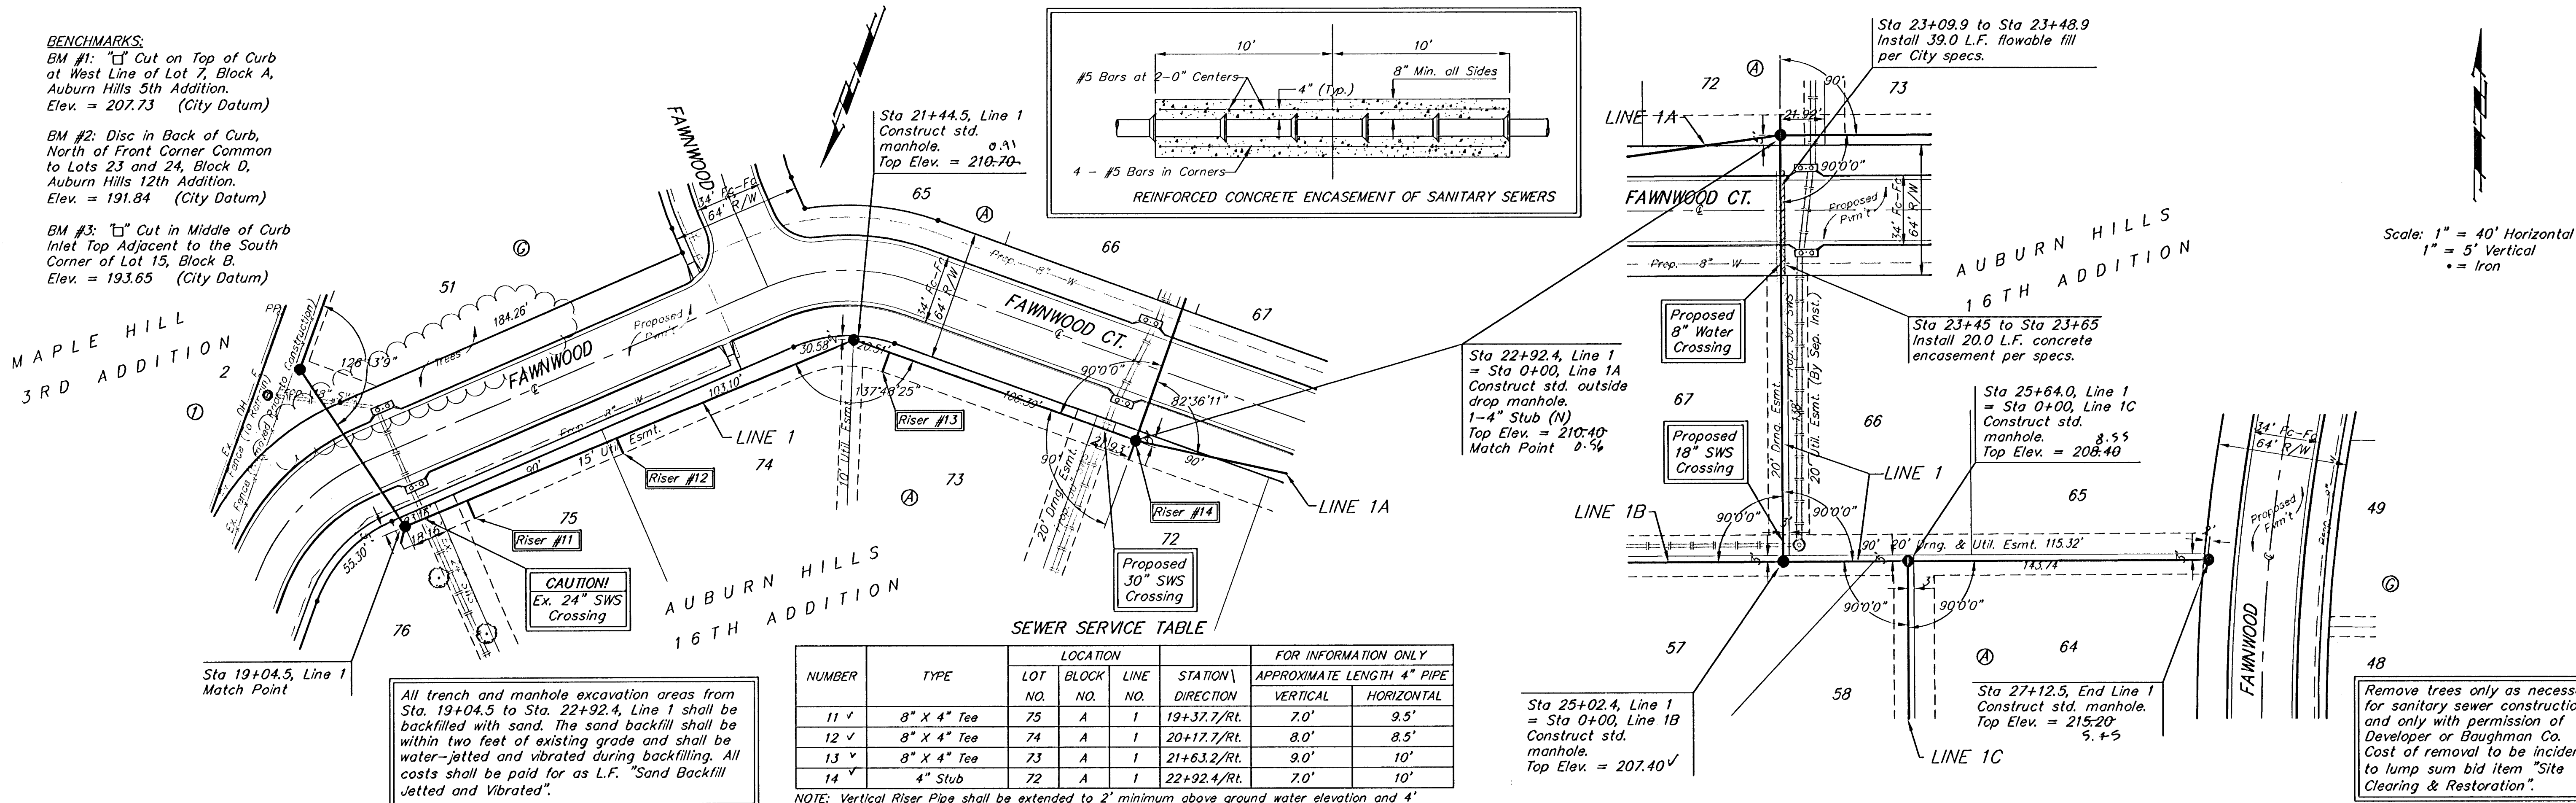

Baughman

AUBURN HILLS 16TH ADD. - PH. II

LINE 1

SANITARY SEWER IMPROVEMENTS

PROJECT NUMBER 468-84030		DESIGN AEG	
REVISIONS		DRAWN TMS	
APPROVED		DATE 04/06	
SCALE NOTED		SHEET 5 OF 27	

AuburnHills16thPhaseII.SS4 06-02-E500