
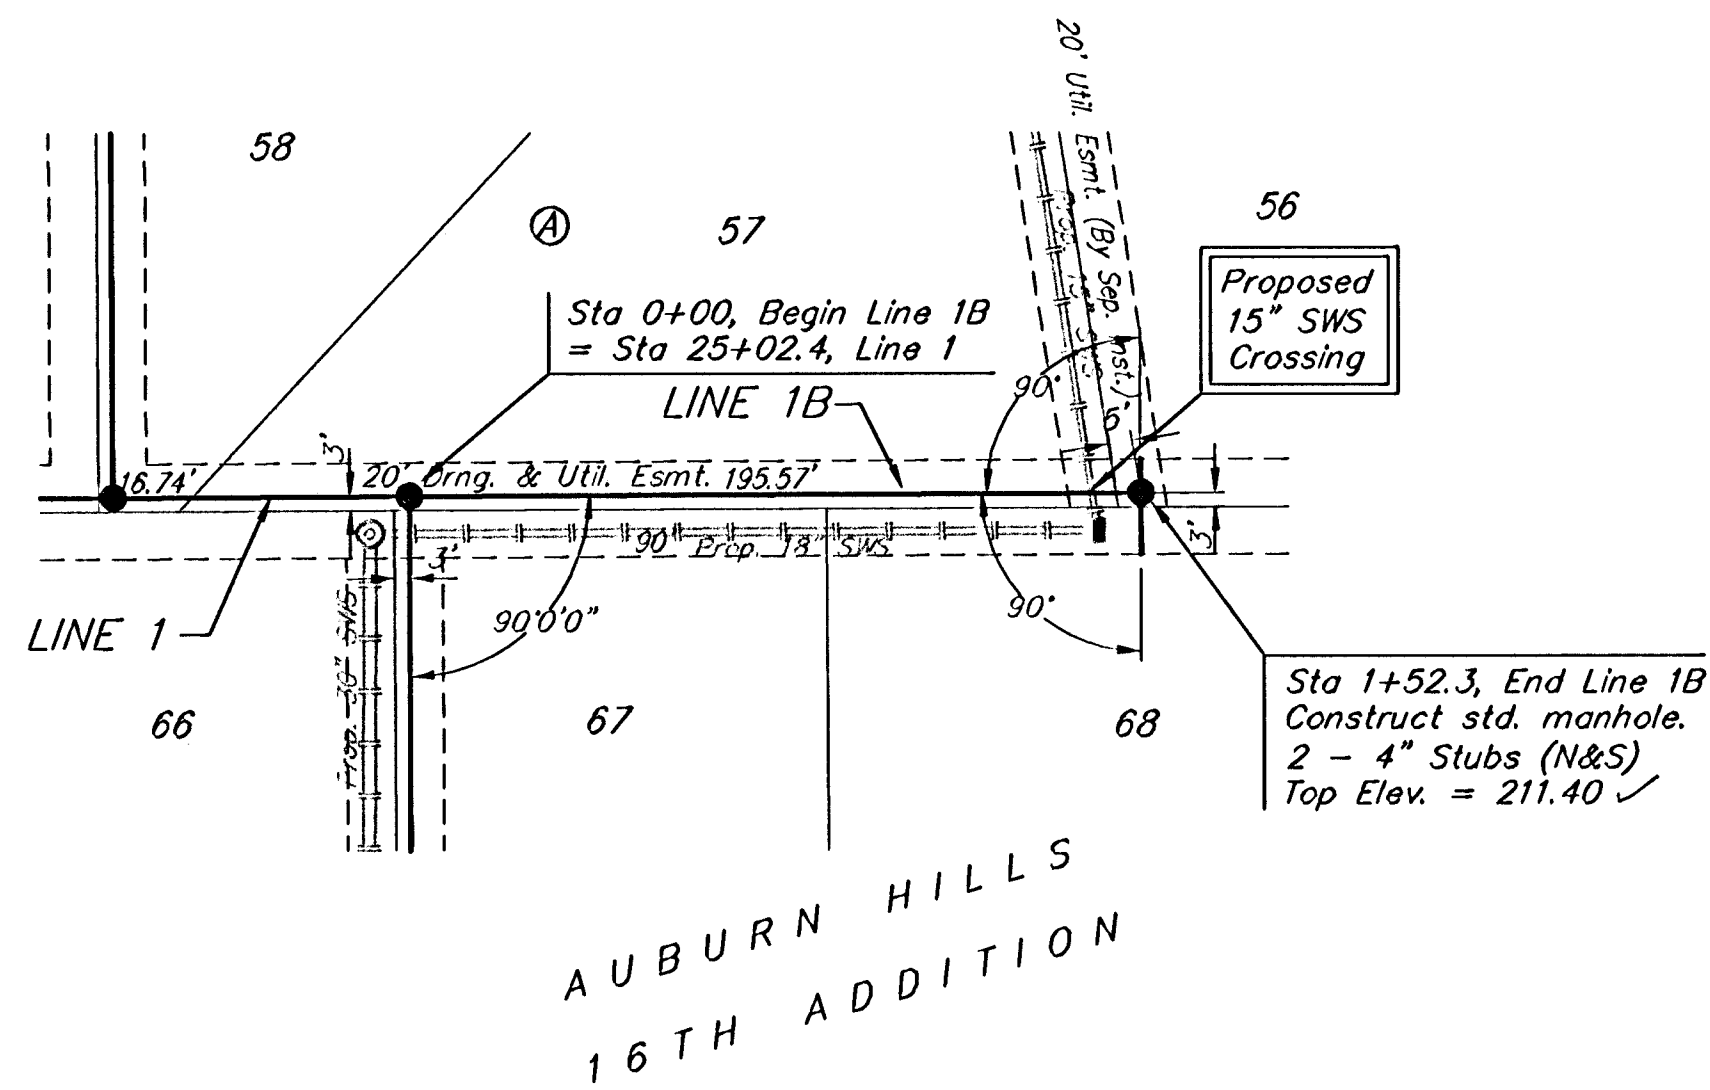


BENCHMARKS:
BM #1: "I" Cut on Top of Curb
at West Line of Lot 7, Block A,
Auburn Hills 5th Addition.
Elev. = 207.73 (City Datum)

BM #2: Disc in Back of Curb,
North of Front Corner Common
to Lots 23 and 24, Block D,
Auburn Hills 12th Addition.
Elev. = 191.84 (City Datum)

BM #3: "I" Cut in Middle of Curb
Inlet Top Adjacent to the South
Corner of Lot 15, Block B.
Elev. = 193.65 (City Datum)

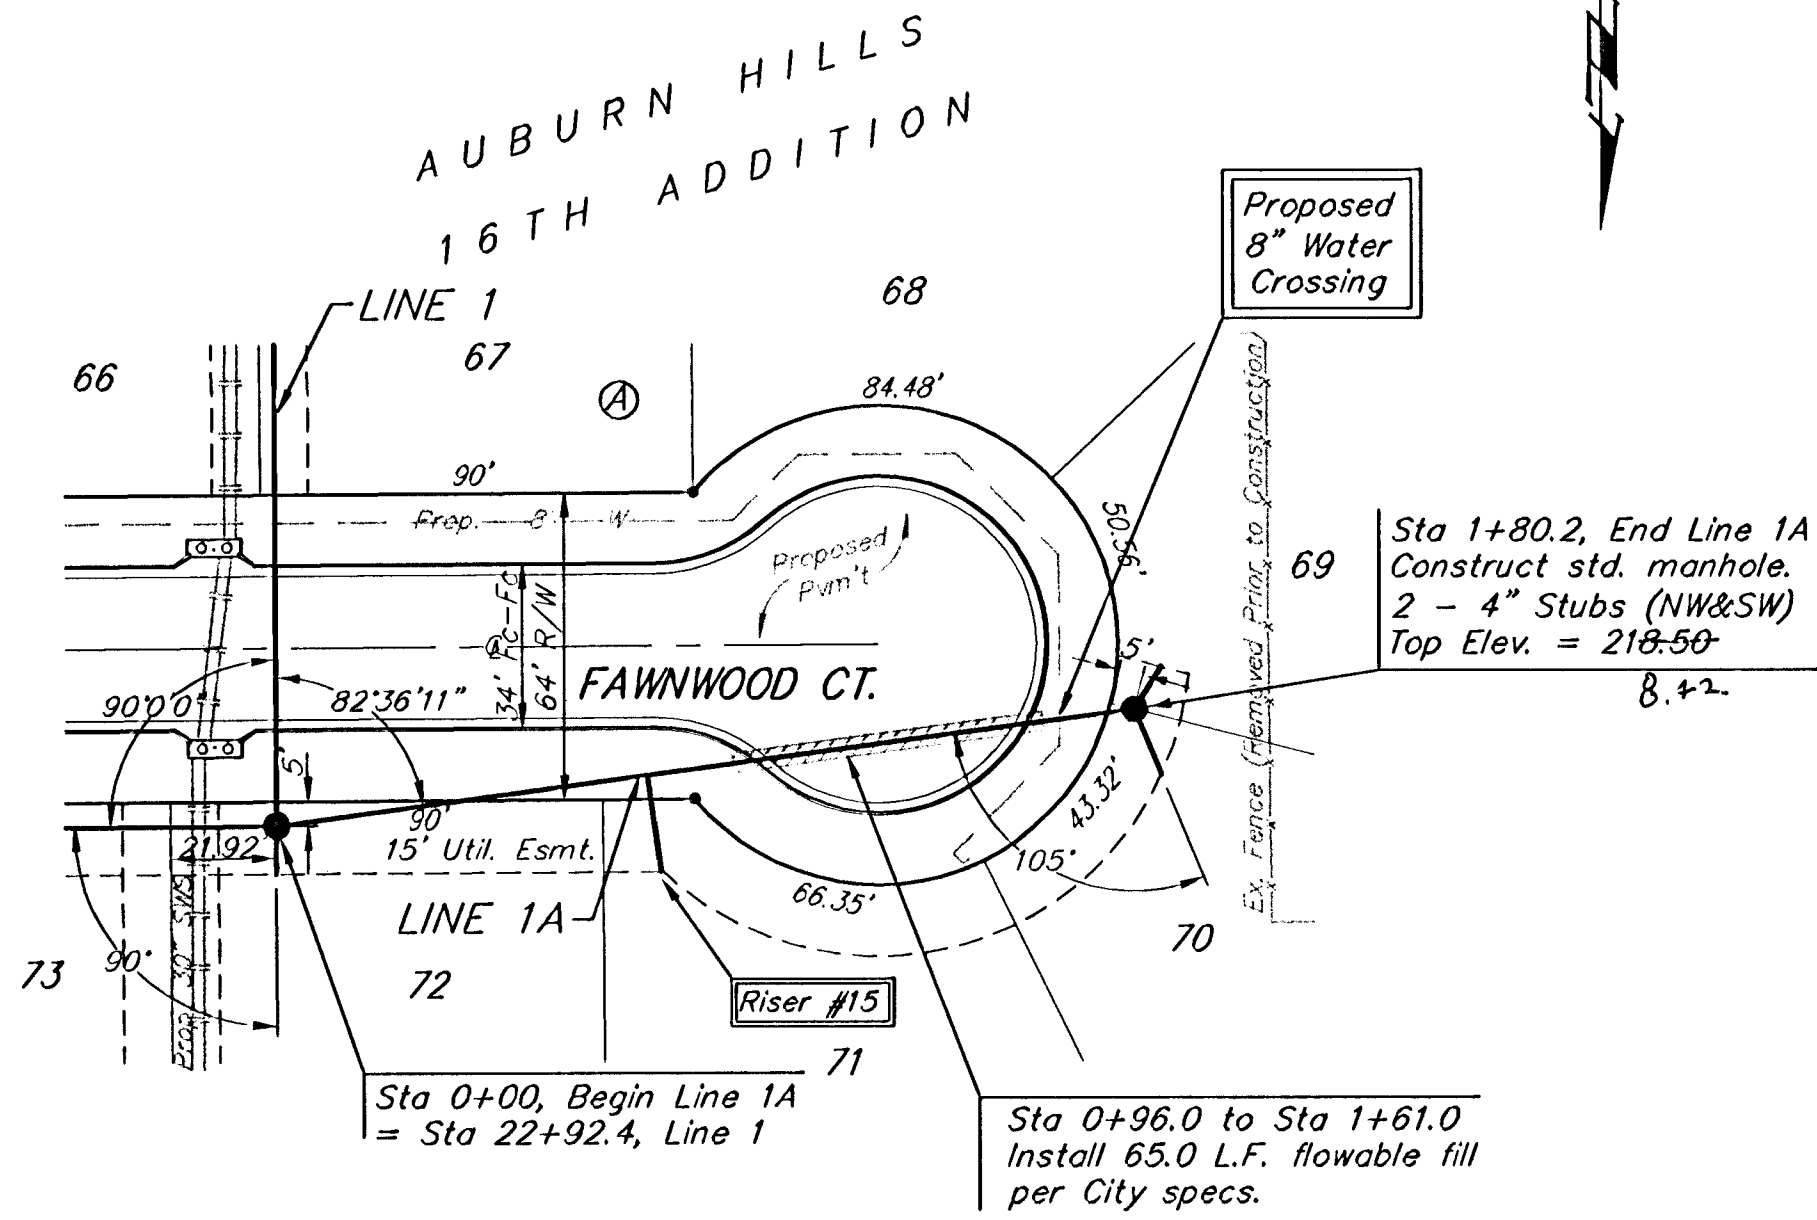


Scale: 1" = 40' Horizontal
1" = 5' Vertical
• = Iron

All trench and manhole excavation areas from Sta. 0+00 to Sta. 1+80.2, Line 1A shall be backfilled with sand, except the portion under the pavement. The sand backfill shall be within two feet of existing grade and shall be water-jetted and vibrated during backfilling. All costs shall be paid for as L.F. "Sand Backfill Jetted and Vibrated".

NUMBER	TYPE	LOCATION				FOR INFORMATION ONLY	
		LOT NO.	BLOCK NO.	LINE NO.	STATION\ DIRECTION	APPROXIMATE LENGTH 4" PIPE	VERTICAL
15 ✓	8" X 4" Tee	71	A	1A	0+78/Rt.	10.0'	20'

NOTE: Vertical Riser Pipe shall be extended to 2' minimum above ground water elevation and 4' maximum below proposed ground elevation.

Remove trees only as necessary for sanitary sewer construction and only with permission of Developer or Baughman Co. Cost of removal to be incidental to lump sum bid item "Site Clearing & Restoration".

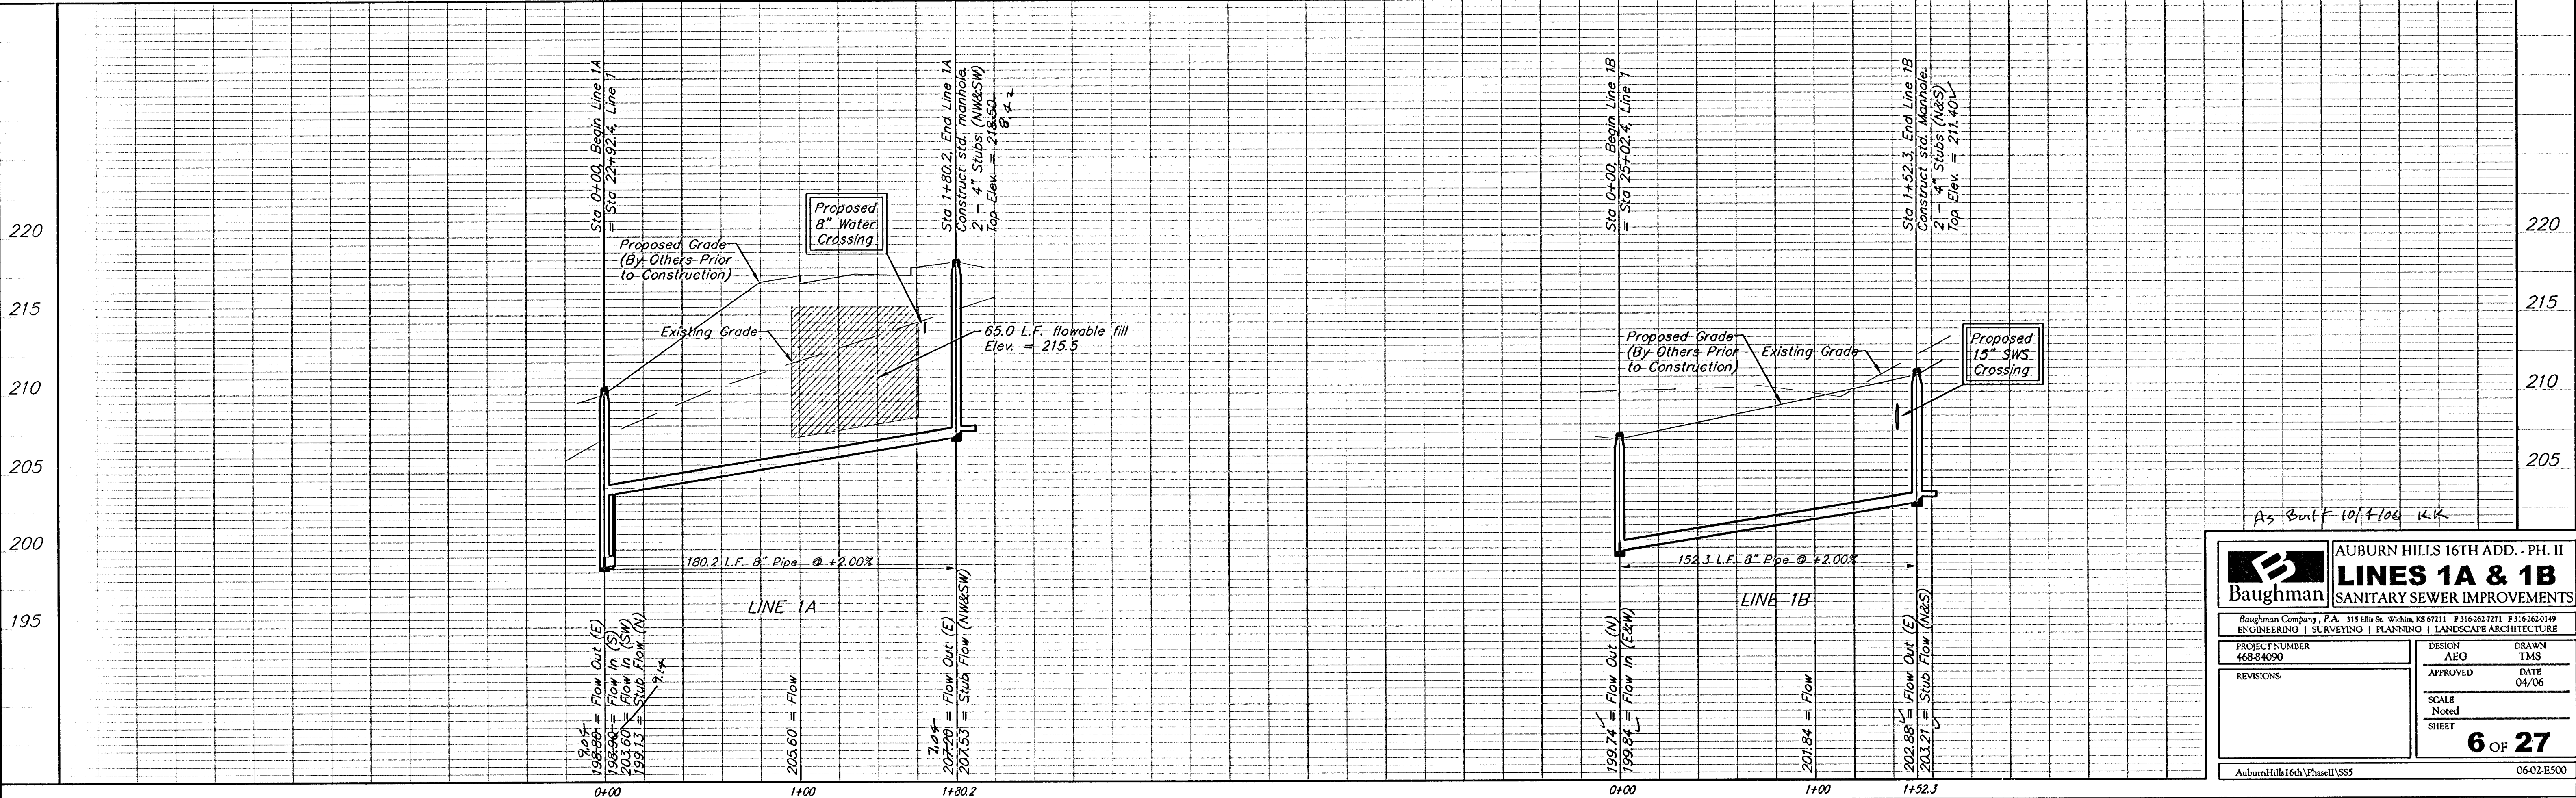

As Built 10/4/06 L.R.

AUBURN HILLS 16TH ADD. - PH. II
LINES 1A & 1B
SANITARY SEWER IMPROVEMENTS

PROJECT NUMBER
468-84090

DESIGN
AEG

APPROVED
DATE
04/06

REVISIONS

SCALE
Noted
SHEET
6 OF 27

AuburnHills16th\PhaseII\SSS

0602E500