


BENCHMARKS:

BM #1: "I" Cut on Top of Curb
at West Line of Lot 7, Block A,
Auburn Hills 5th Addition.
Elev. = 207.73 (City Datum)

BM #2: Disc in Back of Curb,
North of Front Corner Common
to Lots 23 and 24, Block D,
Auburn Hills 12th Addition.
Elev. = 191.84 (City Datum)


BM #3: "I" Cut in Middle of Curb
Inlet Top Adjacent to the South
Corner of Lot 15, Block B.
Elev. = 193.65 (City Datum)

Scale: 1" = 40' Horizontal
1" = 5' Vertical
• = Iron

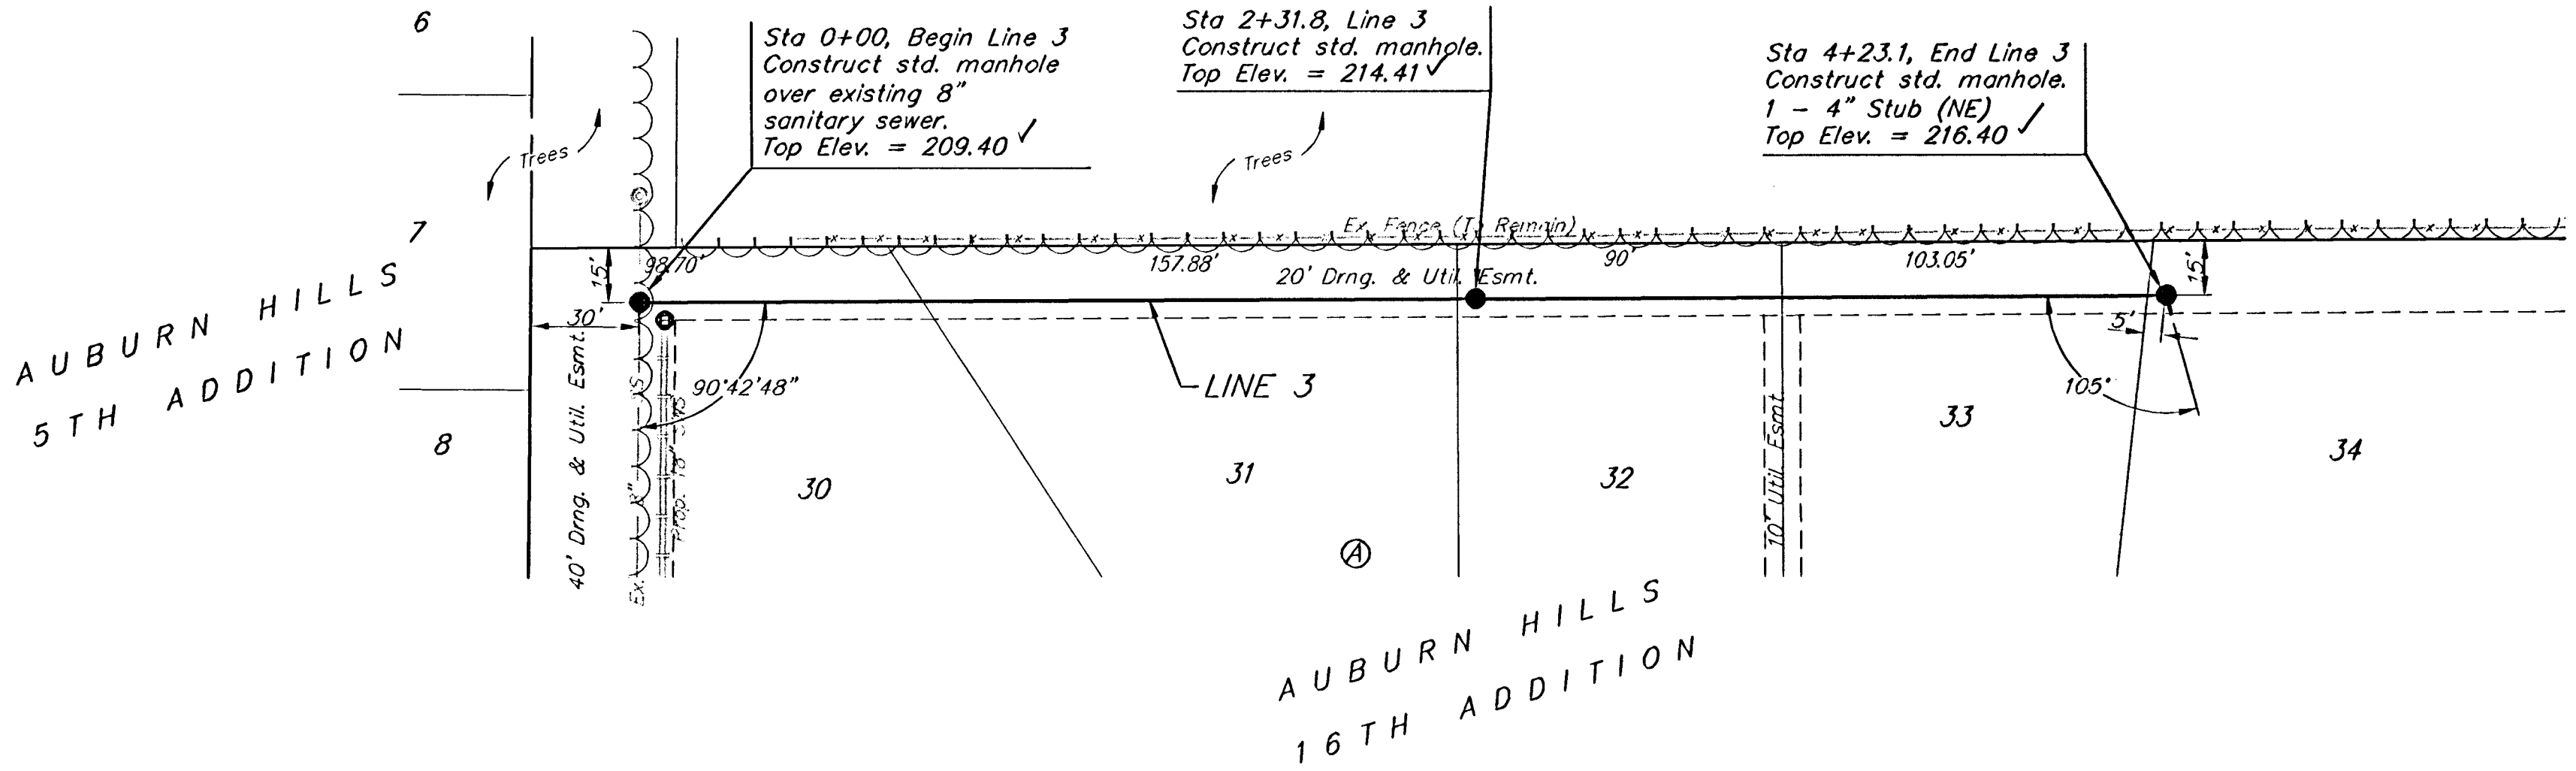

Contractor to Verify Depth &
Location of Existing 8" Sewer
Line Prior to Construction.

Remove trees only as necessary
for sanitary sewer construction
and only with permission of
Developer or Baughman Co.
Cost of removal to be incidental
to lump sum bid item "Site
Clearing & Restoration".

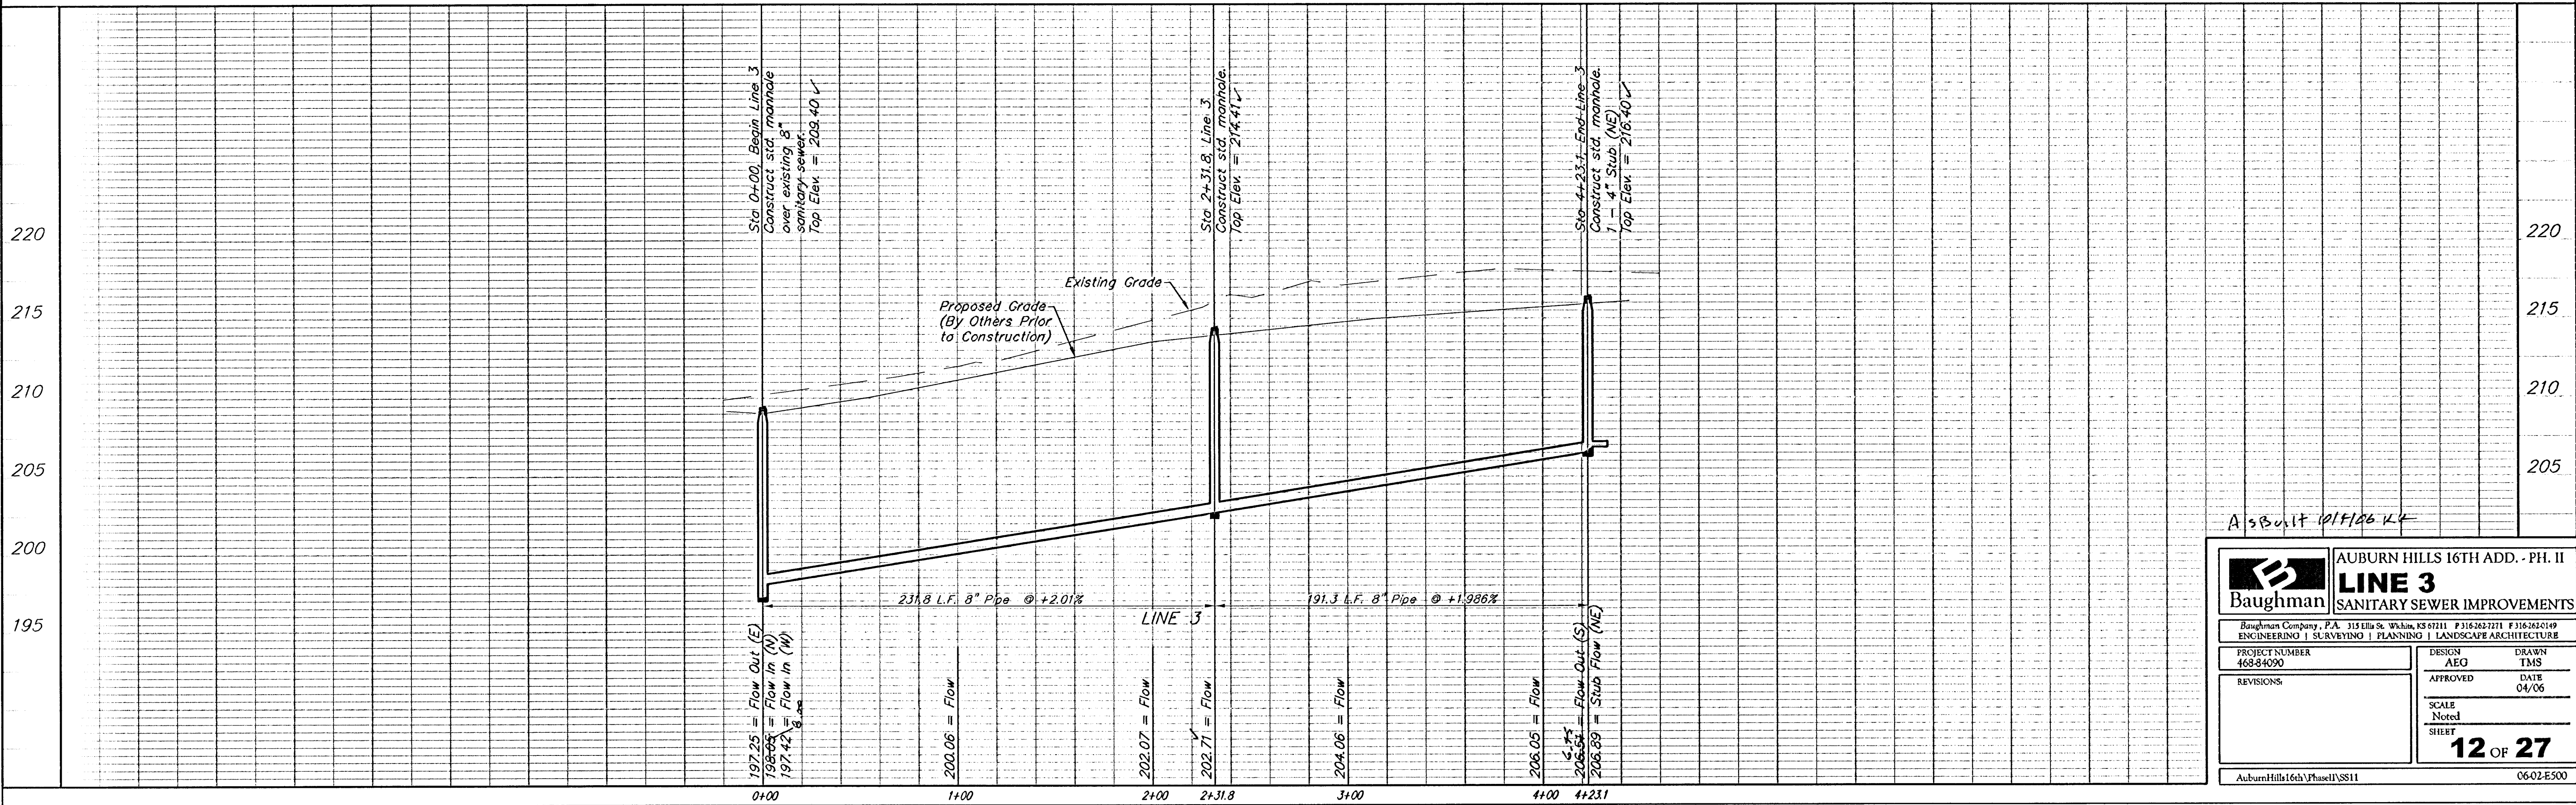

A3B011 10/11/06 KL

Baughman		AUBURN HILLS 16TH ADD. - PH. II	
LINE 3		SANITARY SEWER IMPROVEMENTS	
Baughman Company, P.A. 315 Elm St. Woburn, MA 01801 P 316.262.7211 F 316.262.0149 ENGINEERING SURVEYING PLANNING LANDSCAPE ARCHITECTURE			
PROJECT NUMBER 458-04020	DESIGN AEG	DRAWN TMS	DATE 04/06
REVISIONS	APPROVED	SCALE Noted	SHEET 12 OF 27
AuburnHills16thVPhaseI\SS11		0602-E500	