

SANITARY SEWER PLANS

HAWTHORNE THIRD ADDITION

PROJECT NO. 468-83874

O.C.A # 744187

SCALE: 1" = 200'

<u>SHEET NO.</u>	<u>DESCRIPTION</u>
------------------	--------------------

Dondlinger + Sons Const. Co. - Contractor
Jaso, City - Inspector
Released 12/19/06
As-Built
Risers & Stubs
.pdf by JDL 9/24/07


BM #1 RR SPIKE IN FACE OF 1ST PP SOUTH OF 21ST ST.,
218'± WEST AND 48'± SOUTH OF THE N 1/4 COR.
SECTION 11-27S-2E
ELEV.=1357.15

BM #2 "□" ON NE COR. OF STORM INLET ON SOUTH SIDE
OF WILLIAMSGATE
ELEV.=1355.74

BM #3 C.O.W. DISC TC SWS INLET ON EAST SIDE OF
WILLIAMSGATE.
ELEV.=1357.98

SE. Cor., SW. $\frac{1}{4}$, Sec. 2,
T27S, R2E, 6th P.M.
Fnd. $\frac{3}{4}$ " Pipe

-
- This is a detailed plat map of the Hawthorne Second Addition. The map shows several streets including Mainsgate Cir, Main Gate, Rosemont Court, Camden Chase, Lindsey Cir, Rosemont Cir, Williams Gate, Loch Lomond Ct., Ayesbury Ln, Boxthorn Ct, and Willow Gate. The map is divided into numerous numbered lots. Key features include:
- Hawthorne Second Addition:** Located in the upper left and center, containing lots 1 through 31.
 - Hawthorne Third Addition:** Located in the upper right, containing lots 32 through 64.
 - Hawthorne First Addition:** Located in the lower right, containing lots 65 through 96.
 - Easements:** Various easements are shown, including "RES. 10'", "RES. 12'", "RES. 14'", "RES. 16'", "RES. 94'", "RES. 96'".
 - Other Features:** The map also shows "Riser #1", "Riser #2", "Riser #3", "Riser #4", "Riser #95", "Riser #96".

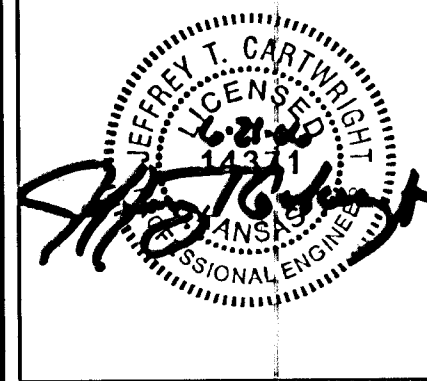

**SANITARY SEWER PLANS FOR
HAWTHORNE THIRD ADD.
PHASE 4**

TITLE SHEET

SHEET TITLE

468-83874

PROJECT NUMBER

DESIGN BY DFL
DRAWN BY DMU
CHECKED BY GJA

ISSUED
JUNE 2006

REVISÉ

SHEET NO.

1 of 10