




SANITARY SEWER PLANS FOR
HAWTHORNE THIRD ADD.
PHASE 4

LINES 4 & 6
SHEET TITLE
468-83874
PROJECT NUMBER

DESIGN BY DFL
DRAWN BY DMU
CHECKED BY GJA

ISSUED
JUNE 2006
REVISED

SHEET NO.
6 of 10

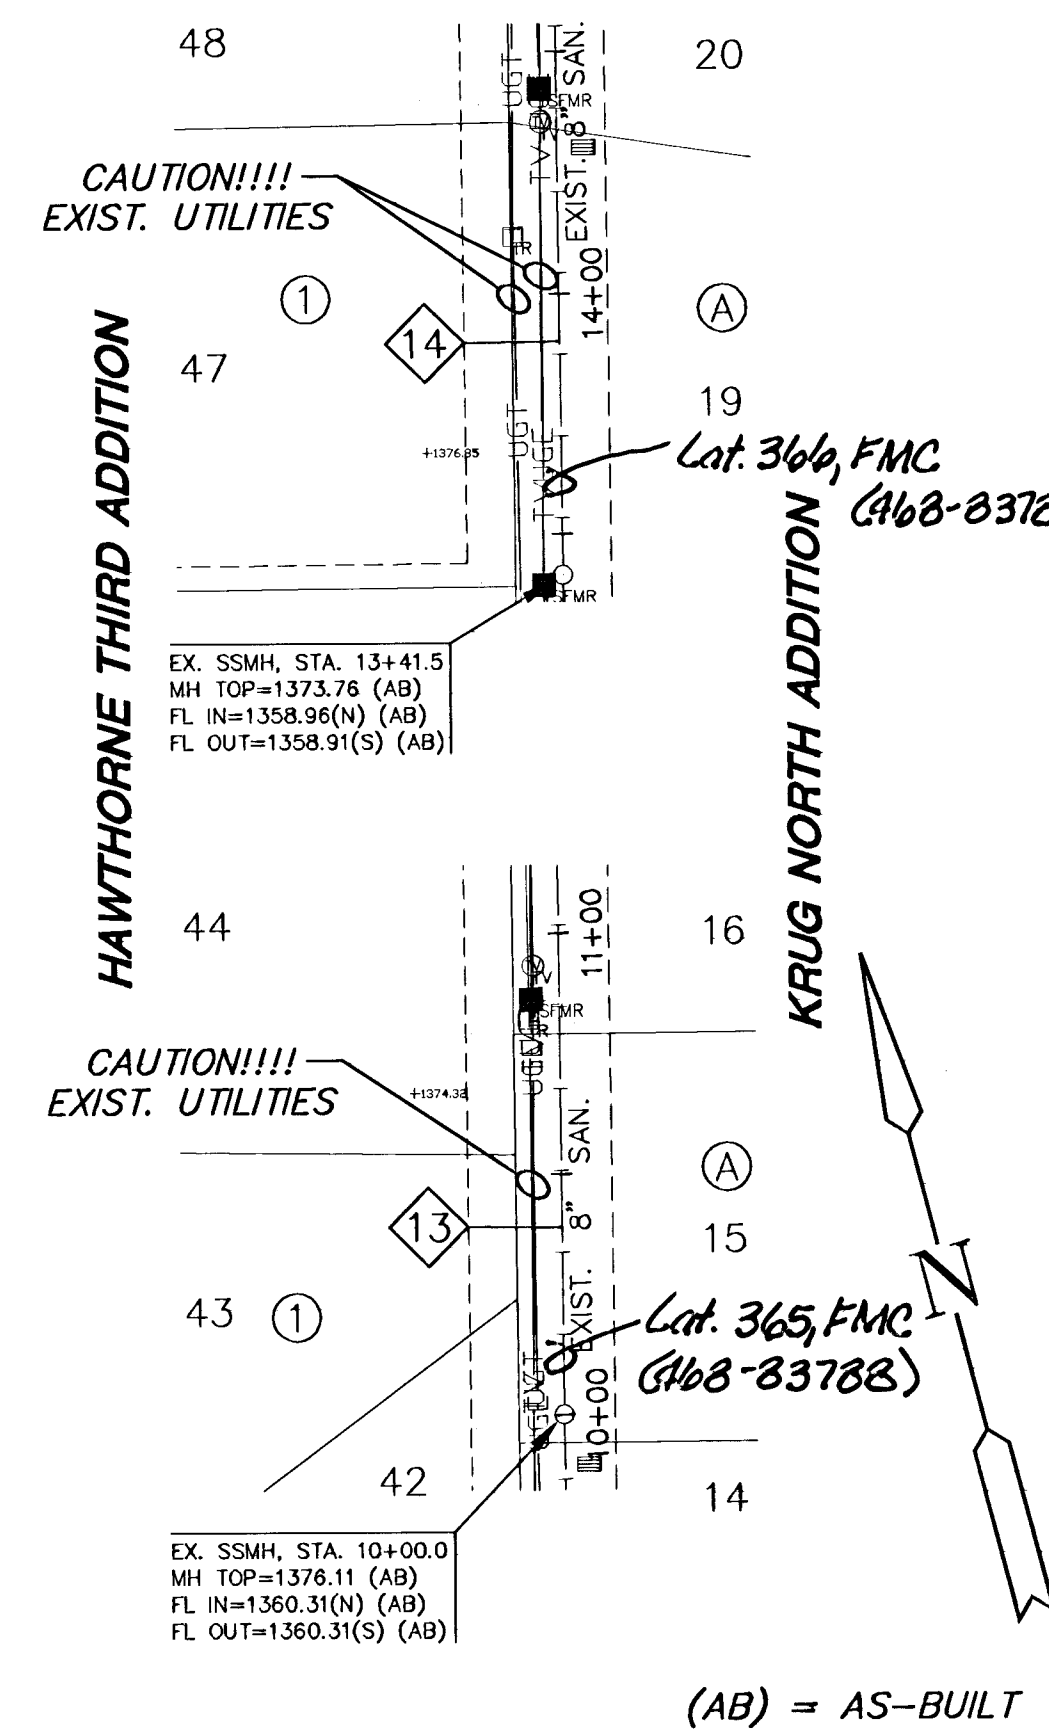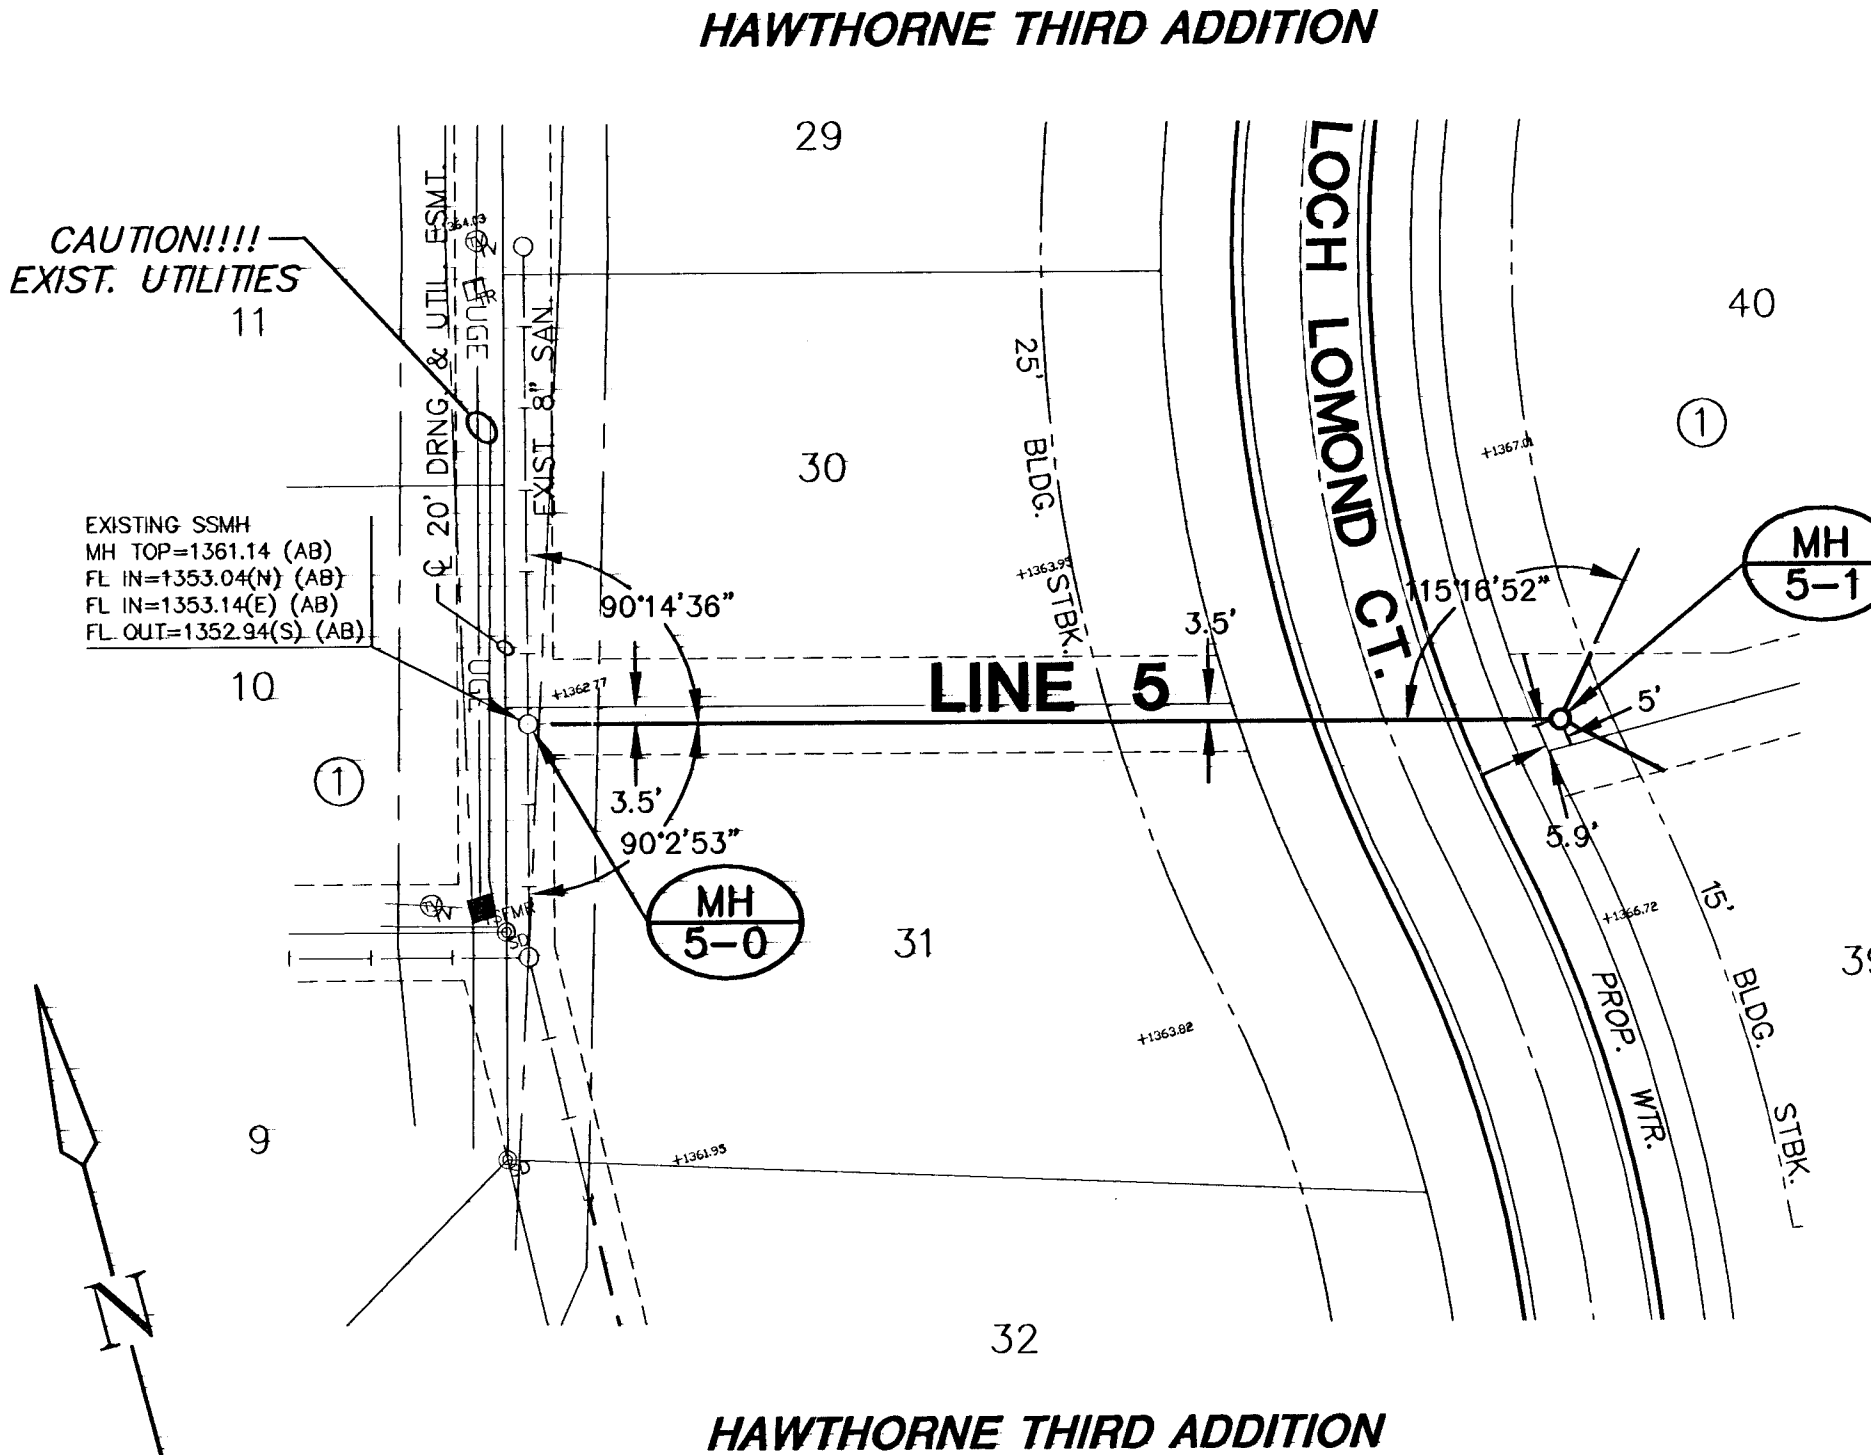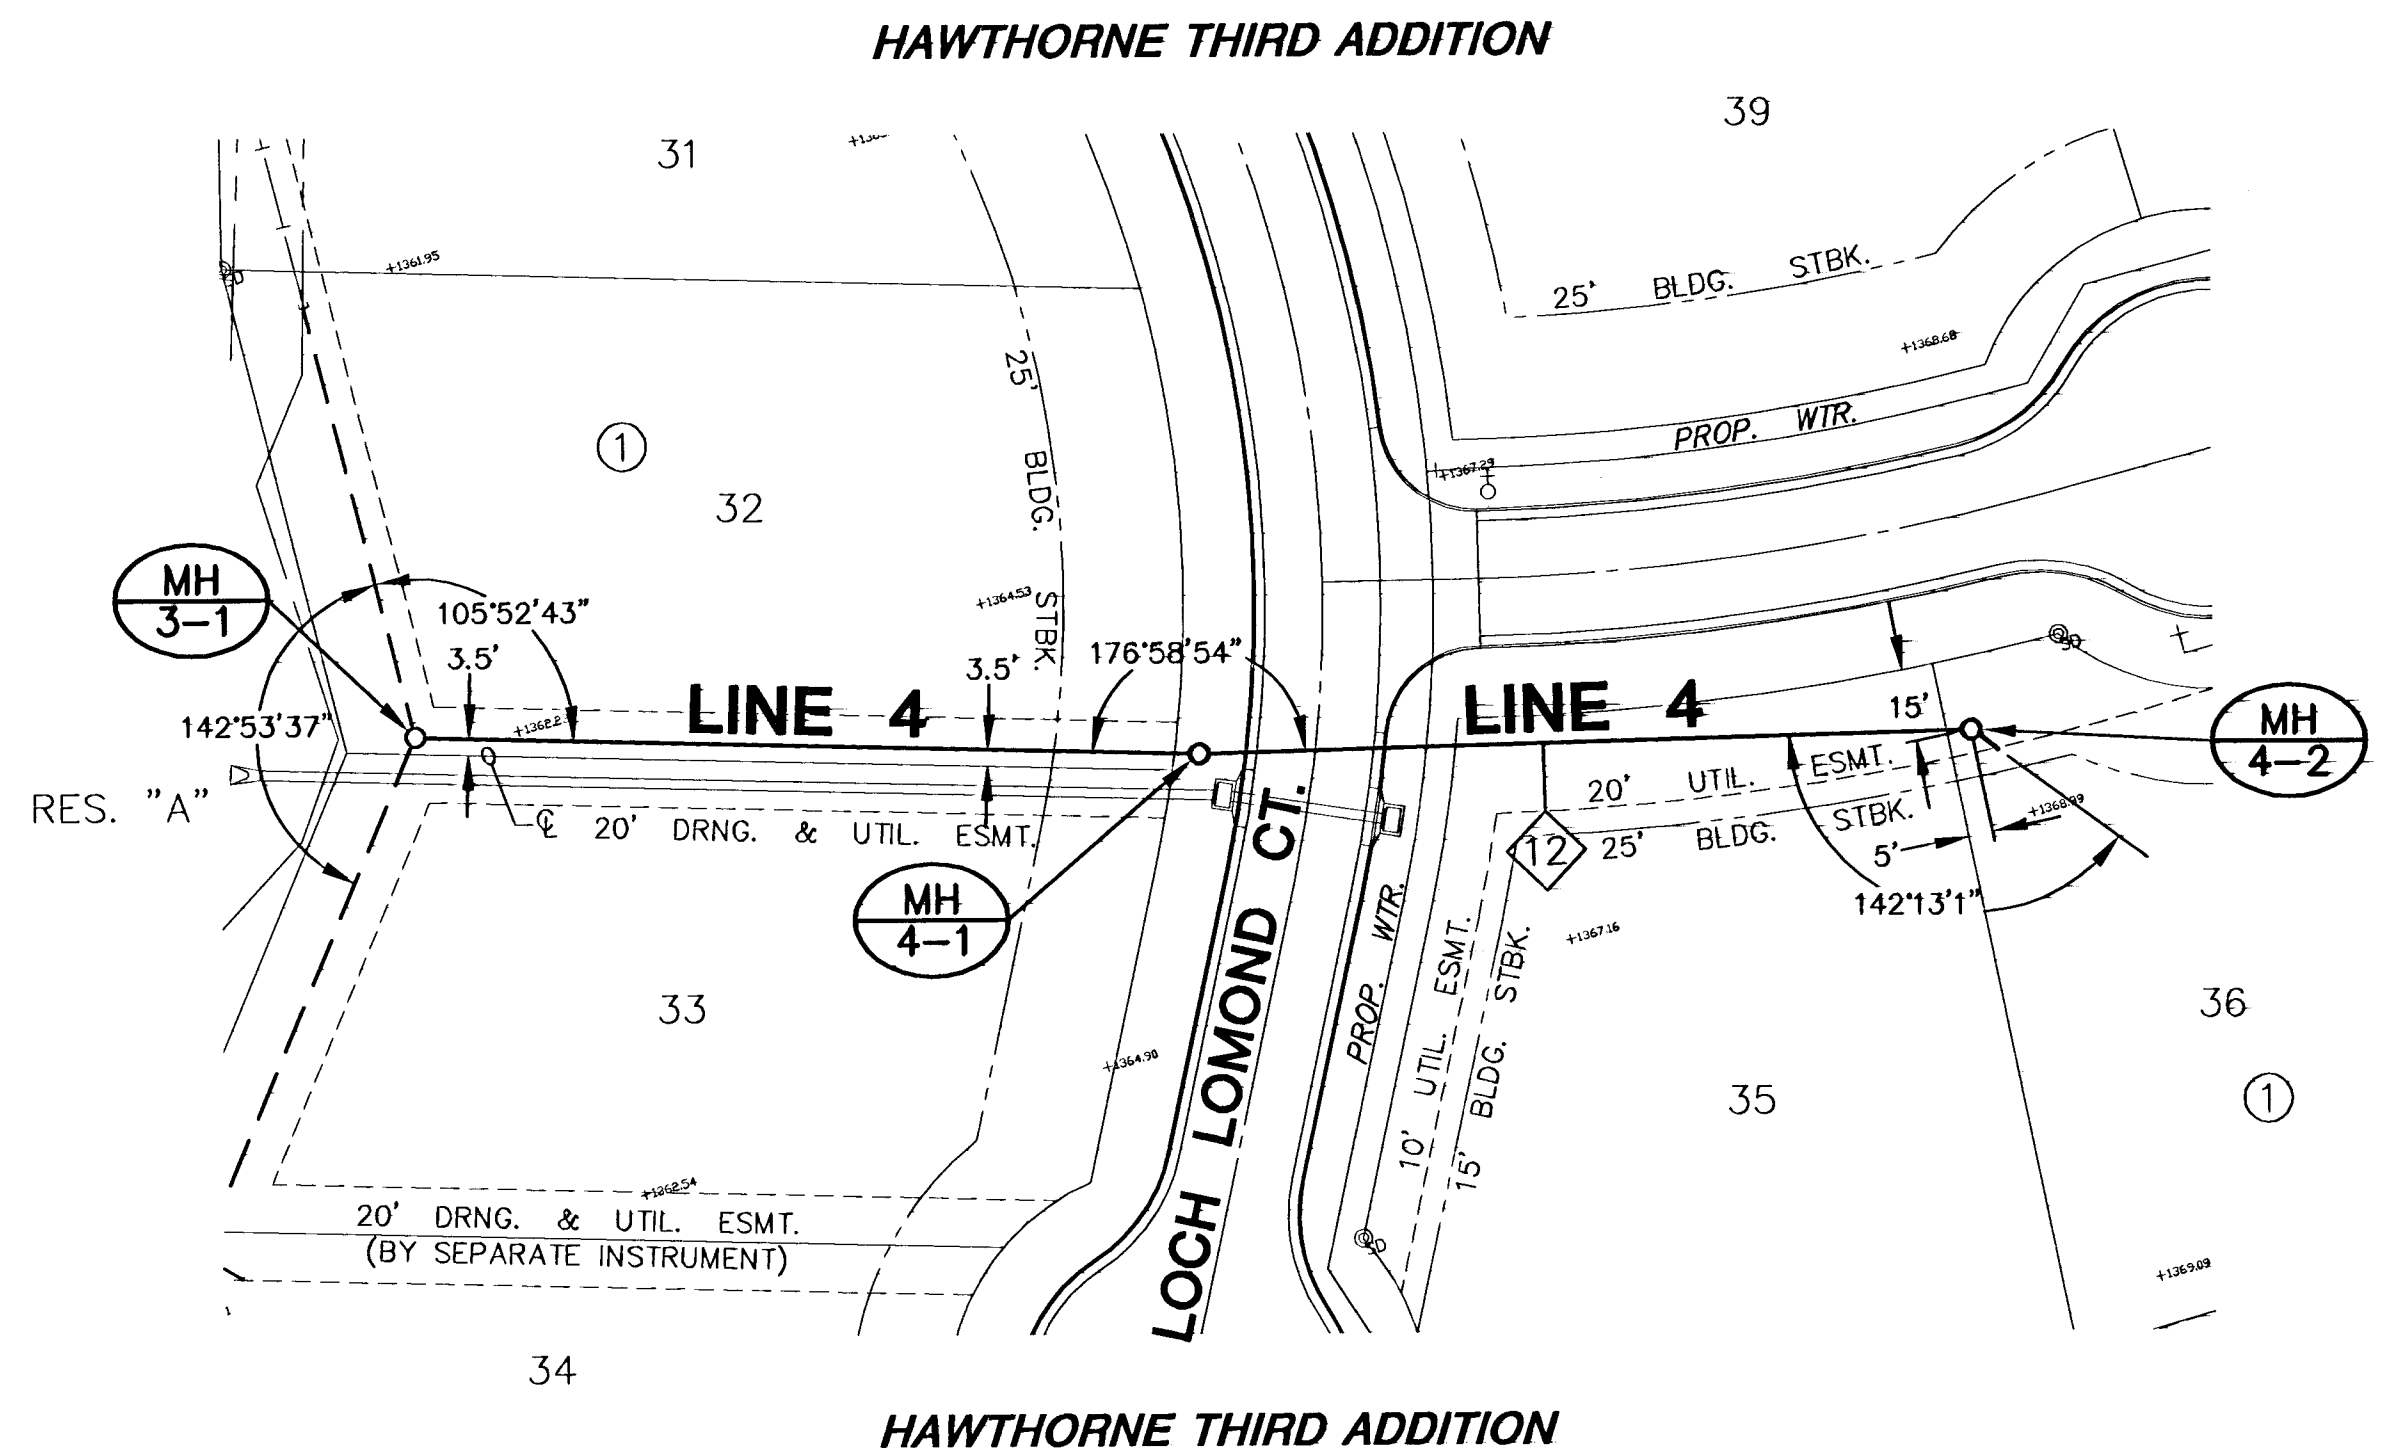

NOTES:
CONTRACTOR TO VERIFY THE DEPTH AND LOCATION OF EXISTING UTILITIES PRIOR TO CONSTRUCTION.
TRENCHES TO BE BACKFILLED WITH SAND AND FLUSHED WHEN SEWER LINE RUNS ALONG FRONT OF LOTS.

