



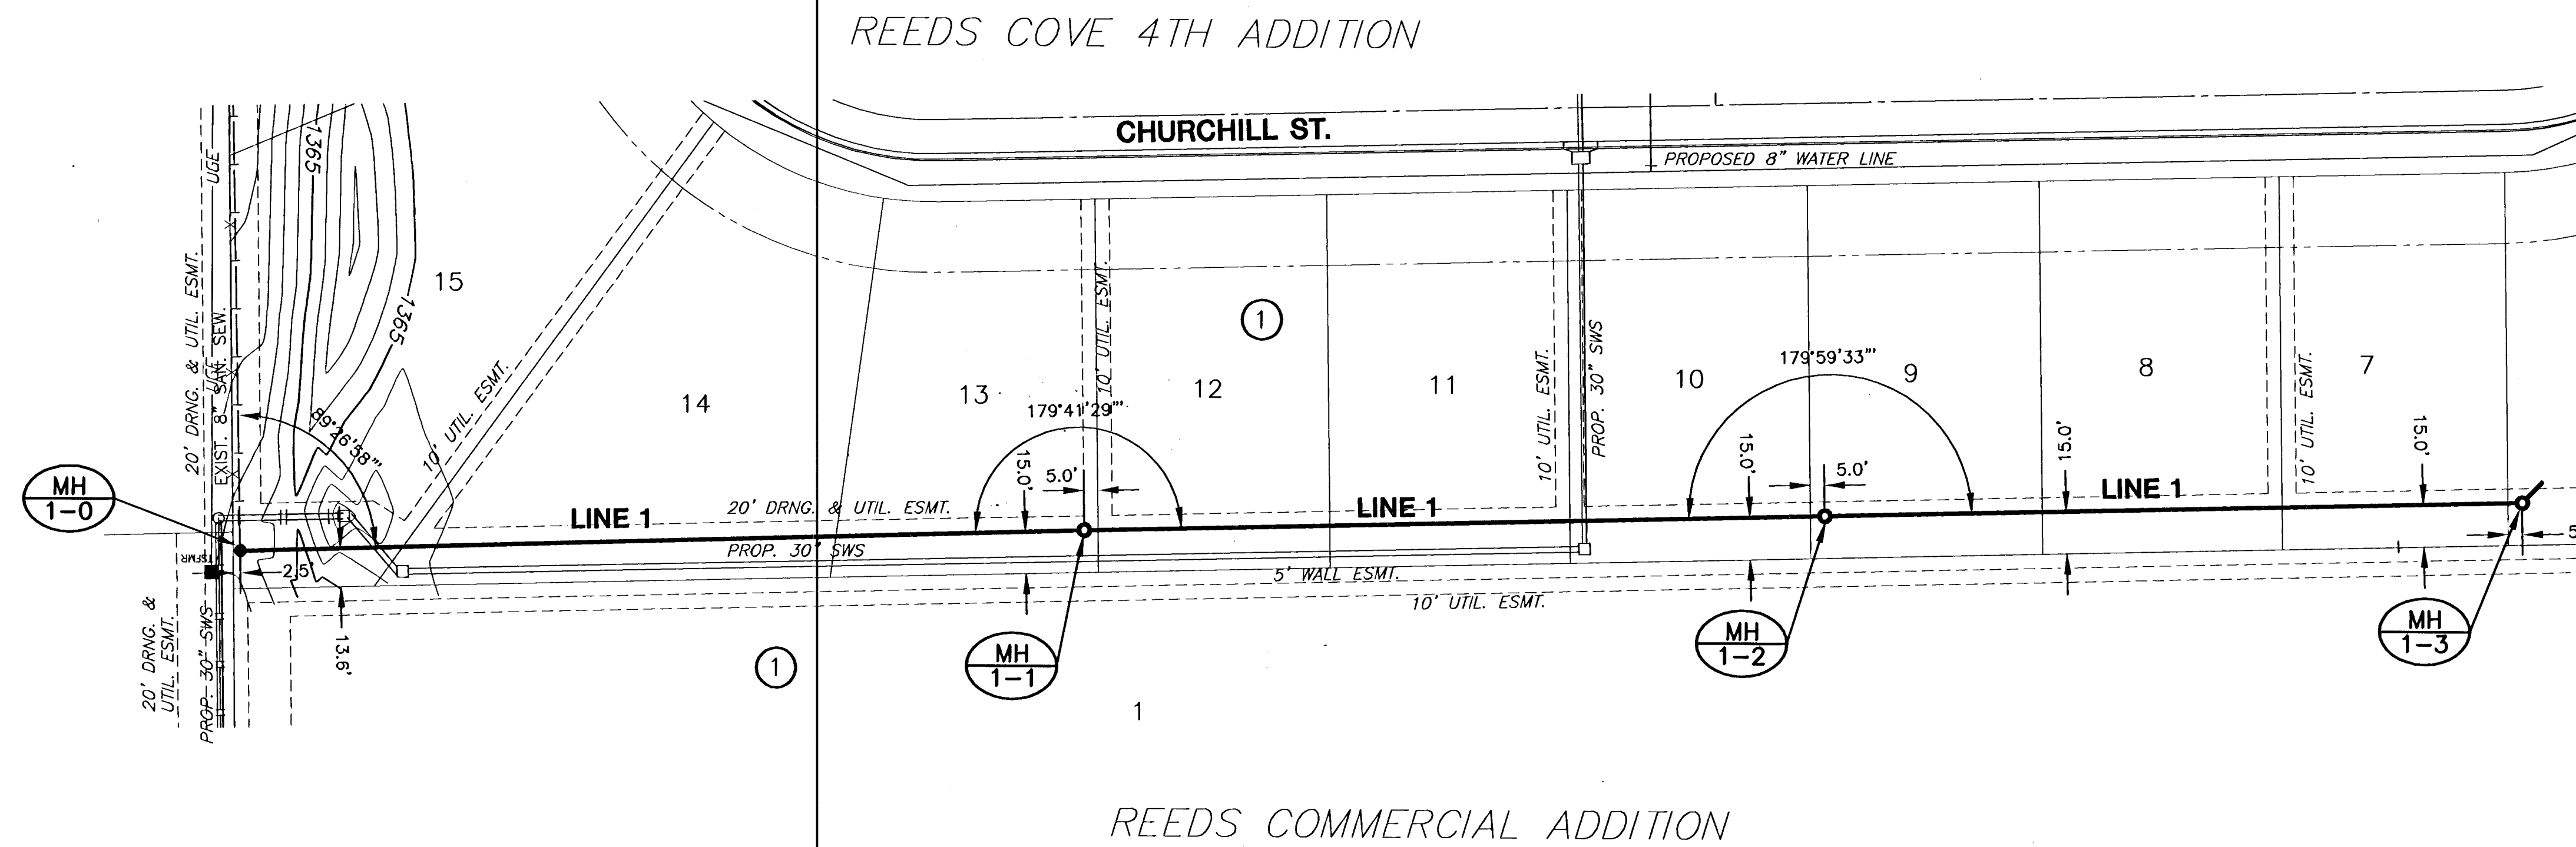

PLAN LINE 1

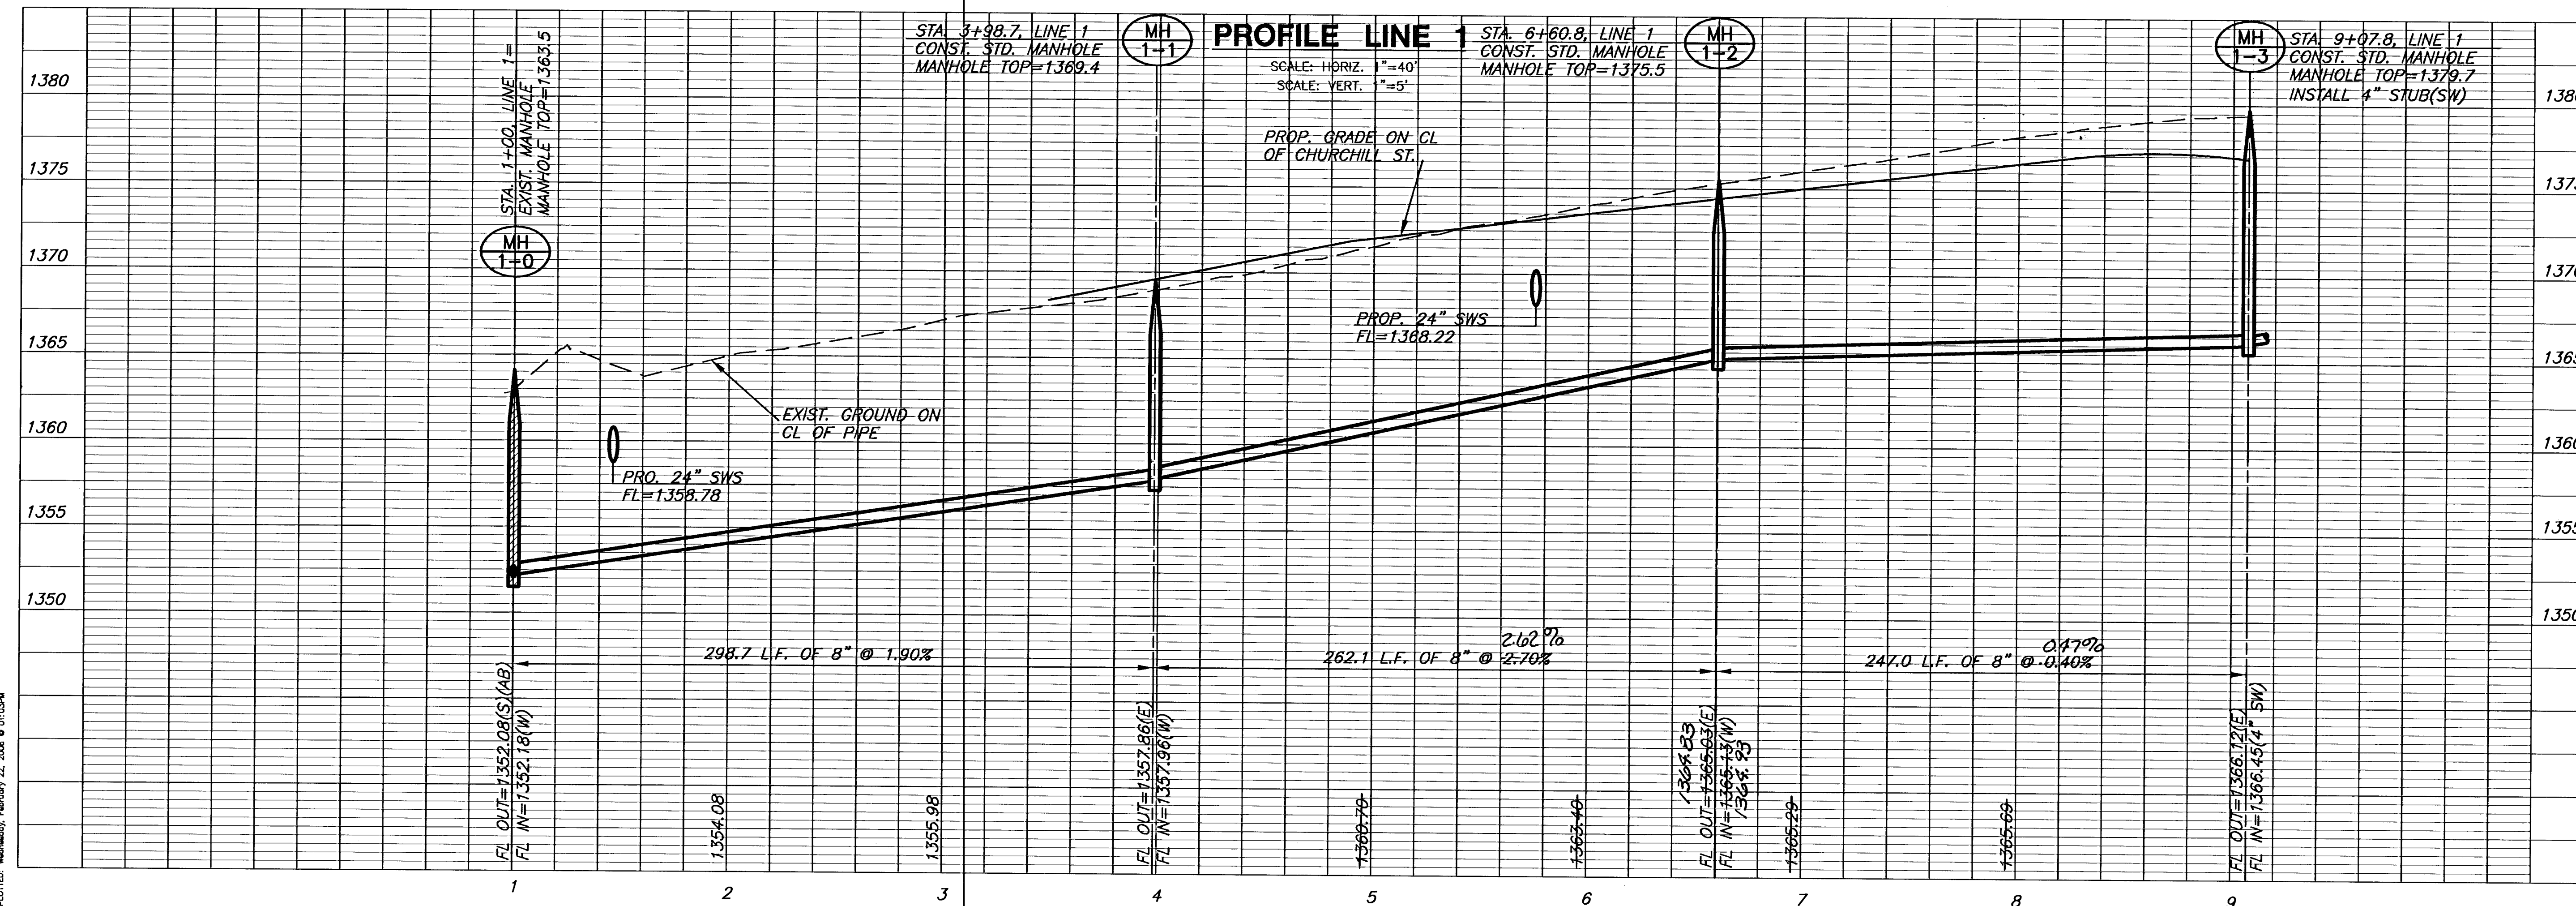

**SANITARY SEWER PLANS
REED'S COVE
FOURTH ADDITION**

LINE 1
SHEET TITLE
448-00000
PROJECT NUMBER

DESIGN BY *SRS*

DRAWN BY *DM/BFL*

CHECKED BY *GJA*

ISSUED
FEBRUARY 2006
DUE FEB 2006

SHEET NO.

3 of 11