
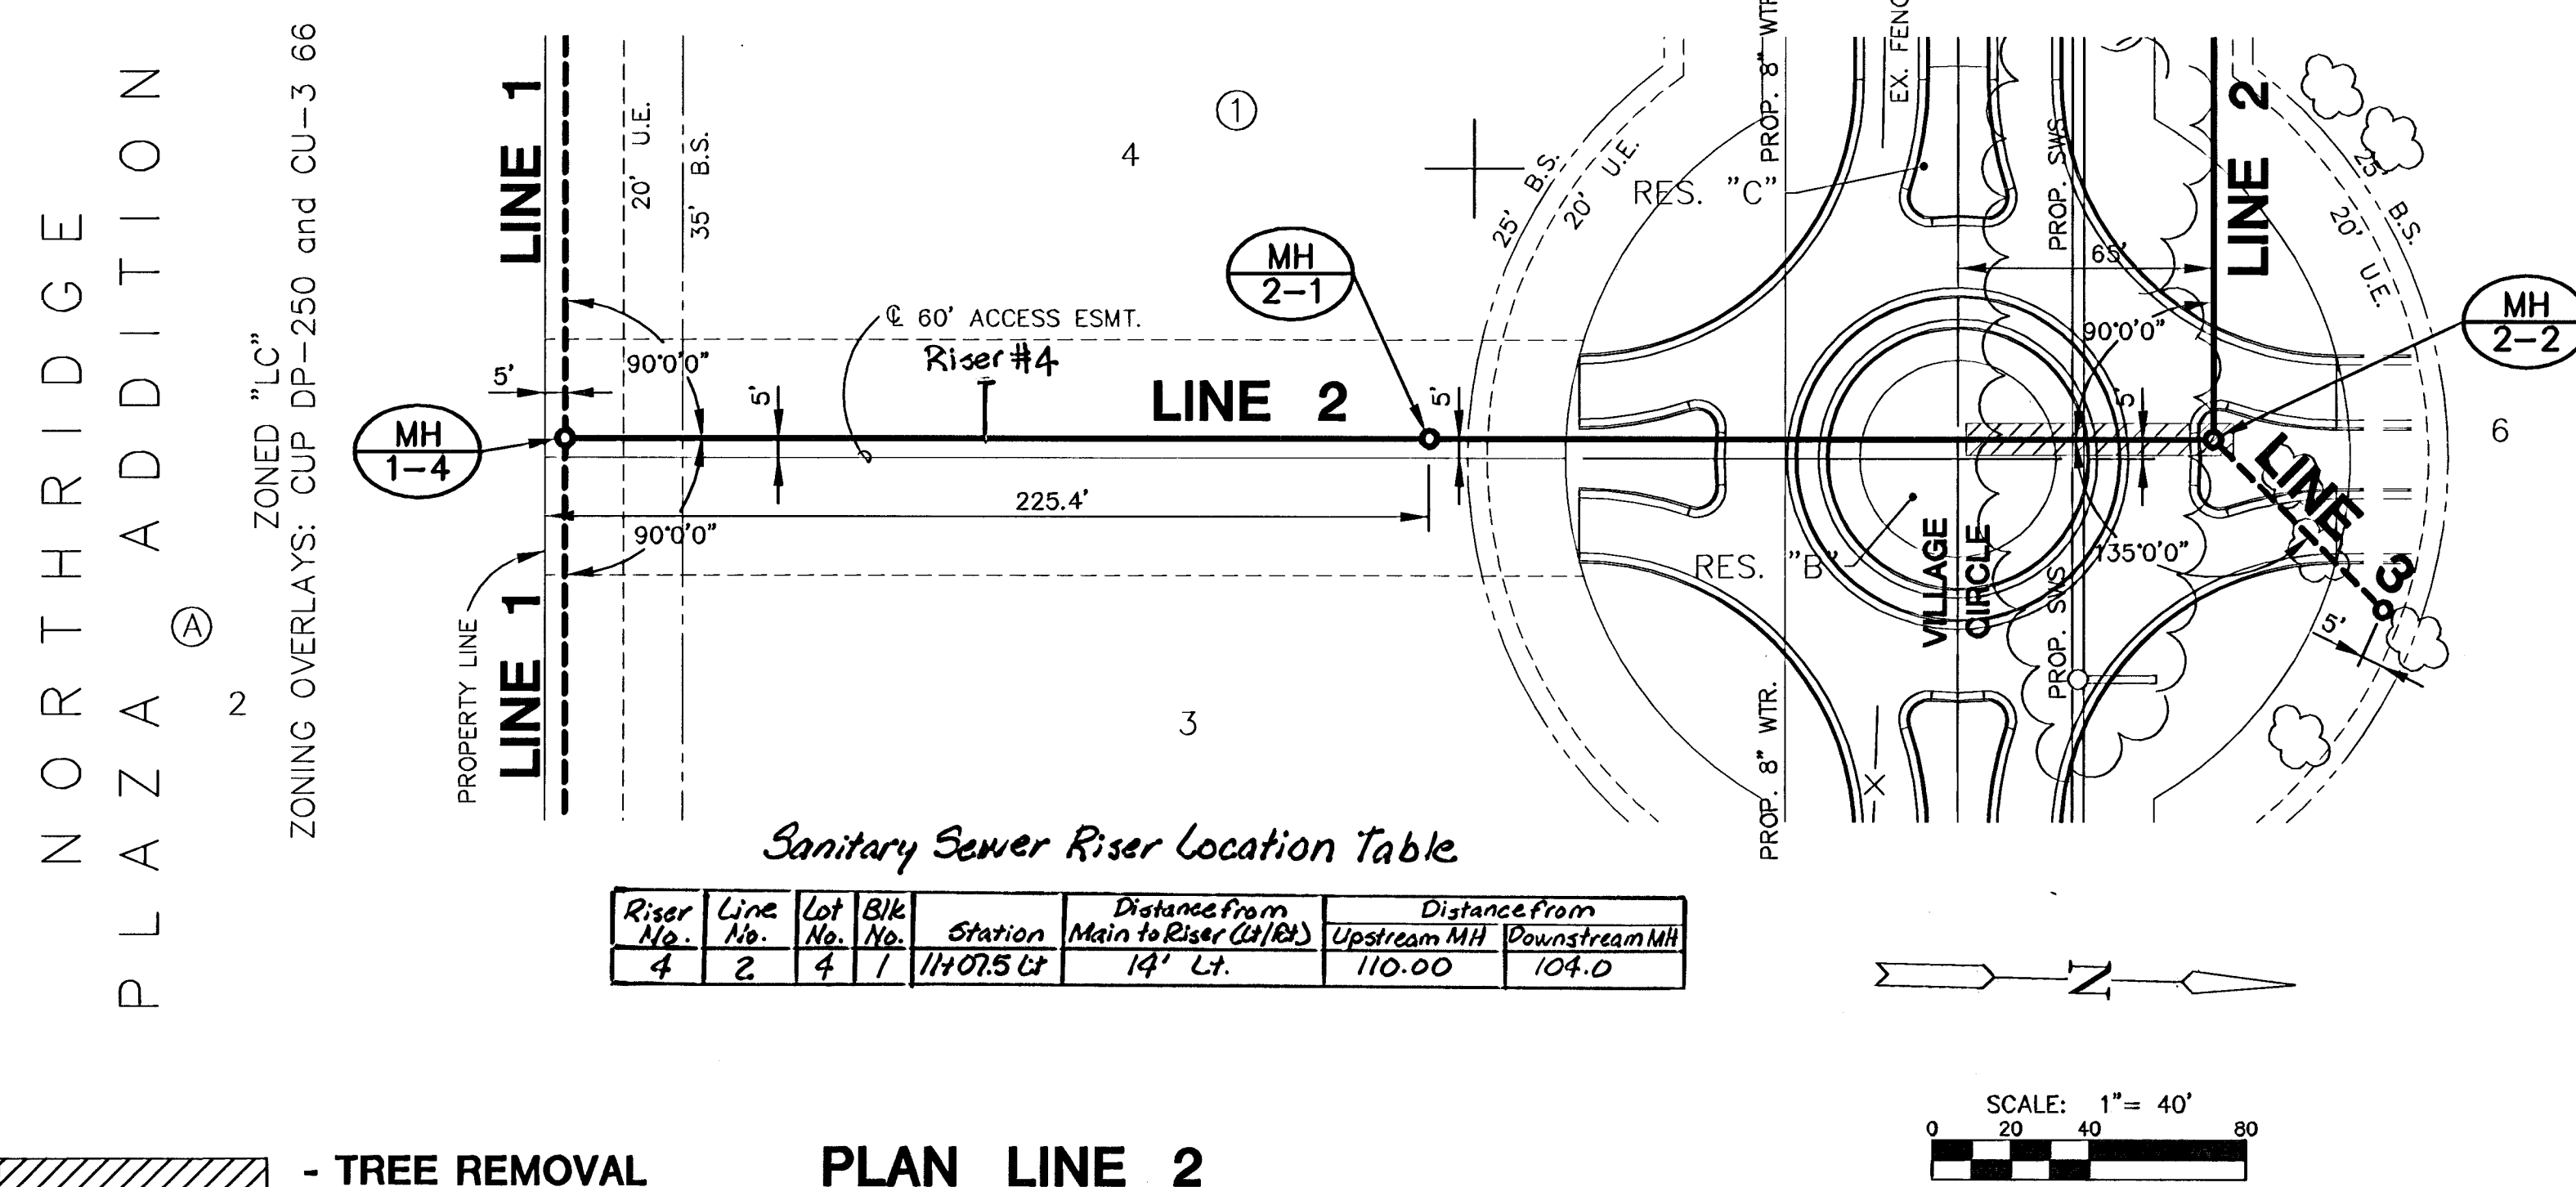



N O T H R I D G E P L A Z A A D D I T I O N

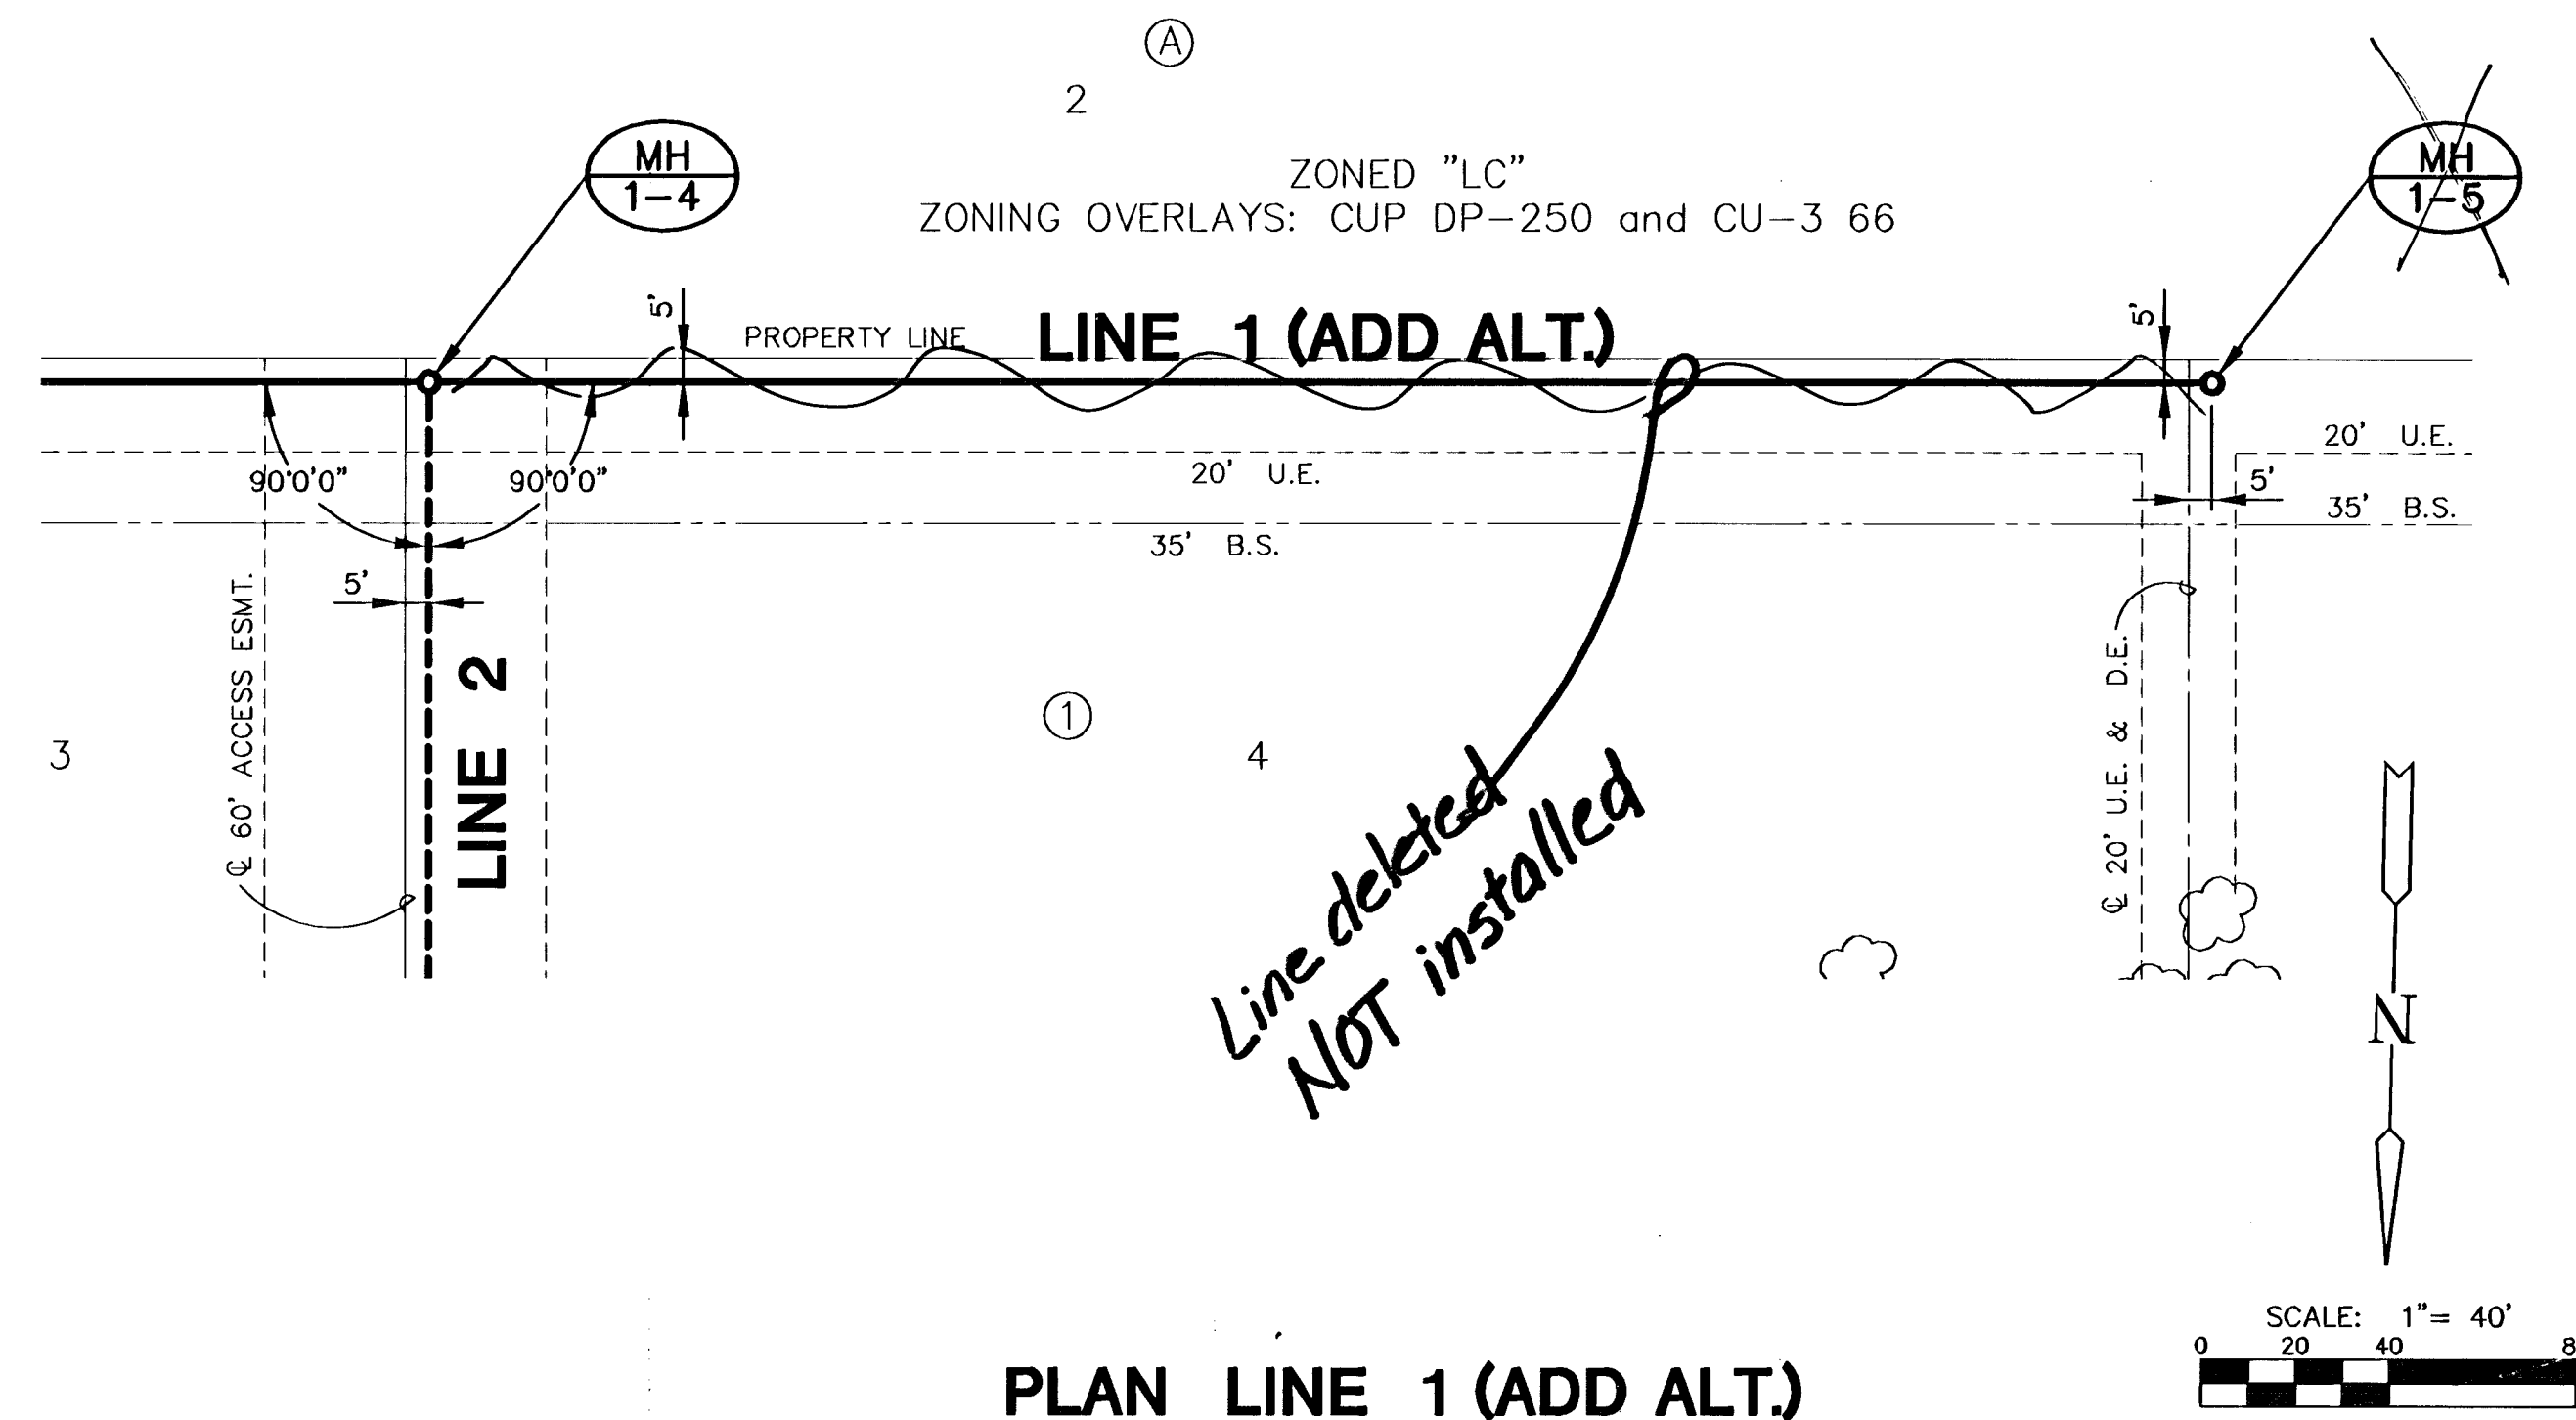

Sanitary Sewer Riser Location Table

Riser No.	Line No.	Lot No.	Blk No.	Station	Distance from Main to Riser (ft)	Distance from Upstream MH	Distance from Downstream MH
4	2	4	1	11+07.5 Lt	19' Lt	110.00	104.0

PROFILE LINE 1 (ADD ALT.)

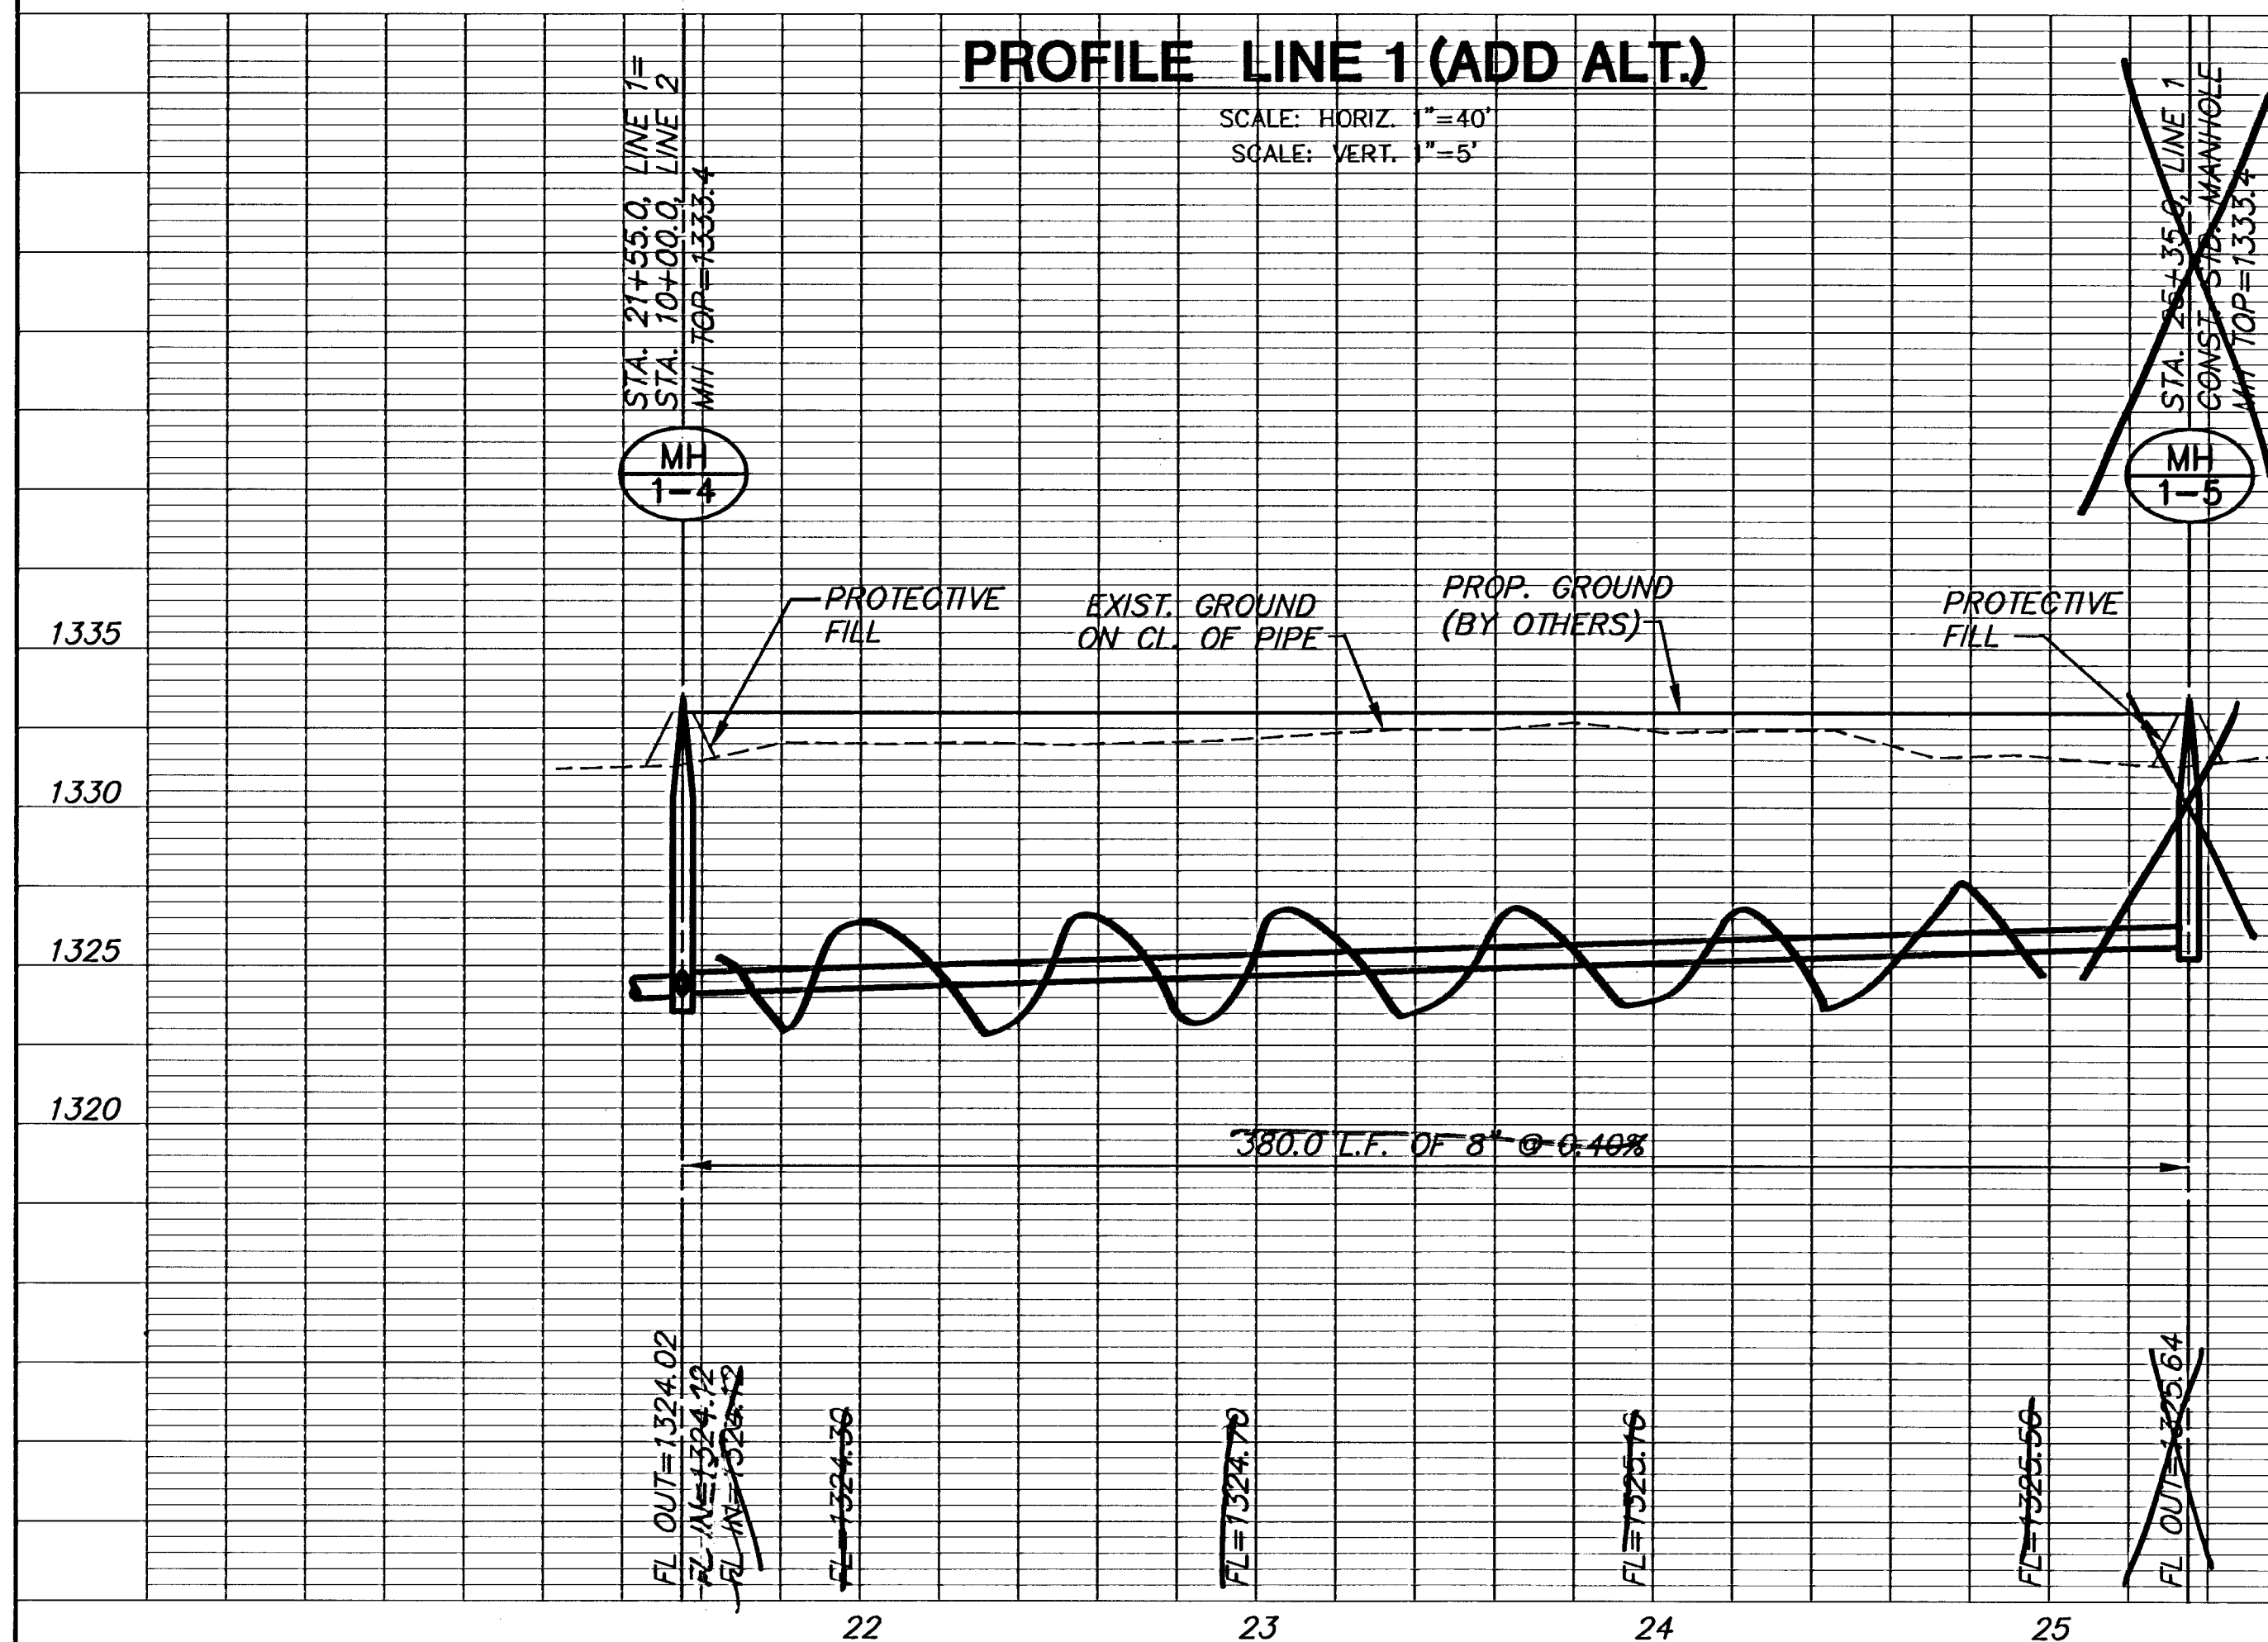

PROFILE LINE 2

