
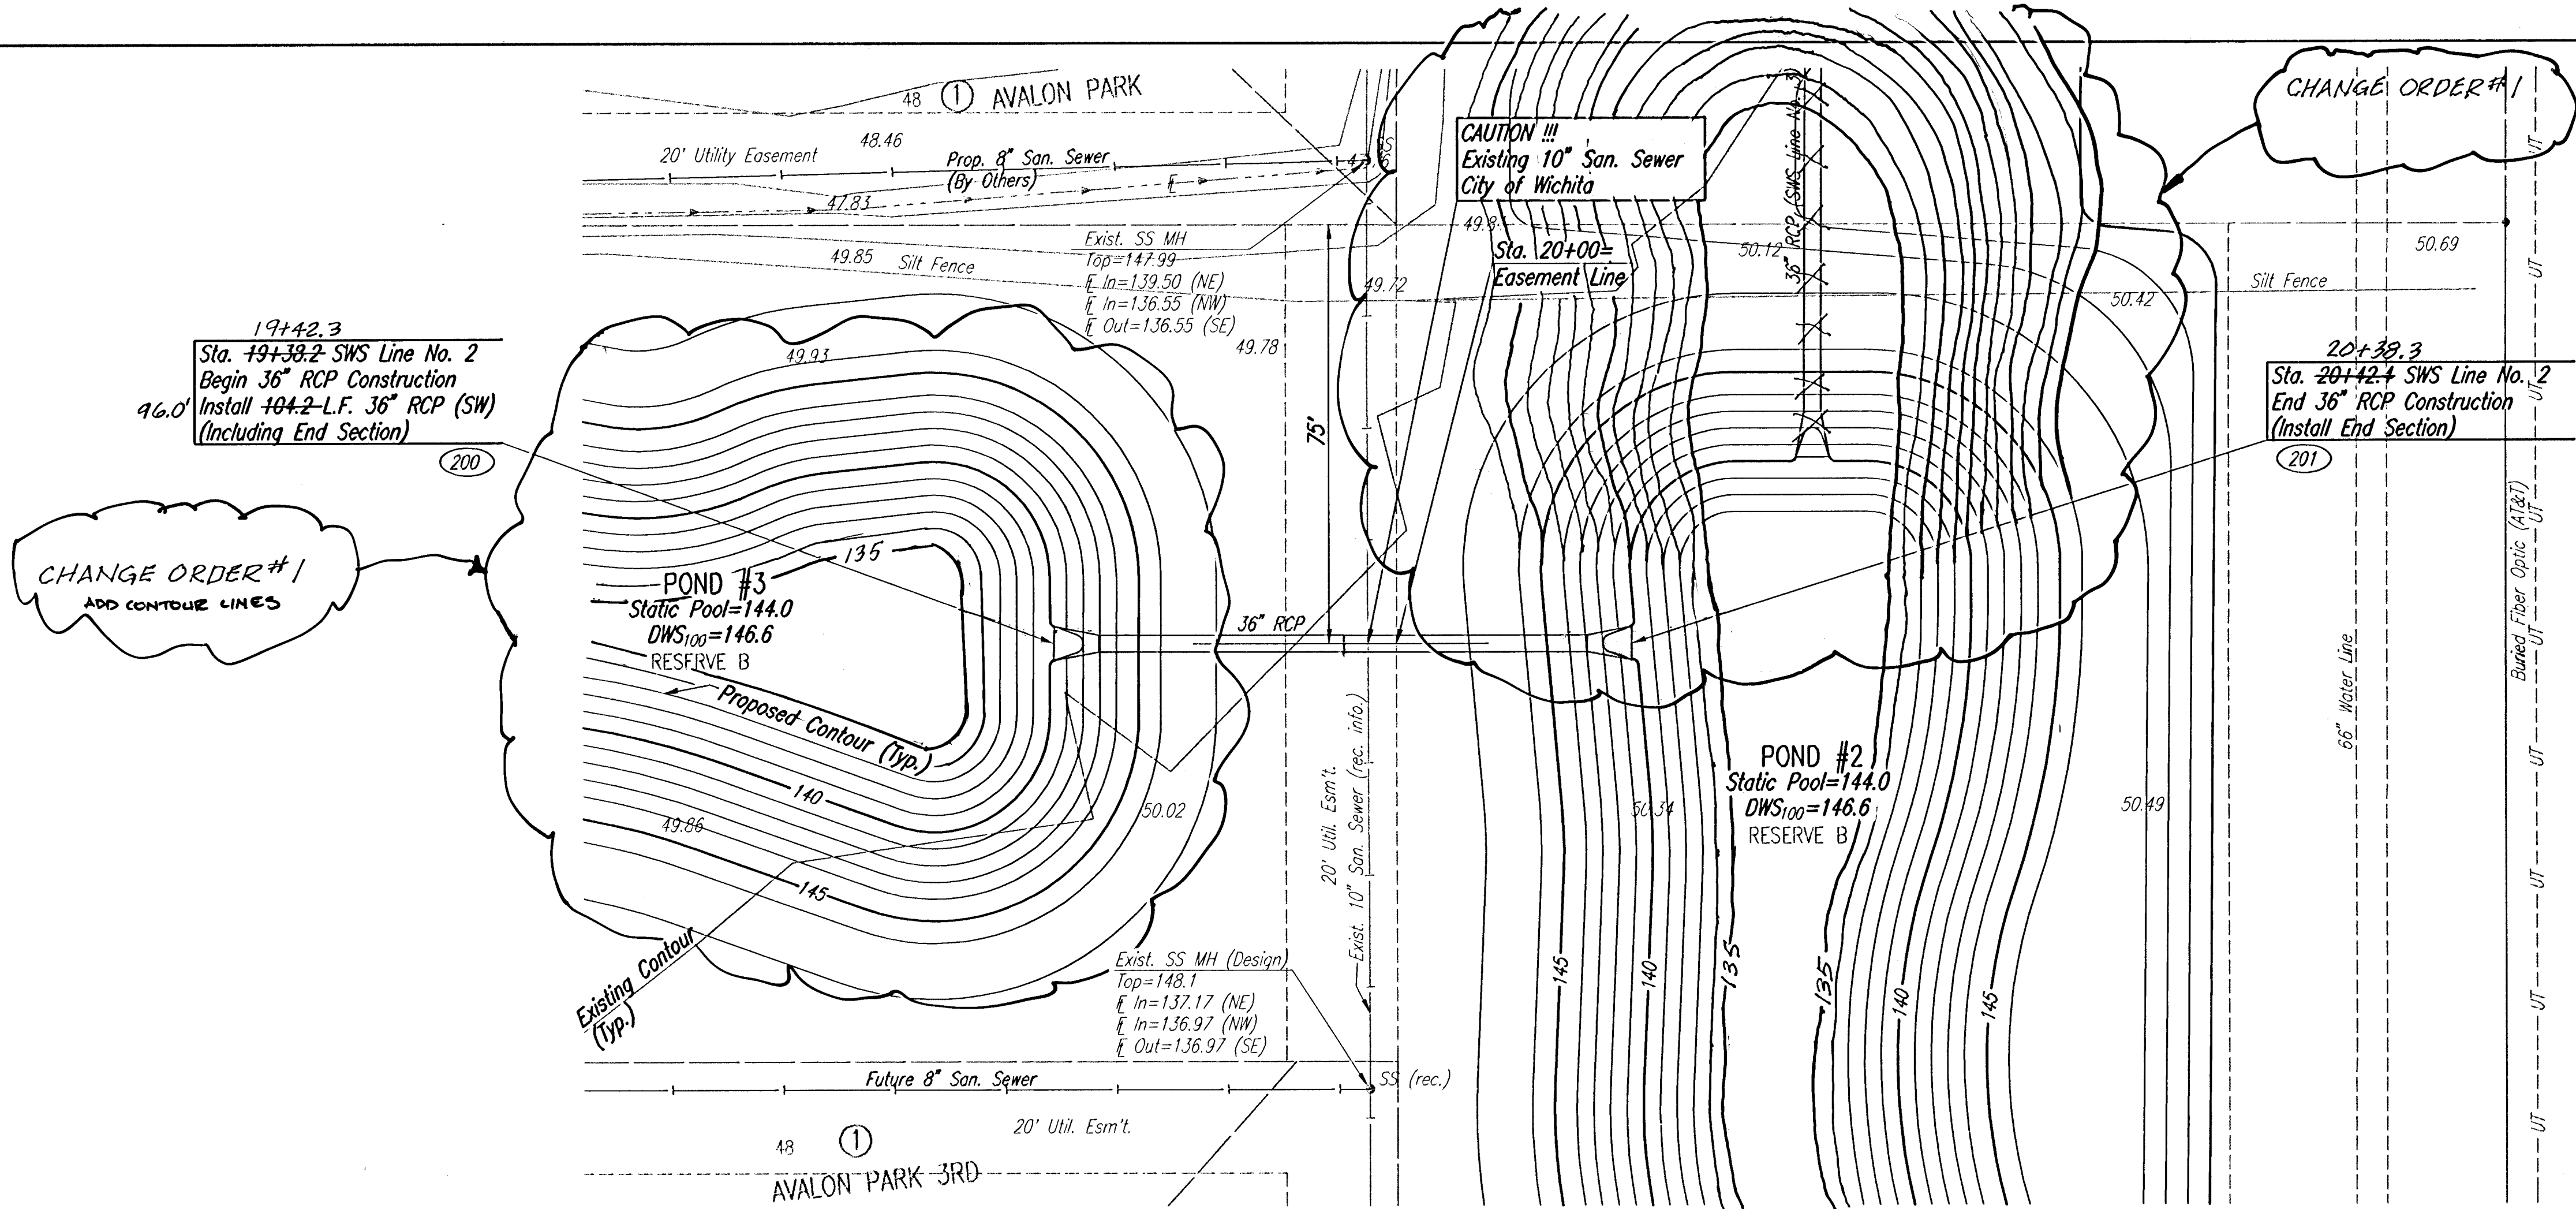


PLAN	CHECKED	CHECKED	BY	DATE

PROFILE	CHECKED	CHECKED	BY	DATE

DSNR: BLB OPER: BUS SCALE: 1"=20.00
 Q:\2005\05258\05258-C-SWS\LINE2 06-16-2005 10:53:17 am

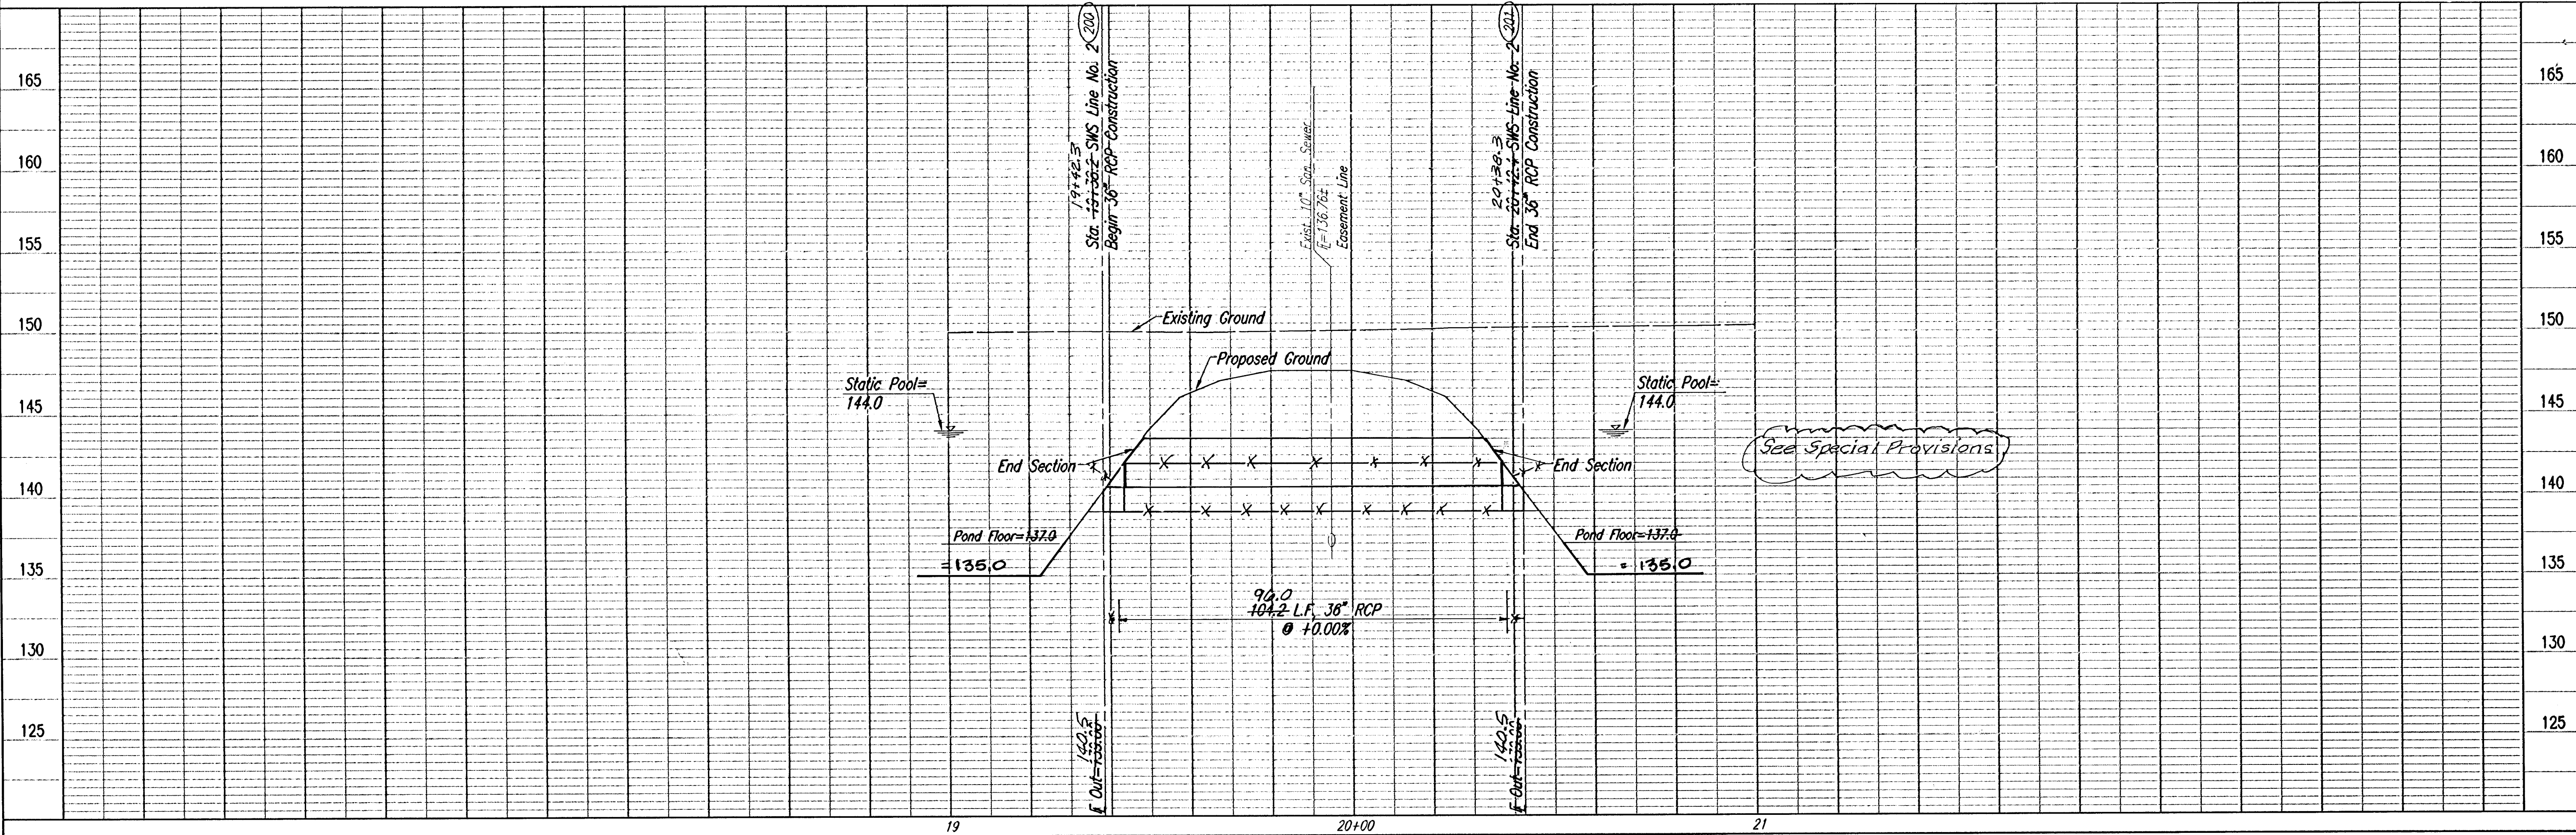


COORDINATE LIST		
POINT	NORTH	EAST
200	+11,240.0052	+10,965.3770
201	+11,173.9878	+10,884.8244

(200) = COORDINATE POINT NO.
 SEE SHEET NO. 3 FOR PLAT COORDINATES

See Special Provisions

RECORD DRAWING

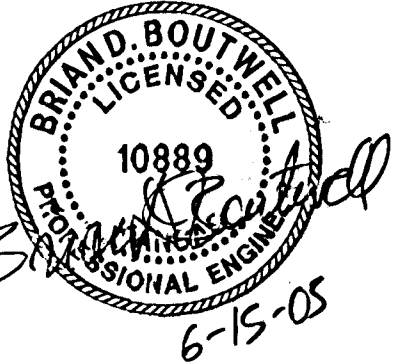

Professional Engineering Consultants, P.A.
 303 S. JORCKA • WICHITA, KANSAS 67202
 316-262-2691 • FAX 316-262-3003

Designed By: BDB, BLB
 Drawn By: BUS

Job No. 35-05258
 Date February 2005

AVALON PARK 3RD
 STORM WATER DRAIN NO. 265
 SWS LINE NO. 2

JAMES L. ARMOUR, P.E. - CITY ENGINEER
 CITY OF WICHITA PROJECT NO. 488-8402