
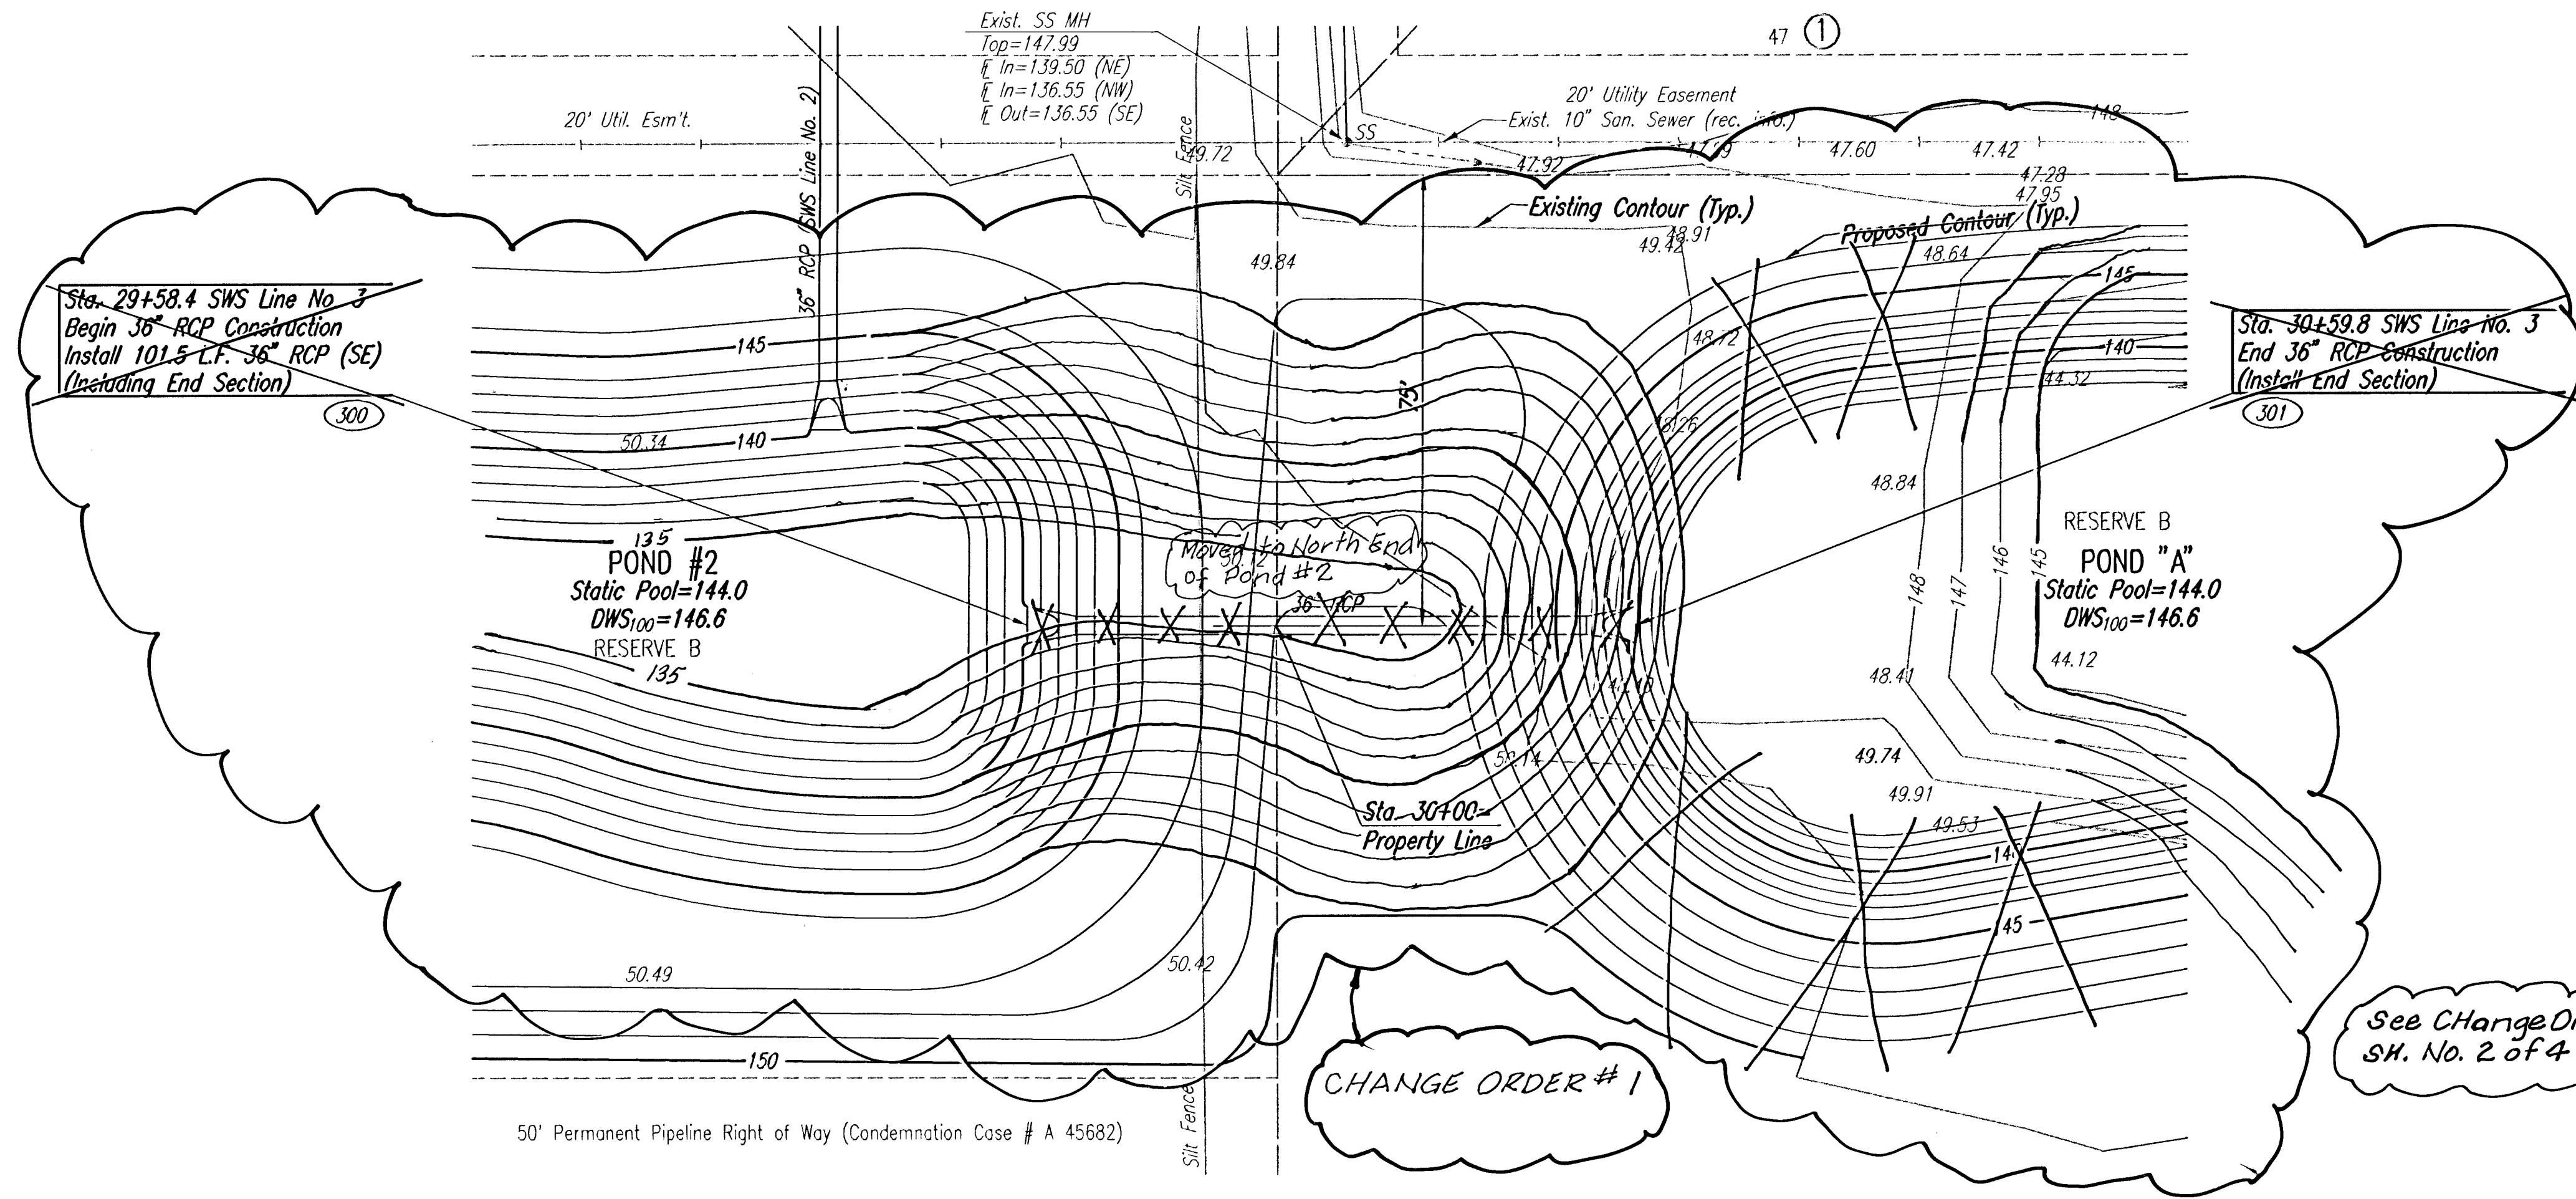


PLAN	CHECKED	CHECKED	BY	DATE

PROFILE	CHECKED	CHECKED	BY	DATE

DSNR: BLB OPER: BUS SCALE: 1"=20.00
Q:\2005\05258\05258-C-SWSLINE3 06-16-2005 10:54:03 am

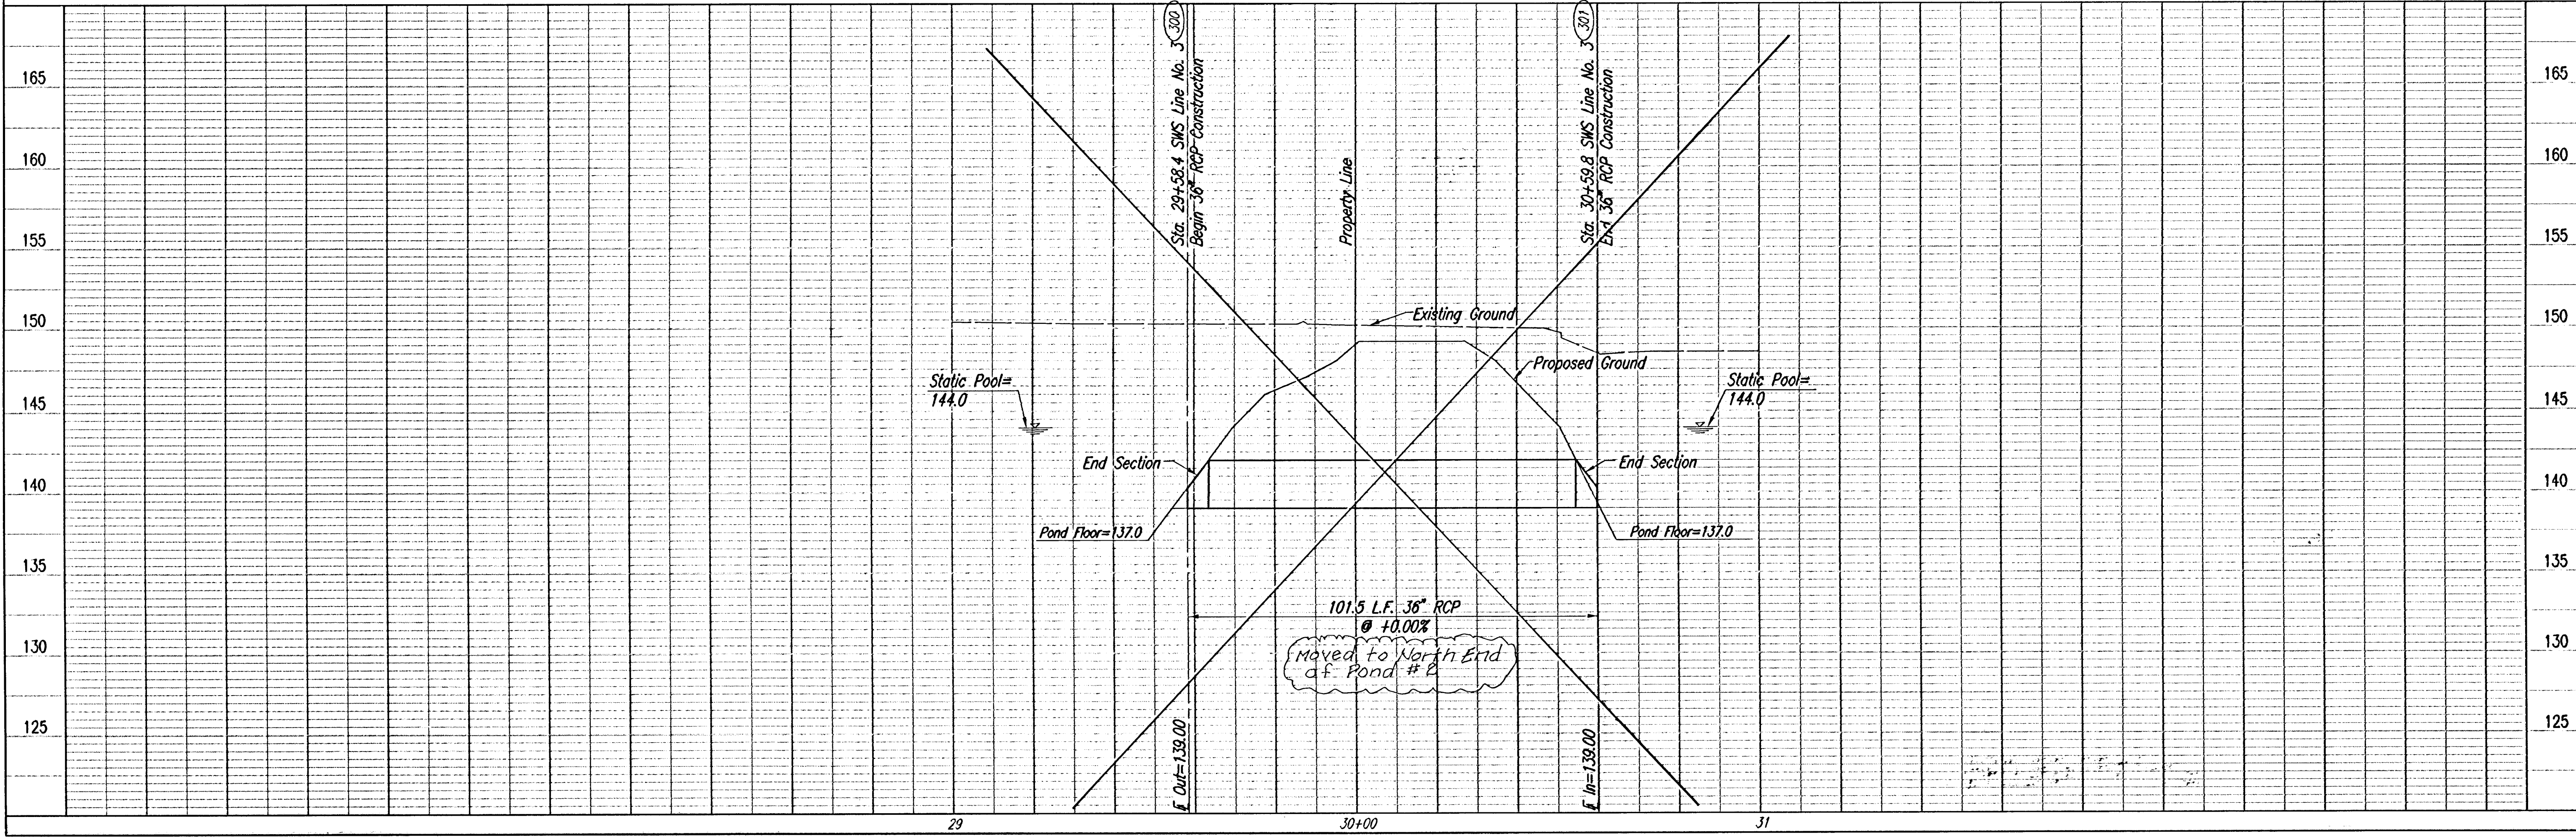

SCALE: 1"=20'

COORDINATE LIST		
POINT	NORTH	EAST
300	11,127.5271	10,880.7774
301	11,049.0691	10,945.1556

(300) = COORDINATE POINT NO.
SEE SHEET NO. 3 FOR PLAT COORDINATES

RECORD DRAWING
B. M. E. W. 06 OCT 06
BRAND BOUTWELL
10889
PROFESSIONAL ENGINEER
6-15-05

Professional Engineering Consultants, P.A.
303 S. TOPKAY • WICHITA, KANSAS 67202
316-262-2691 • FAX 316-262-3003

Designed By: BDB, BLB
Drawn By: BUS

Job No.: 35-05258
Date: February 2005

AVOLON PARK JRD
STORM WATER DRAIN NO. 265
SWS LINE NO. 3
JAMES L. ARMOUR, P.E.-CITY ENGINEER
CITY OF WICHITA PROJECT NO. 483-84012