

ED. BOTTOM OF POND
100
GE ORDER #1

3+00.00

2+50.00

2+00.00

1+50.00


1+00.00

0+50.00

0+00.00

B. H. Smith
RECORD DRAWING

10' VERT.
10' HORIZ.

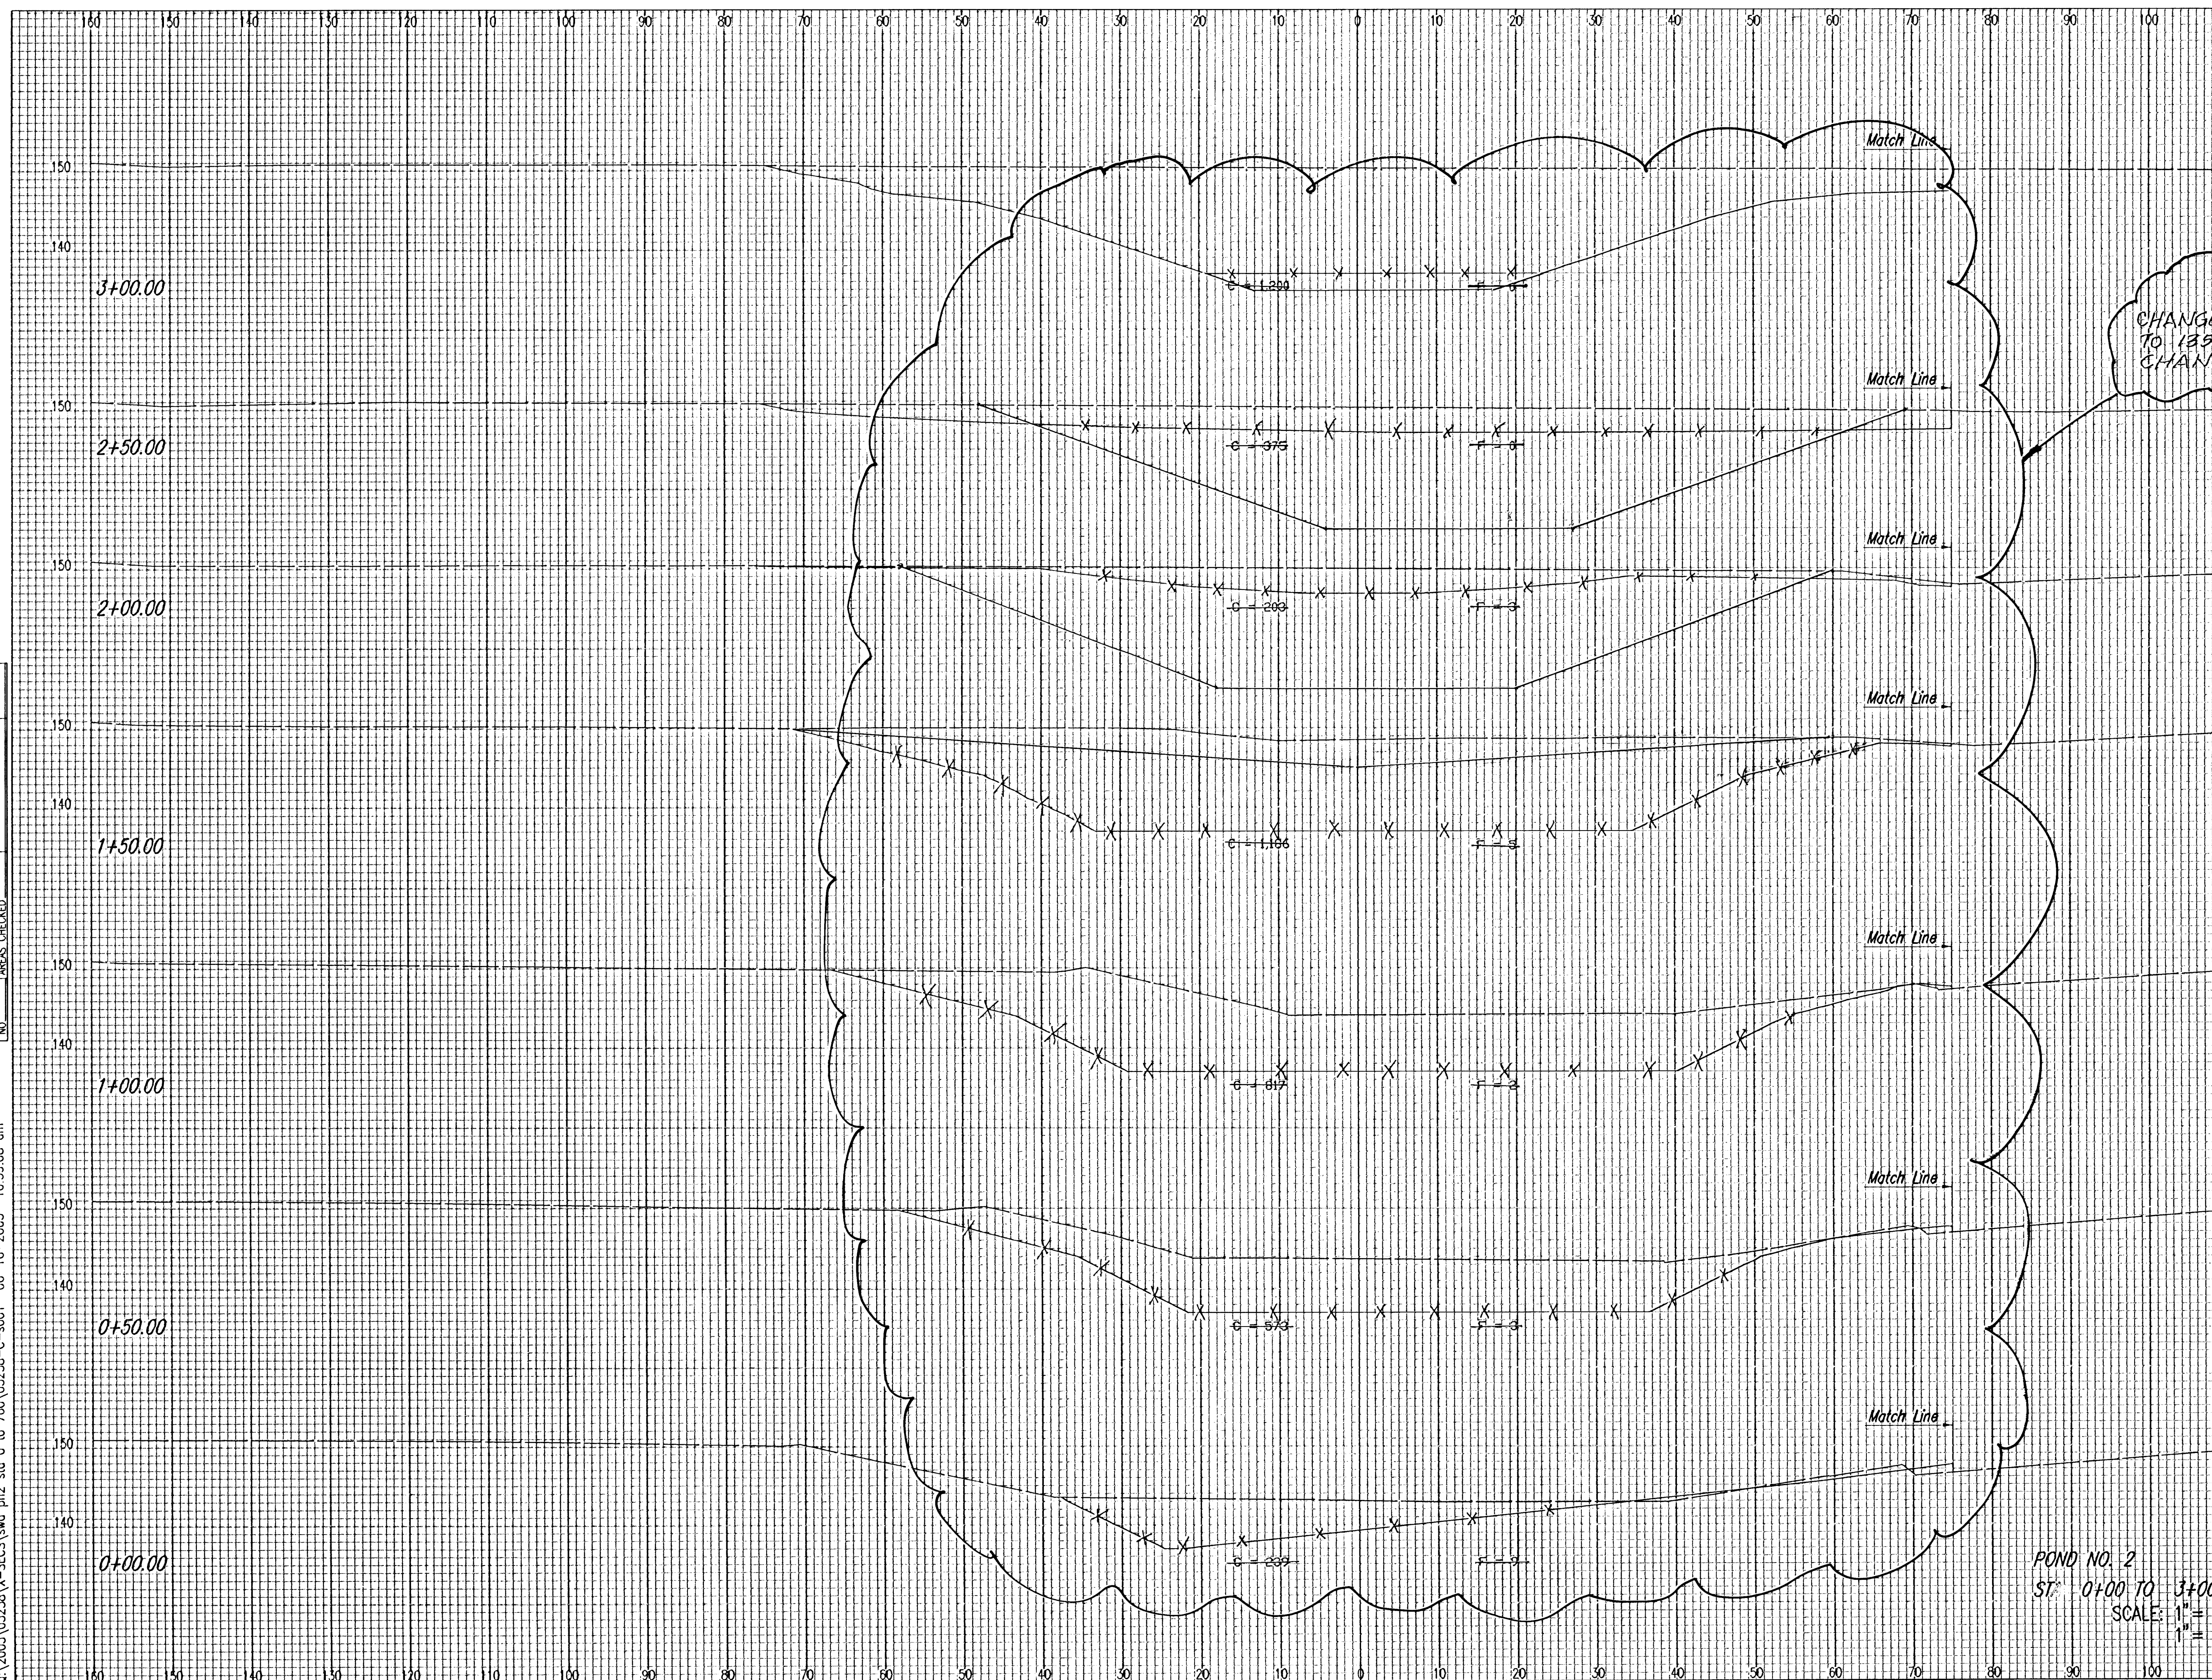

CHANGED BOTTOM OF POND
TO 13500
CHANGE ORDER #1


 OF CLERK
RECORD DRAWING

POND NO. 2
ST. 0+00 TO 3+00
SCALE: 1" = 10' VERT.
1" = 10' HORIZ.

NOTE BOOK	TEMPLATE		
	AREAS		
NO.	AREAS CHECKED		

DSNR: BLB OPER: BUS SCALE: 1=1.00
Q: 2005\05258\X-SECS\swd ph2 sta 0 to 760\05258-C-s001 06-16-2005 10:59:08 am